CONTINUED ON DRAWING 25\E\1065-001
2000-F25-SLD-EL-10010

3F 1 — 415V 3 PHASE 50Hz 3150A FORM 3 FAULT LEVEL 50kA FOR 1 sec.

3000/5 3 — AFS — V 0-500V — A 0-3000A — S — kW mA 4-20mA — TO PROCESS CONTROL CUBICLE — 2A/20A S — 415/110V — 2A — VAMP 221 ARC FLASH RELAY — NOTE 1 — INTEGRAL C.B. 3150A — I> I> I> INST — NEUTRAL — EARTH — I> — 200/5 — ROGOWSKI COILS

25-CP-83
MAIN C/B & RECLOSER REMOTE ISOLATION
DWG. 25\E\1086-019

25-TR-31
33kV/415V
2000 kVA
Dyn11

HV EARTH — SUBSTATION MV EARTH BAR — EARTH GRID

4F 1 — 200A 200A — DIST. BOARD 36A
4V NORMAL DB 36A
DISTRIBUTION BOARD
REF. DWG. 25\E\1068-001

4F 2 — 200A 200A — FEED TO FORM 1 & EMERGENCY SECTIONS J & H

4F 3 — 250A 250A — 25-CM-31B
FLOTATION AREA 2
COMPRESSOR

4F 4 — 63A 63A — CA7-43 — CEP7 16-25 — M — 11 kW — 30-PS-33
FLOTATION TAILS
WASHDOWN PUMP
REF. DWG. 25\E\1074-004

4F 5 — SPACE

5F 1 — 415V 3 PHASE 50Hz 200A FORM 3 EMERGENCY SUPPLY BUSBAR FAULT LEVEL 18kA FOR 1 sec. — 200A — M — M — 200A — 4I5V EMERGENCY SUPPLY
FROM SUB STATION No.7 80-SW-01
CB 25-SW-31 GENSET 80-GE-61
REF. DWG. 80\E\1132

5F 2 — 16A 32A — 415/110V — A N — L1(E) N1(E) — 110V CONTROL TRANSFORMER
REF. DWG. 25\E\1074-001

5F 3 — 25A 32A — BYPASS TRANSFORMER — 25-XE-62 — 25-DB-62 — TO 25-DB-62
REF. DWG.

DB No.1 — TO DB No.1
REF. DWG. 25\E\1070-001

5F 4 — 25A 32A — BYPASS TRANSFORMER — 25-XE-63 — DB No.2 — 25-XE-63
BYPASS TRANSFORMER - UPS 2
REF. DWG. 25\E\1070-002

5F 5 — 16A 32A — TO DB No.2
REF. DWG.

25-PC-01
SUB 6 FEEDER B

4I5V FEED FROM
TEIR 5F

TO SOUTH SWITCHYARD (D2)
#8 - 3H RECLOSER
REF. DWG. 180\E\3045

BUS TIE INTERLOCK
FROM BUS TIE 3250A ISOLATOR
REF. DWG. 25\E\1065-001

33kV 3Ph SUPPLY
FROM SOUTH SWITCHYARD (D2)
#8 - 3H RECLOSER
REF. DWG. 180\E\3045

12

4R 3 — 25A — 415V 3 PHASE 50Hz 200A FORM 1 FAULT LEVEL 18kA FOR 1 sec. — SPARE

4R 4 — SPACE

4R 5 — SPACE

4R 6 — SPACE

4R 7 — SPACE

4R 8 — SPACE

4R 9 — SPACE

4R 10 — SPACE

4R 11 — SPACE

4R 12 — SPACE

CONTINUED ON DRAWING 25\E\1065-001
2000-F25-SLD-EL-10010

5R 1 — 415V 3 PHASE 50Hz 200A FORM 3 EMERGENCY SUPPLY BUSBAR FAULT LEVEL 18kA FOR 1 sec. — 100A 100A — 4I5V FEED FROM
TEIR 5F

5R 2 — 80A 80A — 3TF46 — 3UA58 32-50 — M — 22 kW — 30-TH-31
CONCENTRATE PRE-LEACH THICKENER
2000-F25-SCM-EL-10001

5R 3 — 80A 80A — BYPASS SWITCH — 25-XE-64
CONTROL ROOM UPS
REF. DWG. 25\E\1090-001

5R 4 — 80A 80A — BYPASS SWITCH — 25-XE-65
CONTROL ROOM UPS
REF. DWG. 25\E\1090-002

DIST. BOARD 36B
4I5V EMERGENCY DB 36B
DISTRIBUTION BOARD
REF. DWG. 25\E\1069-001

25-DB-12
240VAC CONTROL ROOM
DISTRIBUTION BOARD
REF. DWG. 25\E\1070-004

25-DB-13
240VAC CONTROL ROOM
DISTRIBUTION BOARD
REF. DWG. 25\E\1070-005

NORTHERN STAR

Approved	X
Approved as Noted	
Not Approved	
For Information Only	

Si [redacted]
C [redacted] /2025


ACCEPTANCE DOES NOT RELIEVE THE SUPPLIER / CONTRACTOR OF ITS RESPONSIBILITY OR LIABILITIES UNDER THE PURCHASE ORDER / CONTRACT

LEGEND

LOCATION

SUB STATION 6

25-SW-31

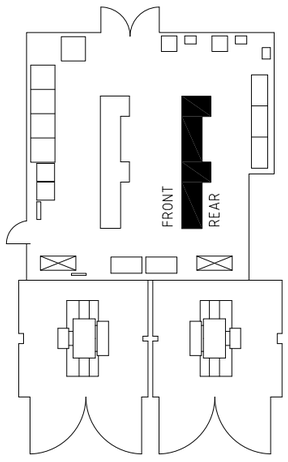

NOTES

1. ALL AFS (ARC FLASH SENSORS) ARE CONNECTED TO THE ARC FLASH RELAY VIA I/O UNITS

LEGEND
- EXISTING
- NON-EXISTENT
- STAGE 1 - NEW
- STAGE 1 - REMOVE
- STAGE 1 - DECOMMISSIONED (OTHERS)
- STAGE 2 - NEW
- STAGE 2 - REMOVE
- STAGE 2 - DECOMMISSIONED (OTHERS)

KCGM GROWTH PROJECT

DRAWING NO.
2000-F25-SLD-EL-10011

REV	DATE	DESCRIPTION	CHECK	TECH APP
0	10/11/25	APPROVED FOR CONSTRUCTION	[redacted]	DM

2000-F25-SLD-EL-10011_Rev0

25-SW-31 sub no. 6 415V MCC 25-SW-31 single line diagram