
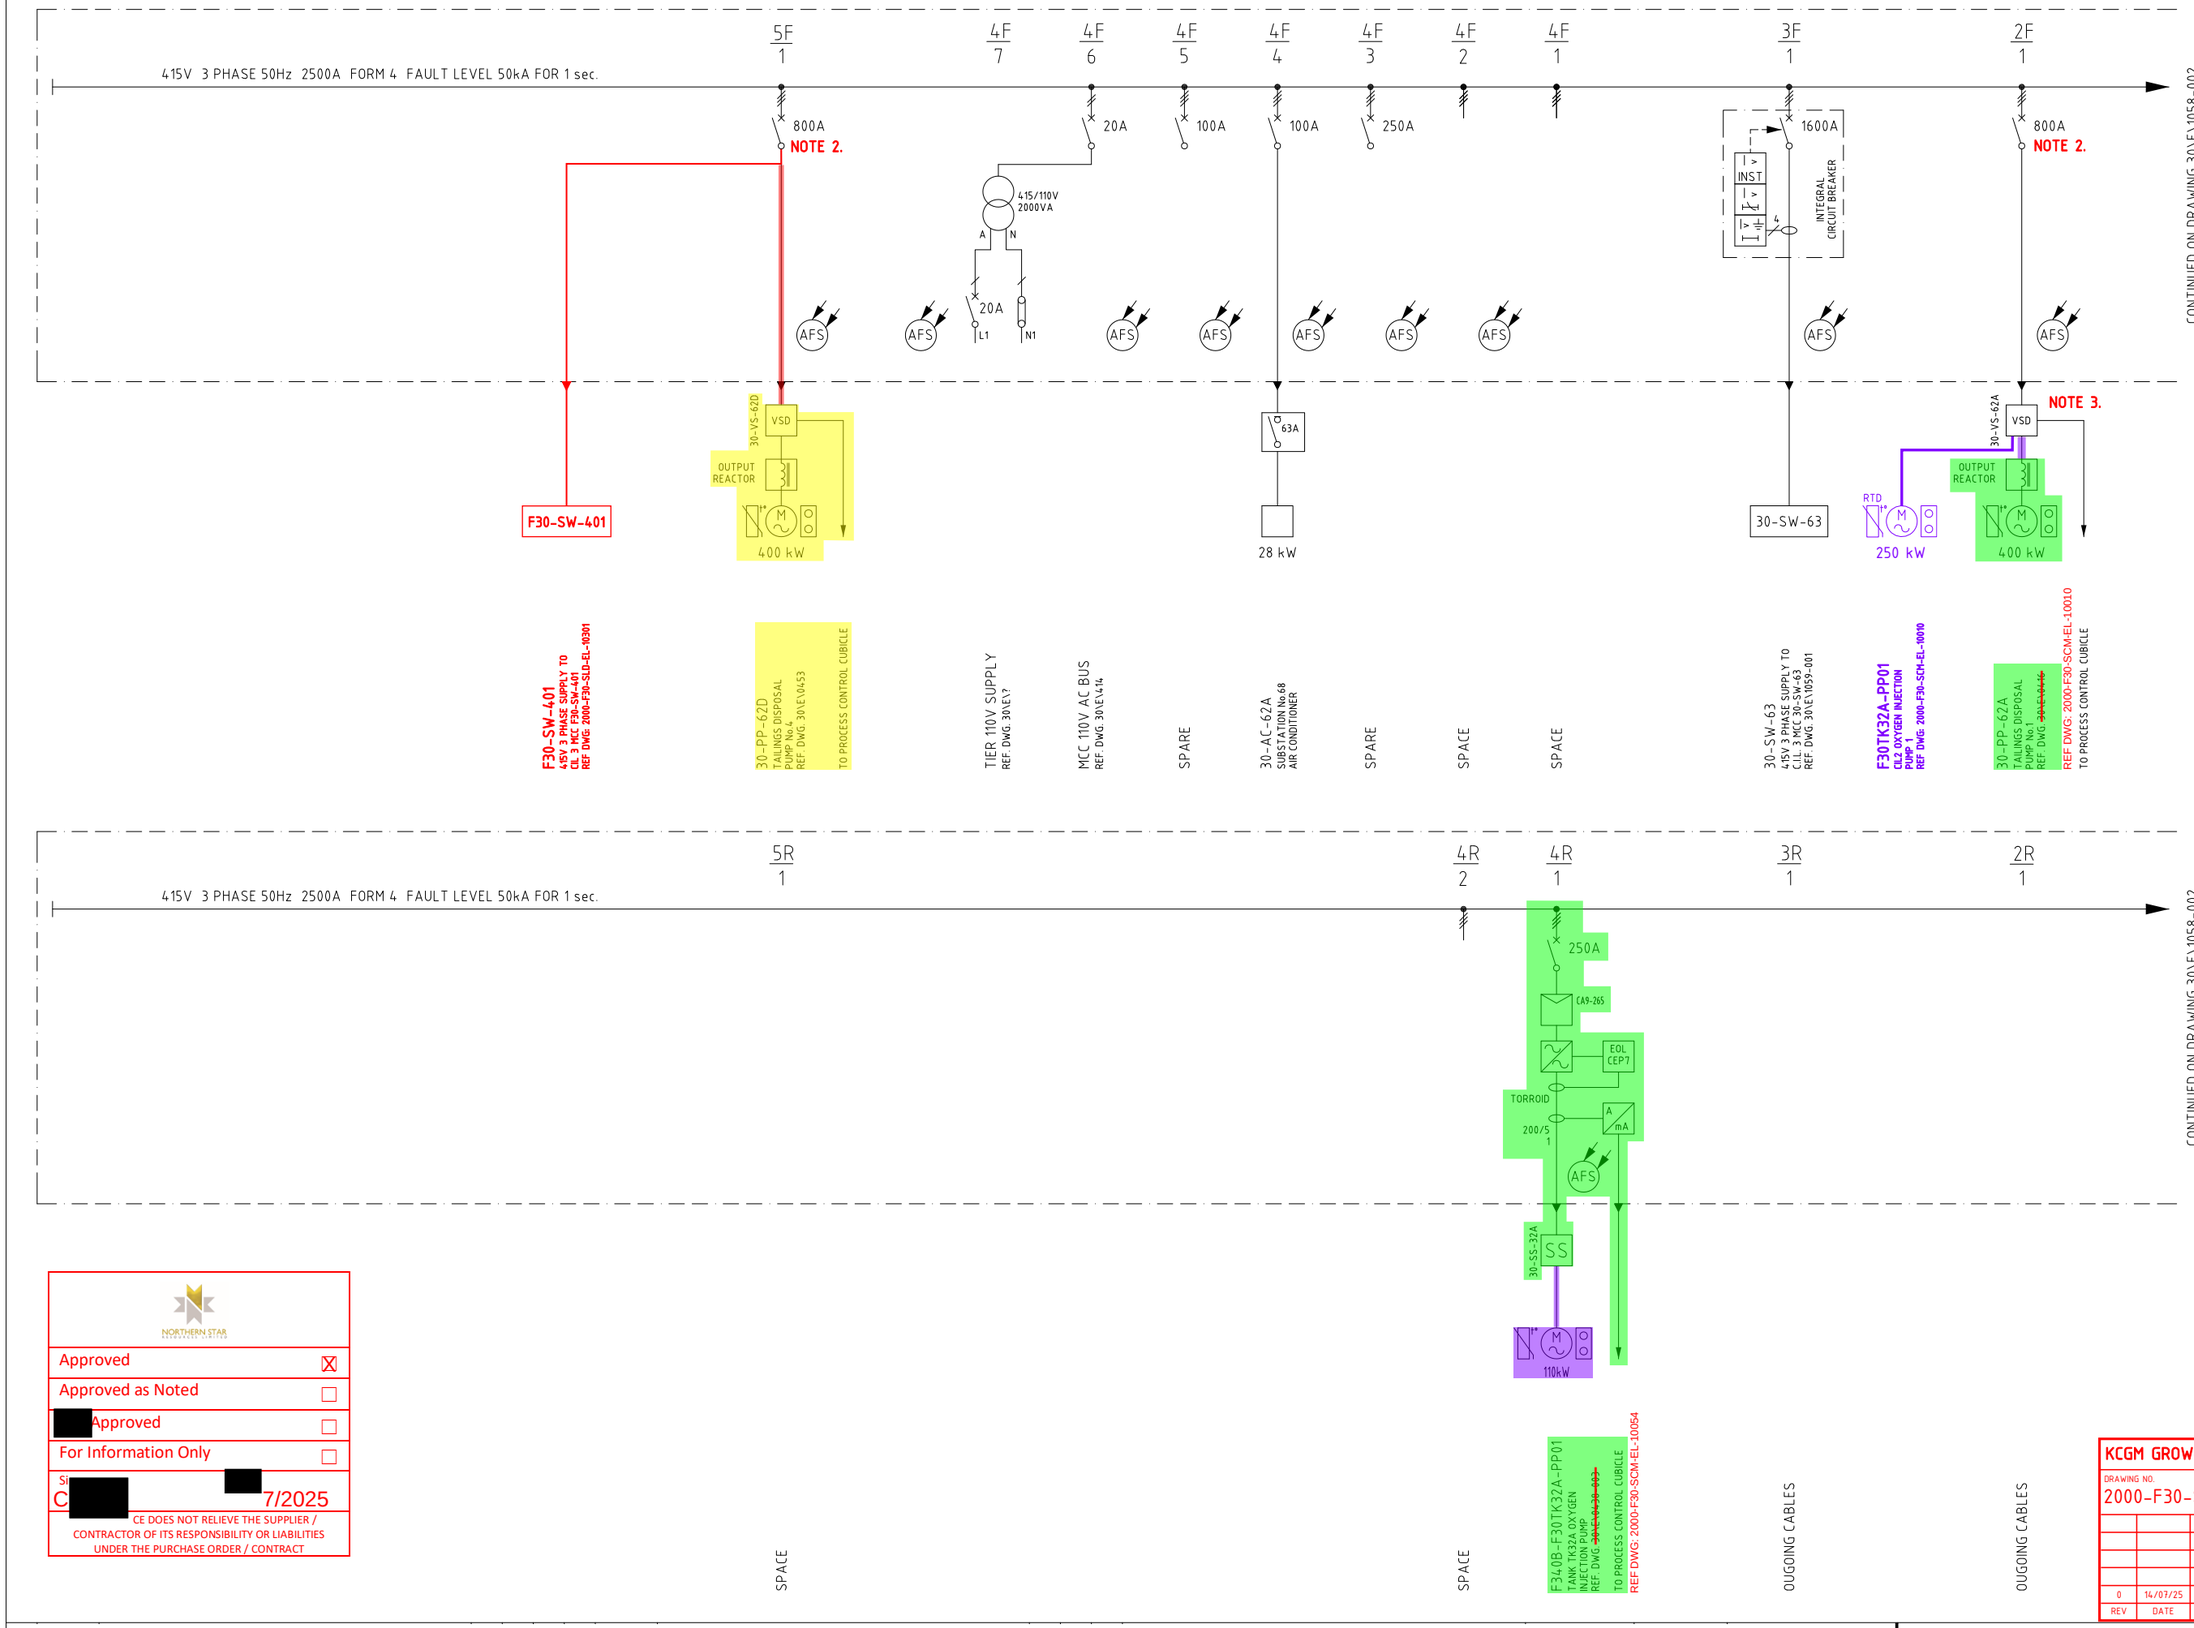


LEGEND

LOCATION

SUB STATION 68

30-SW-62

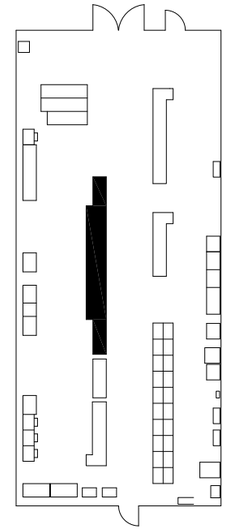

NOTES

1. ALL AFS (ARC FLASH SENSORS) ARE CONNECTED TO THE ARC FLASH RELAY VIA I/O UNITS
2. MCC FEEDER RE-PURPOSED AS PART OF THE KCGM GROWTH PROJECT.
3. VSD RE-PURPOSED AS PART OF THE KCGM GROWTH PROJECT.

LEGEND

- STAGE 1 - NEW
- STAGE 1 - REMOVE
- STAGE 1 - DECOMMISSIONED (OTHERS)
- STAGE 2 - NEW
- STAGE 2 - REMOVE
- STAGE 2 - DECOMMISSIONED (OTHERS)

NORTHERN STAR

Approved	[X]
Approved as Noted	[ ]
[redacted] Approved	[ ]
For Information Only	[ ]

S[redacted]

C[redacted] [redacted] 7/2025

CE DOES NOT RELIEVE THE SUPPLIER / CONTRACTOR OF ITS RESPONSIBILITY OR LIABILITIES UNDER THE PURCHASE ORDER / CONTRACT

KCGM GROWTH PROJECT

DRAWING NO.
2000-F30-SLD-EL-10101

REV	DATE	DESCRIPTION	CHECK	TECH APP
			DF	MB/SAK
0	14/07/25	APPROVED FOR CONSTRUCTION	[redacted]	MB/DM

2000-F30-SLD-EL-10101_Rev0

Carbon in leach (CIL3) substation no. 68 MCC 30-SW-62 single line diagram