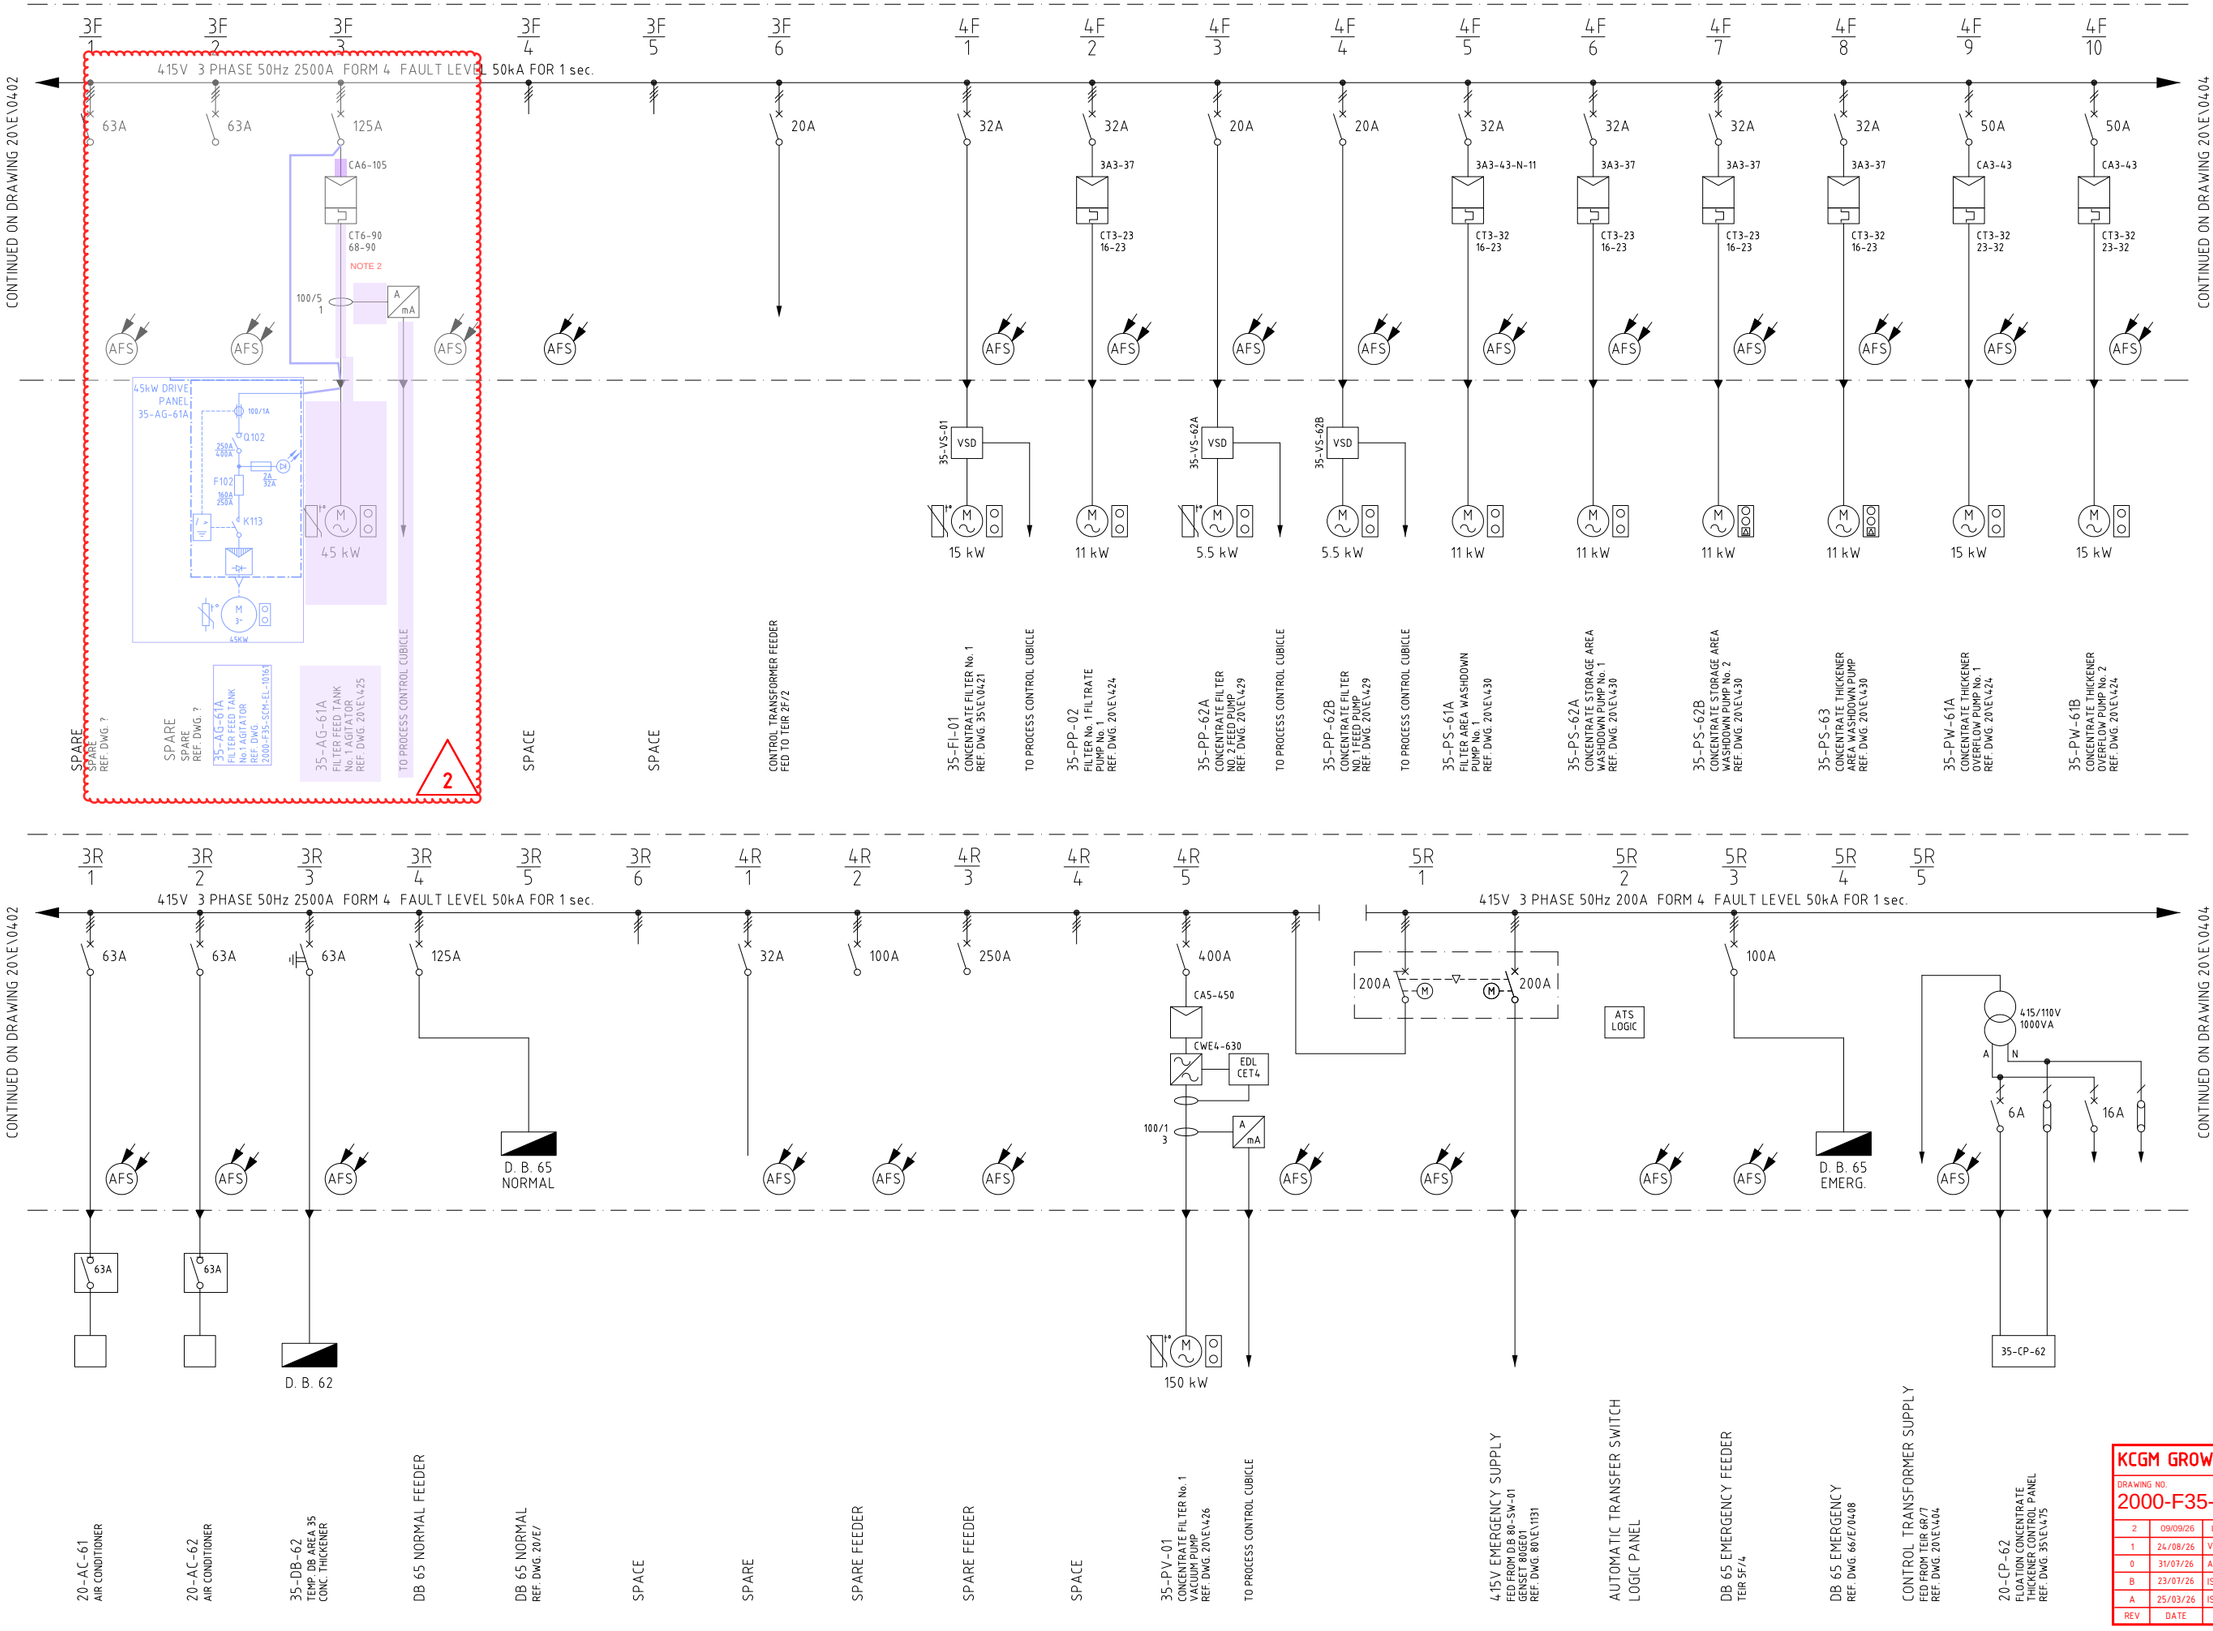


LEGEND

NORTHERN STAR RESOURCES LIMITED

Approved	☒
Approved as Noted	☐
Not Approved	☐
For Information Only	☐


Signed *A. Vuckovic* Date *30/09/26*

ACCEPTANCE DOES NOT RELIEVE THE SUPPLIER / CONTRACTOR OF ITS RESPONSIBILITY OR LIABILITIES UNDER THE PURCHASE ORDER / CONTRACT

LOCATION

SUB STATION 35

20-SW-62

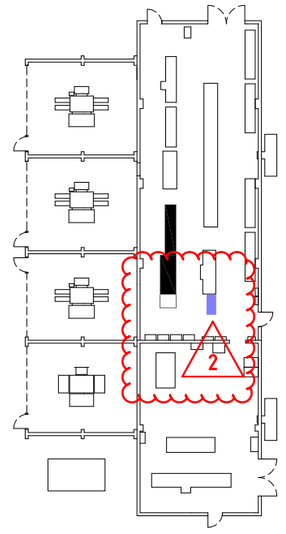

NOTES

1. ALL AFS (ARC FLASH SENSORS) ARE CONNECTED TO THE ARC FLASH RELAY VIA I/O UNITS

2. EXISTING CONTACTOR, OVERLOAD, CT, AMMETER CIRCUIT, AND ASSOCIATED CONTROL WIRING TO BE DISCONNECTED AND RETAINED IN BUCKET.

LEGEND

- EXISTING
- NON-EXISTENT
- STAGE 1 - NEW
- STAGE 1 - REMOVE
- STAGE 1 - DECOMMISSIONED (OTHERS)
- STAGE 2 - NEW
- STAGE 2 - REMOVE
- STAGE 2 - DECOMMISSIONED (OTHERS)

KCGM GROWTH PROJECT

DRAWING NO.
2000-F35-SLD-EL-10101

GPD MB DM

REV	DATE	DESCRIPTION	CHECK	APP
2	09/09/26	LAYOUT REVISED	GD	MB DM
1	24/08/26	VSD RELOCATED NOTE 2 REVISED		
0	31/07/26	APPROVED FOR CONSTRUCTON		
B	23/07/26	ISSUED FOR CLIENT REVIEW		
A	25/03/26	ISSUED FOR INTERNAL REVIEW		

2000-F35-SLD-EL-10101_Rev2

Fimiston recycle crushing substation no. 35 415V MCC 20-SW-62
single line diagram sheet 2