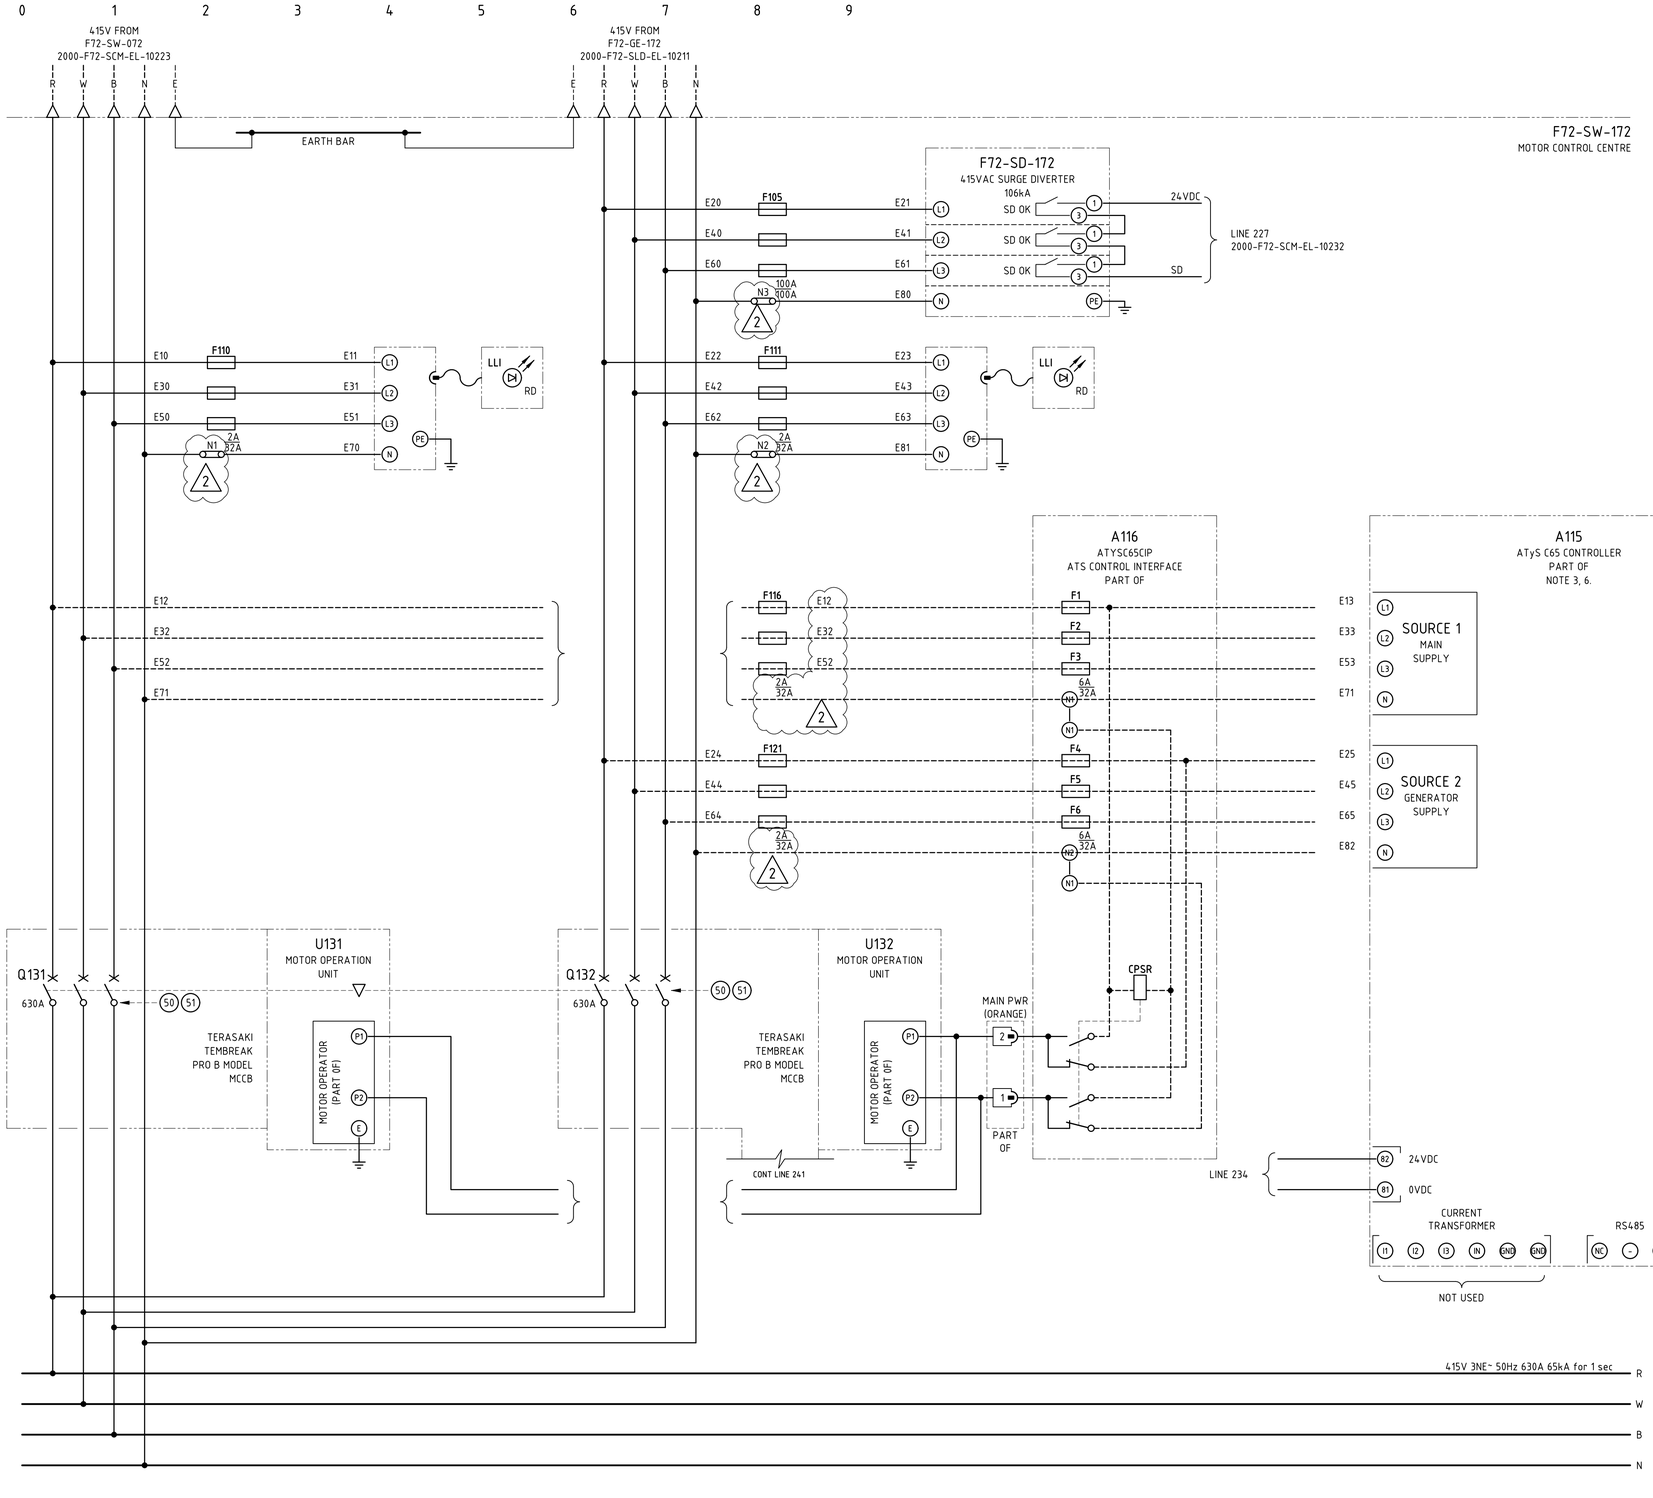


NOTES

1. SURGE DIVERTERS SHALL PROVIDE FEEDBACK TO DCS VIA VOLT-FREE CONTACTS. SURGE DIVERTER FUSES SHALL BE SIZED BY VENDOR TO SUIT DUTY.
2. MINIATURE CIRCUIT BREAKERS SHALL BE SIZED AND RATED TO SUIT ACB AND INCOMER REQUIREMENTS.
3. ALL TERMINATIONS ABOVE 50VAC SHALL BE TO IP2x OR ABOVE, IF NOT, TO HAVE A SEPARATE PERSPEX SHROUD FITTED AND SHALL BE LABELLED "DANGER xxxVAC".
4. WIRE NUMBER FERRULES ON TERMINAL STRIP SHALL BE PREFIXED WITH EQUIPMENT NUMBER e.g. F72SW172-0600 UNLESS NOTED OTHERWISE.
5. EACH WIRE SHALL BE IDENTIFIED AT BOTH ENDS WITH FERRULES.
6. ATS TO BE CONFIGURED SUCH THAT LOSS OF MAINS POWER SHALL START GENERATOR AND TRANSFER SUPPLY SOURCE. UPON DETECTION OF MAINS POWER ATS SHALL AUTO TRANSFER TO MAINS AND SHUTDOWN GENERATOR WITH A NOMINAL DELAY OF 5 MINUTES.

LEGEND

- 00/01/00 — DCS DIGITAL INPUT
- 00/02/00 — DCS DIGITAL OUTPUT
- MCC TERMINAL
- VSD TERMINAL
- FIELD TERMINAL
- DCS OR I/O TERMINAL
- MARSHALLING TERMINAL
- DEVICE TERMINAL
- INDICATION LAMP (cc = COLOUR)

DRG No.	REFERENCES
2000-F72-SCM-EL-10232	F72-SW-172 415V EMERGENCY MCC SCHEMATIC DIAGRAM SHEET 2
2000-F72-SLD-EL-10211	F72-SW-172 415V EMERGENCY MCC SINGLE LINE DIAGRAM SHEET 1
2000-F72-SLD-EL-10201	F72-SW-072 415V MCC SINGLE LINE DIAGRAM SHEET 1
2000-F00-STD-EL-10001	GENERAL NOTES AND STANDARD DRAWINGS INDEX

REV	DATE	DESCRIPTION	DRAW	CHECK	DESIGN	TECH APP	PROJ APP
2	04NOV25	FAT REDLINES INCORPORATED					
1	05MAY25	GENERATOR INCOMER ELR SHUNT TRIP ADDED					
0	25FEB25	APPROVED FOR CONSTRUCTION					

NORTHERN STAR RESOURCES LIMITED

PRIMERO
primero.com.au | DESIGN | CONSTRUCT | OPERATE

PRIMERO PROJECT NUMBER: 23517

INFORMATION AND REPRESENTATIONS ON THIS DRAWING ARE THE INTELLECTUAL PROPERTY OF PRIMERO UNLESS SPECIFICALLY IDENTIFIED OTHERWISE. ALL RIGHTS INCLUDING USE RESERVED

PROJECT: NORTHERN STAR RESOURCES LTD
KCGM GROWTH PROJECT

TITLE: REAGENTS MIXING & STORAGE - F72-SW-172
F72-SW-172 415V EMERGENCY MCC INCOMER
SCHEMATIC DIAGRAM SHEET 1

SHEET	SCALE	DRG No.	REVISION
A1	NONE	2000-F72-SCM-EL-10231	2

O:\CAD PROJECTS\235 NORTHERN STAR RESOURCES LTD\23517 KCGM GROWTH PROJECT\03 DELIVERABLES\ELEC\F72 - REAGENTS MIXING & STORAGE\2000-F72-SCM-EL-10231.DWG 02DEC25 12:40PM HOTSEAT04