

Docusign Envelope ID: 742BBA16-6BAC-861E-814B-1759B9FB57E9

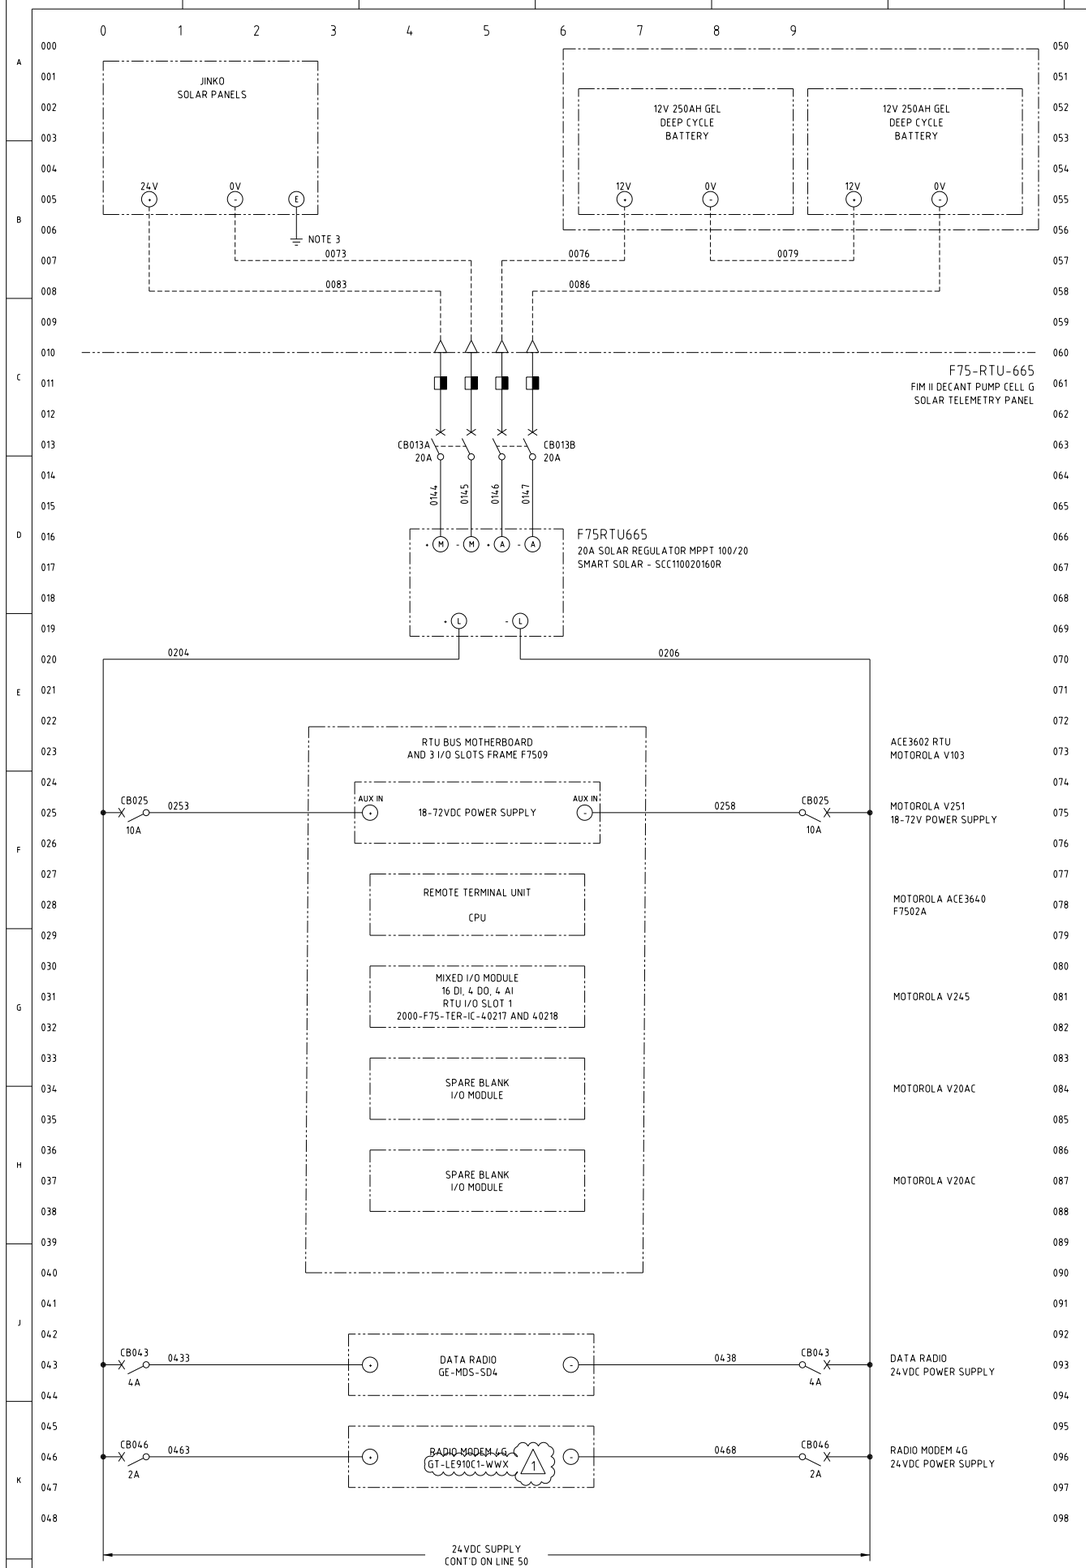

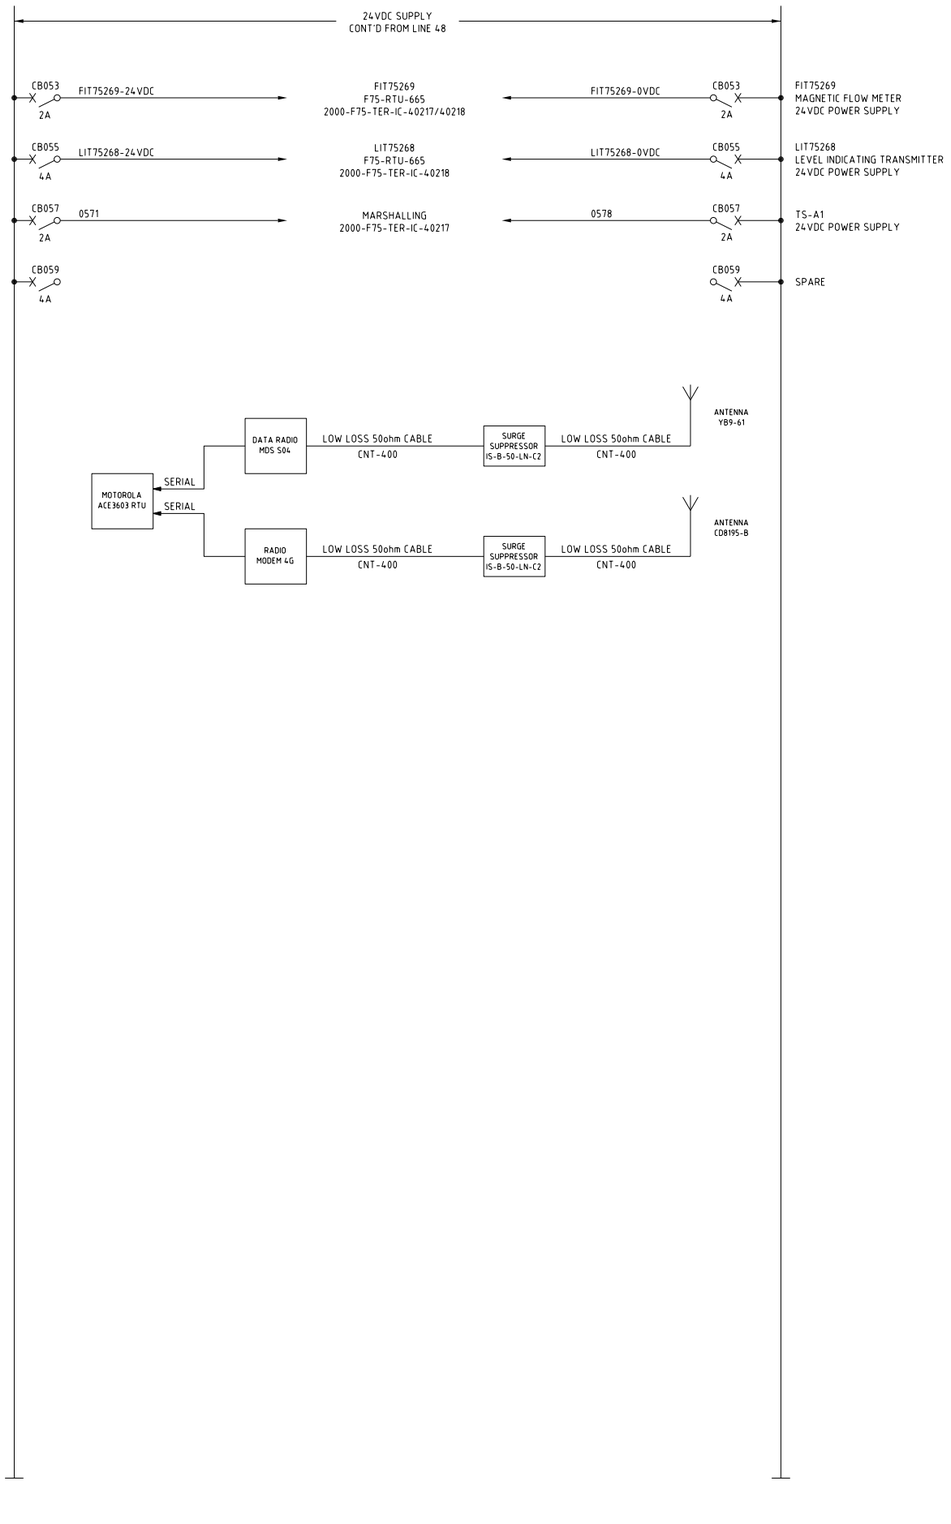

NOTES

1. WIRE NUMBER FERRULES ON TERMINAL STRIP SHALL BE PREFIXED WITH EQUIPMENT NUMBER e.g. FxxPPxxx-1200.
2. EACH WIRE SHALL BE IDENTIFIED AT BOTH ENDS WITH FERRULES.
3. EARTH TO RTU TELEMETRY PANEL FRAME.
4. CIRCUIT BREAKERS TO BE DOUBLE POLE AS SHOWN.

LEGEND

- FIELD TERMINAL
- RTU PANEL TERMINAL
- DEVICE TERMINAL
- INDICATION LAMP (cc = COLOUR)
- EARTH BAR
- IEB — INSTRUMENT EARTH BAR

NORTHERN STAR RESOURCES LIMITED

Approved	X
Approved as Noted	☐
Not Approved	☐
For Information Only	☐

Date [redacted] 29.06.2026

ACCEPTANCE DOES NOT RELIEVE THE SUPPLIER / CONTRACTOR OF ITS RESPONSIBILITY OR LIABILITIES UNDER THE PURCHASE ORDER / CONTRACT

APPROVED FOR CONSTRUCTION

REFERENCES	DWG No	REV	DATE	REVISION
F75-RTU-665 FIM II TAILINGS DAM DECANT PUMP CELL G SOLAR TELEMETRY PANEL TERMINATION DIAGRAM SHEET 2	2000-F75-TER-IC-40218			
F75-RTU-665 FIM II TAILINGS DAM DECANT PUMP CELL G SOLAR TELEMETRY PANEL TERMINATION DIAGRAM SHEET 1	2000-F75-TER-IC-40217	1	25.JUN.26	RE-APPROVED FOR CONSTRUCTION
GENERAL NOTES AND STANDARD DRAWINGS INDEX	2000-F00-STD-EL-10001	0	08.JUN.26	APPROVED FOR CONSTRUCTION

[redacted] TECH APP [redacted]

NORTHERN STAR RESOURCES LIMITED

DRA PACIFIC (PTY) LIMITED

[redacted]	[redacted]	08.JUN.2026
CHECKED	[redacted]	08.JUN.2026
DESIGNED	[redacted]	08.JUN.2026
TECH APP	[redacted]	08.JUN.2026
[redacted] PP	[redacted]	08.JUN.2026
CLIENT APP		

PROJECT: KCGM
FIM - TSF PROJECT

TITLE: FIM II TAILINGS DAM
F75-RTU-665 FIM II DECANT PUMP CELL G SOLAR TELEMETRY PANEL
SCHEMATIC DIAGRAM

A1 | SCALE NTS | DRG No. 2000-F75-SCM-IC-40201 | REV 1