
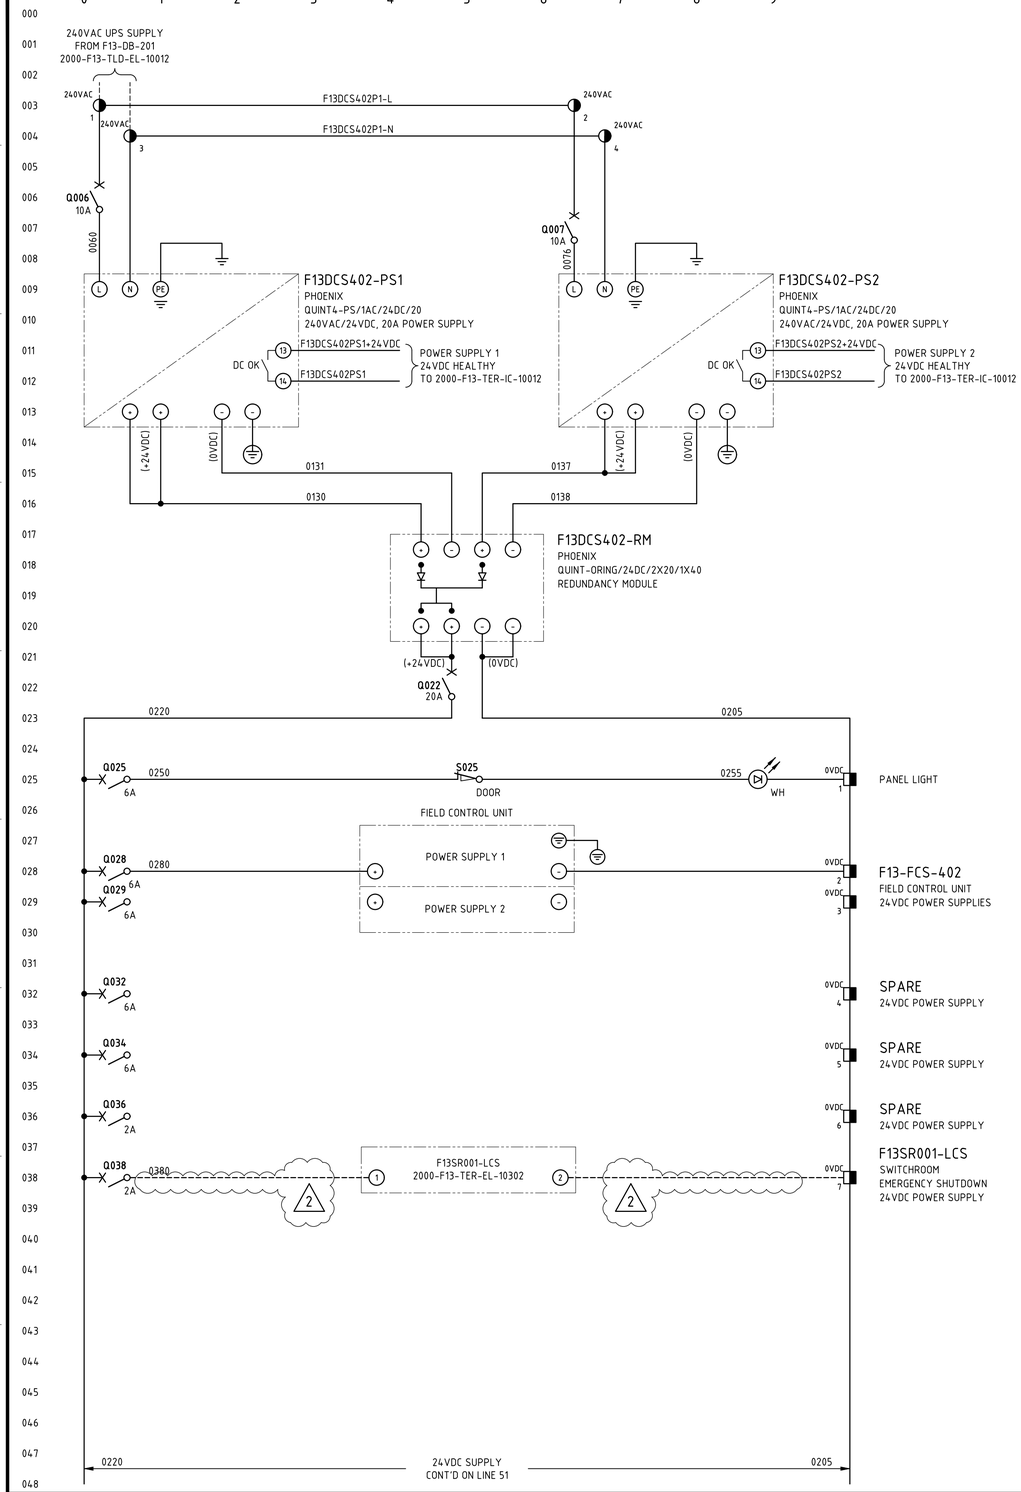


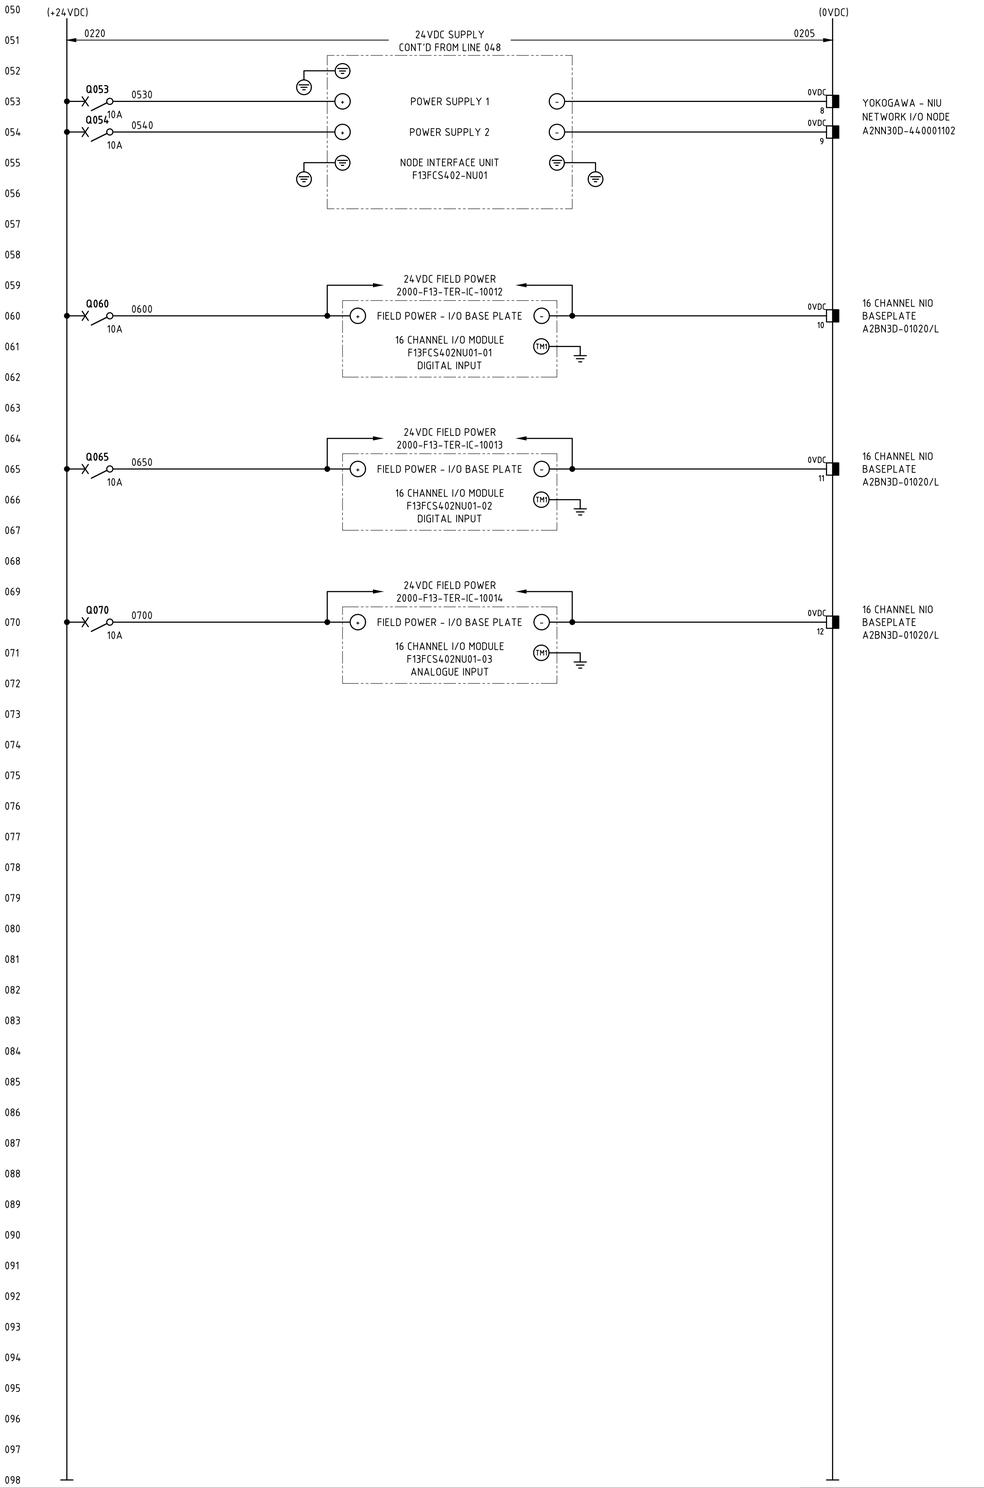

NOTES

1. TERMINALS ON TERMINAL STRIPS ABOVE 50VAC SHALL HAVE A SEPARATE PERSPEX SHROUD AND SHALL BE LABELLED "DANGER xxxVAC".
2. WIRE NUMBER FERRULES ON TERMINAL STRIP SHALL BE PREFIXED WITH EQUIPMENT NUMBER e.g. F13DCS402-xxxx.
3. EACH WIRE SHALL BE IDENTIFIED AT BOTH ENDS WITH FERRULES.
4. FOR NETWORK CONNECTION & BUS CABLING DETAILS REFER TO DCS PANEL COMMUNICATIONS TERMINATION DIAGRAMS.
5. INSTRUMENT EARTH BAR TO BE BONDED TO MAIN EARTH BAR WITH SOLID COPPER LINK.

LEGEND

- FIELD TERMINAL
- DCS OR I/O TERMINAL
- 0VDC TERMINAL FOR 24VDC (2)
- DEVICE TERMINAL
- EARTH BAR
- INSTRUMENT EARTH BAR

NIO BASEPLATE

F13FCS402NU01-01

- NETWORKED INPUT/OUTPUT (N-IO) BASEPLATE
- NODE INTERFACE UNIT (N-IU)
- FIELD CONTROL UNIT

DRG No.	REFERENCES
2000-F13-TLD-EL-10012	F13-DB-201 SAG MILL LV SWITCHROOM 240VAC UPS DB THREE LINE DIAGRAM
2000-F13-DRG-IC-10011	F13-DCS-402 415V SWITCHROOM DCS PANEL GENERAL ARRANGEMENT
2000-F13-TER-IC-10011	F13-DCS-402 415V SWITCHROOM DCS PANEL COMMUNICATIONS TERMINATION DIAGRAM
2000-F13-TER-IC-10012	F13-DCS-402 415V SWITCHROOM DCS PANEL TERMINATION DIAGRAM SHEET 1 (TO SHEET 3 - 10014)
2000-F13-STD-EL-10001	GENERAL NOTES AND STANDARD DRAWINGS INDEX

REV	DATE	DESCRIPTION	DRAW	CHECK	DESIGN	TECH APP	PROJ APP
2	18AUG25	FAT REDLINES INCORPORATED					
1	12DEC24	ADDED E-SHUT LCS					
0	30AUG24	APPROVED FOR CONSTRUCTION					

NORTHERN STAR RESOURCES LIMITED

PRIMERO
primero.com.au | DESIGN | CONSTRUCT | OPERATE

PRIMERO PROJECT NUMBER: 23517

INFORMATION AND REPRESENTATIONS ON THIS DRAWING ARE THE INTELLECTUAL PROPERTY OF PRIMERO UNLESS SPECIFICALLY IDENTIFIED OTHERWISE. ALL RIGHTS INCLUDING USE RESERVED

PROJECT: NORTHERN STAR RESOURCES LTD
KCGM GROWTH PROJECT

TITLE: MILLING & CLASSIFICATION - F13-SR-001
F13-DCS-402 415V SWITCHROOM DCS PANEL
SCHEMATIC DIAGRAM

SHEET	SCALE	DRG No.	REVISION
A1	1:5 UON	2000-F13-SCM-IC-10011	2

O:\CAD PROJECTS\235 NORTHERN STAR RESOURCES LTD\235171 KCGM GROWTH PROJECT\03 DELIVERABLES\IC\F13 - MILLING & CLASSIFICATION\2000-F13-SCM-IC-10011.DWG 27AUG25 7:46AM HOTSEAT04