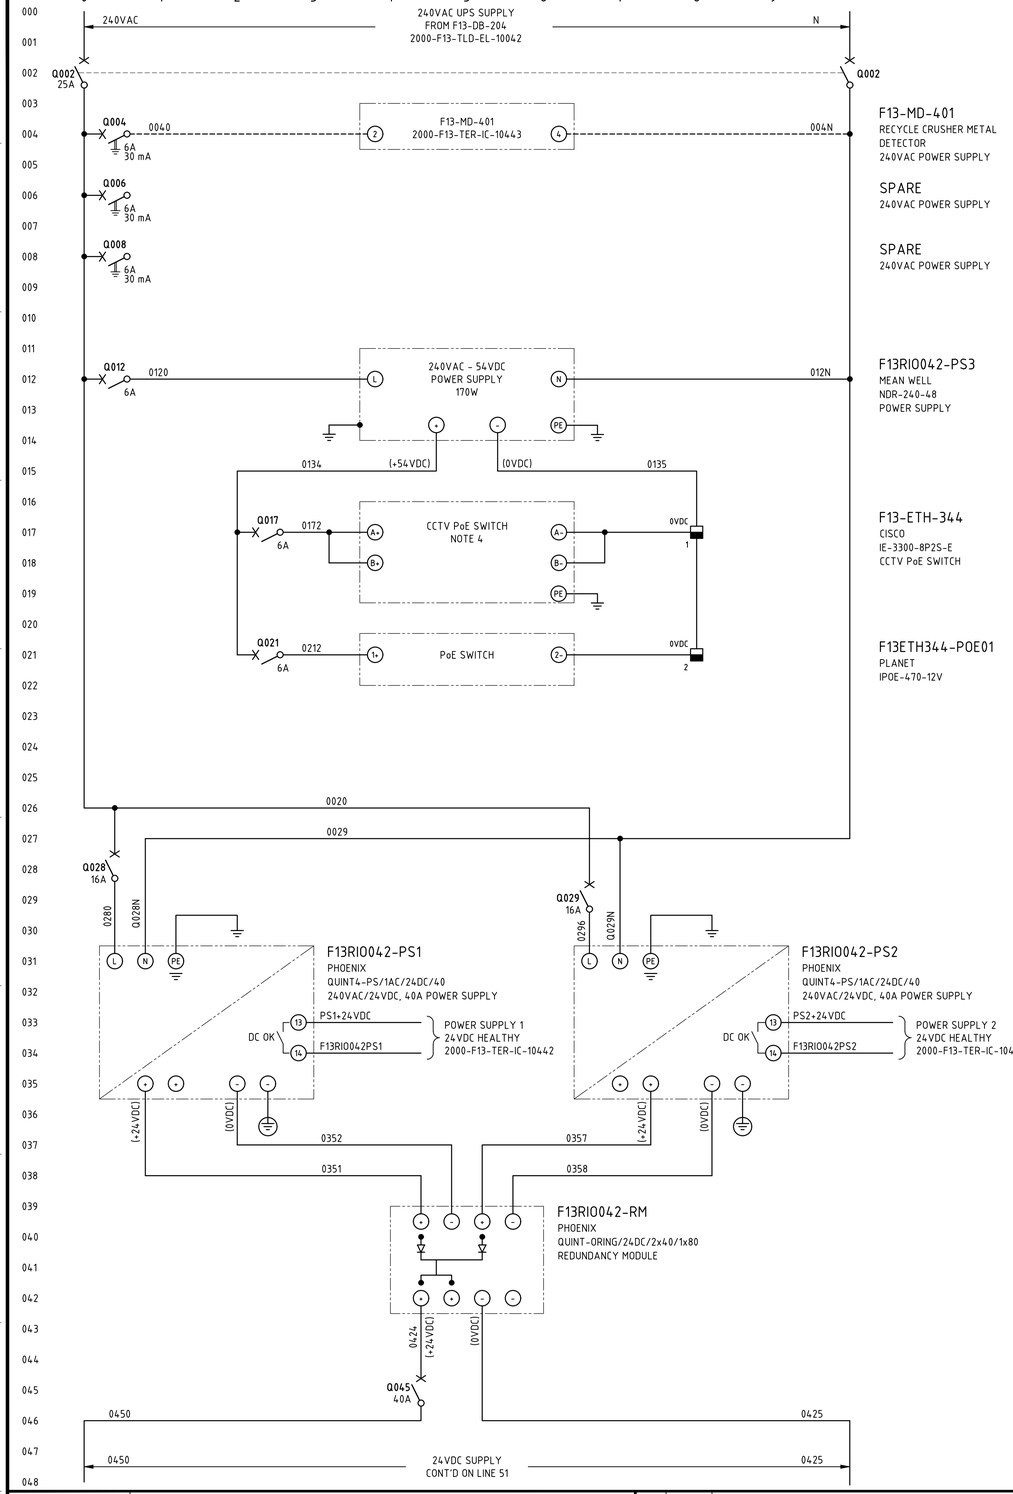


F13-MD-401
RECYCLE CRUSHER METAL DETECTOR
240VAC POWER SUPPLY


SPARE
240VAC POWER SUPPLY

SPARE
240VAC POWER SUPPLY

F13RIO042-PS3
MEAN WELL
NDR-240-48
POWER SUPPLY

F13-ETH-344
CISCO
IE-3300-8P2S-E
CCTV PoE SWITCH

F13ETH344-POE01
PLANET
IPOE-470-12V

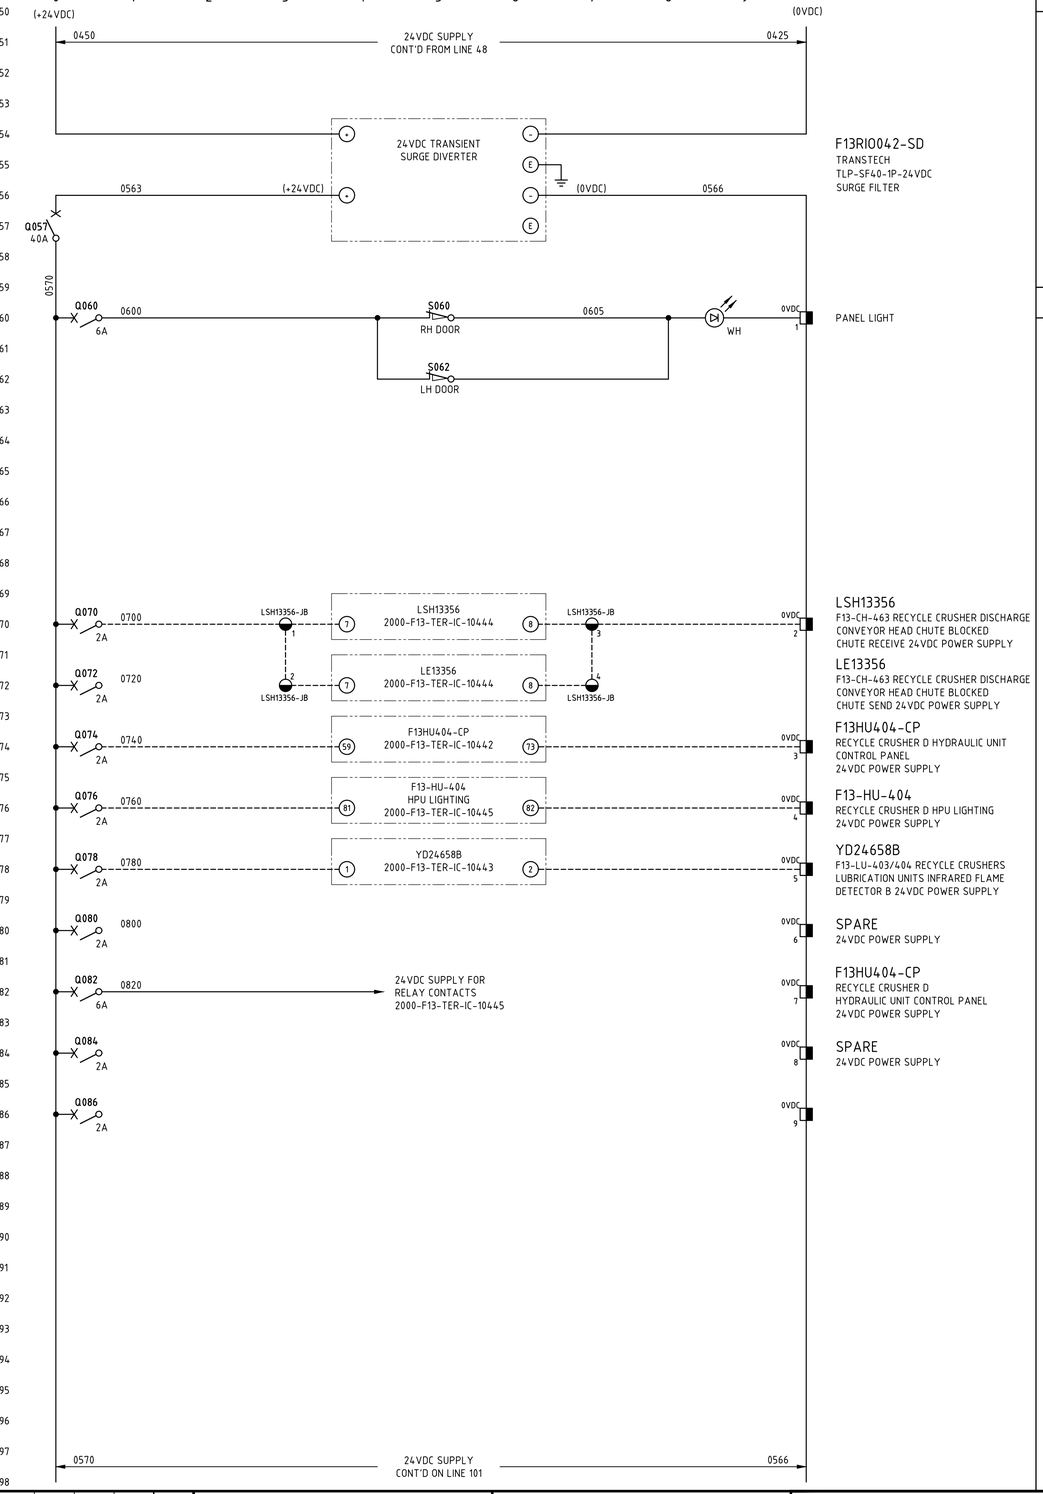

F13RIO042-SD
TRANSTECH
TLP-SF40-1P-24VDC
SURGE FILTER

PANEL LIGHT

LSH13356
F13-CH-463 RECYCLE CRUSHER DISCHARGE CONVEYOR HEAD CHUTE BLOCKED
CHUTE RECEIVE 24VDC POWER SUPPLY

LE13356
F13-CH-463 RECYCLE CRUSHER DISCHARGE CONVEYOR HEAD CHUTE BLOCKED
CHUTE SEND 24VDC POWER SUPPLY

F13HU404-CP
RECYCLE CRUSHER D HYDRAULIC UNIT CONTROL PANEL
24VDC POWER SUPPLY

F13-HU-404
RECYCLE CRUSHER D HPU LIGHTING
24VDC POWER SUPPLY

YD24658B
F13-LU-403/404 RECYCLE CRUSHERS LUBRICATION UNITS INFRARED FLAME DETECTOR B 24VDC POWER SUPPLY

SPARE
24VDC POWER SUPPLY

F13HU404-CP
RECYCLE CRUSHER D
HYDRAULIC UNIT CONTROL PANEL
24VDC POWER SUPPLY

SPARE
24VDC POWER SUPPLY

NOTES

1. TERMINALS ON TERMINAL STRIPS ABOVE 50VAC SHALL HAVE A SEPARATE PERSPEX SHROUD AND SHALL BE LABELLED "DANGER xxxVAC".
2. WIRE NUMBER FERRULES ON TERMINAL STRIP SHALL BE PREFIXED WITH EQUIPMENT NUMBER e.g. F13RIO042-xxxx.
3. EACH WIRE SHALL BE IDENTIFIED AT BOTH ENDS WITH FERRULES.
4. FOR NETWORK CONNECTION & BUS CABLING DETAILS REFER TO RIO PANEL COMMUNICATIONS TERMINATION DIAGRAMS.
5. INSTRUMENT EARTH BAR TO BE BONDED TO MAIN EARTH BAR WITH SOLID COPPER LINK.

LEGEND

- FIELD TERMINAL
- DCS OR I/O TERMINAL
- 0VDC TERMINAL FOR 24VDC
- 0VDC TERMINAL FOR 54VDC
- DEVICE TERMINAL
- INDICATION LAMP (cc = COLOUR)
- EARTH BAR
- INSTRUMENT EARTH BAR

DRG No.	REFERENCES
2000-F13-TLD-EL-10042	F13-DB-204 SWITCHROOM 240V UPS DB THREE LINE DIAGRAM
2000-F13-DRG-IC-10441	F13-RIO-042 FIELD N-IO PANEL GENERAL ARRANGEMENT
2000-F13-SCM-IC-10442	F13-RIO-042 FIELD N-IO PANEL SCHEMATIC DIAGRAM SHEET 2
2000-F13-TER-IC-10440	F13-RIO-042 FIELD N-IO PANEL COMMUNICATIONS TERMINATION DIAGRAM SHEET 1 (TO SHEET 2 - 10441)
2000-F13-TER-IC-10442	F13-RIO-042 FIELD N-IO PANEL TERMINATION DIAGRAM SHEET 1 (TO SHEET 8 - 10449)
2000-F00-STD-EL-10001	GENERAL NOTES AND STANDARD DRAWINGS INDEX

REV	DATE	DESCRIPTION	DRAW	CHECK	DESIGN	TECH APP	PROJ APP
2	26AUG26	KCGM GROWTH PROJECT - SP1 AS-BUILT					
1	05MAY25	FAT REDLINES INCORPORATED					
0	05FEB25	APPROVED FOR CONSTRUCTION			JB	JB	

NORTHERN STAR RESOURCES LIMITED

PRIMERO
primero.com.au | DESIGN | CONSTRUCT | OPERATE

PRIMERO PROJECT NUMBER: 23517

INFORMATION AND REPRESENTATIONS ON THIS DRAWING ARE THE INTELLECTUAL PROPERTY OF PRIMERO UNLESS SPECIFICALLY IDENTIFIED OTHERWISE. ALL RIGHTS INCLUDING USE RESERVED

PROJECT: NORTHERN STAR RESOURCES LTD
KCGM GROWTH PROJECT

TITLE: MILLING & CLASSIFICATION - RECYCLE CRUSHING
F13-RIO-042 RECYCLE CRUSHING FIELD N-IO PANEL
SCHEMATIC DIAGRAM SHEET 1

SHEET	SCALE	DRG No.	REVISION
A1	NONE	2000-F13-SCM-IC-10441	2

O:\CAD PROJECTS\235 NORTHERN STAR RESOURCES LTD\23517 KCGM GROWTH PROJECT\03 DELIVERABLES\IC\F13 - MILLING & CLASSIFICATION\2000-F13-SCM-IC-10441.DWG 25AUG26 1:19PM GRENVILLE.DEASY