
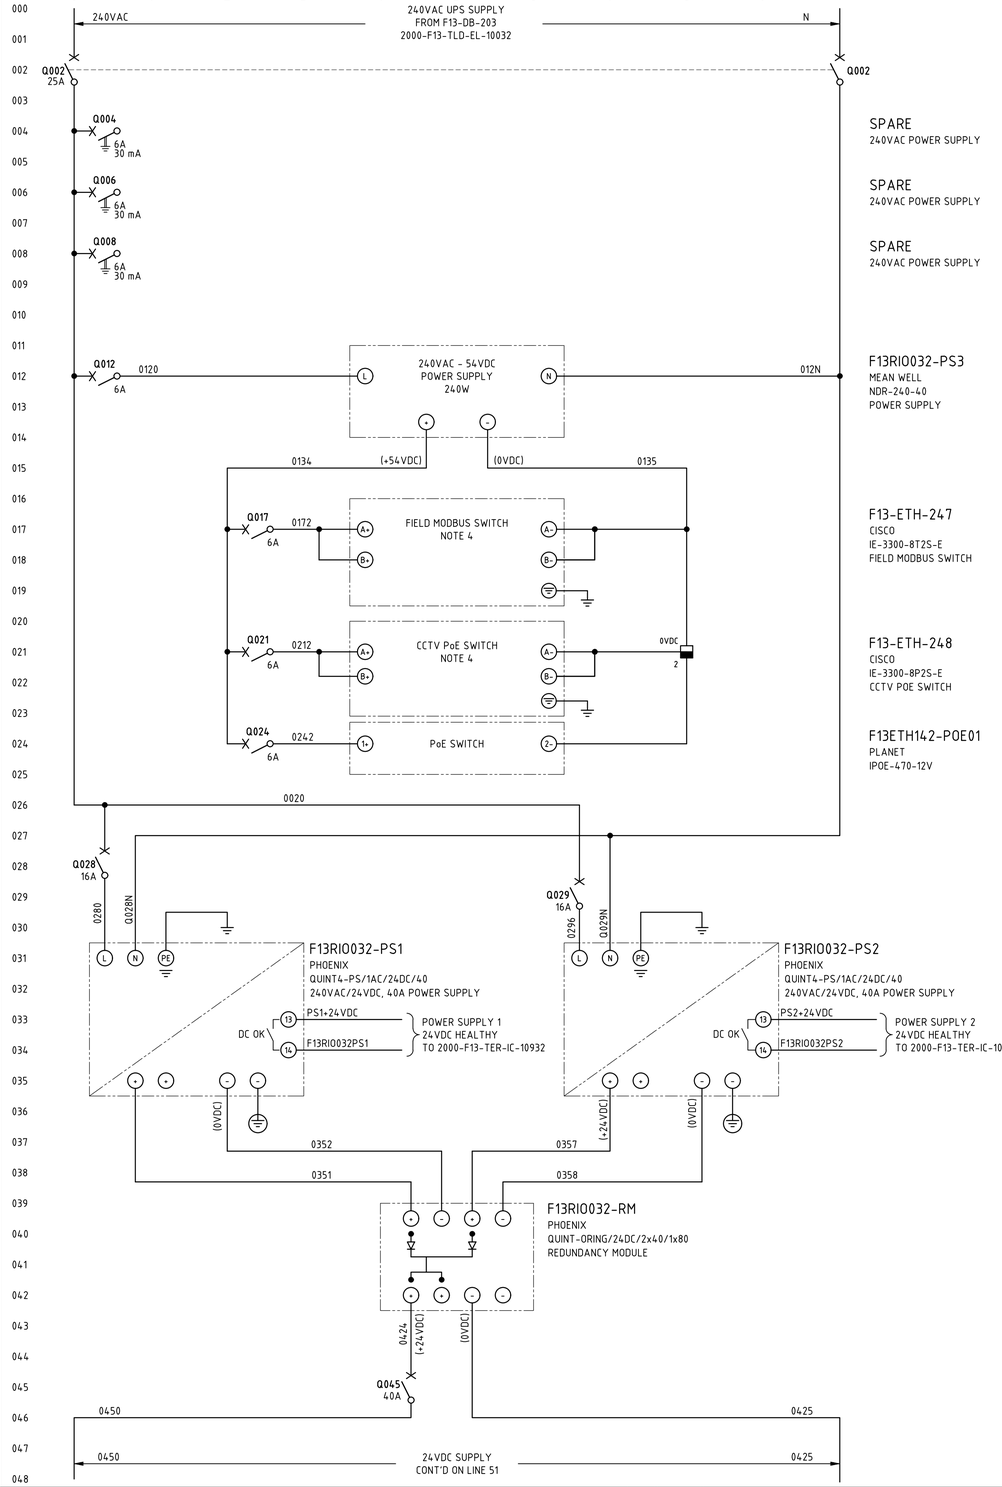


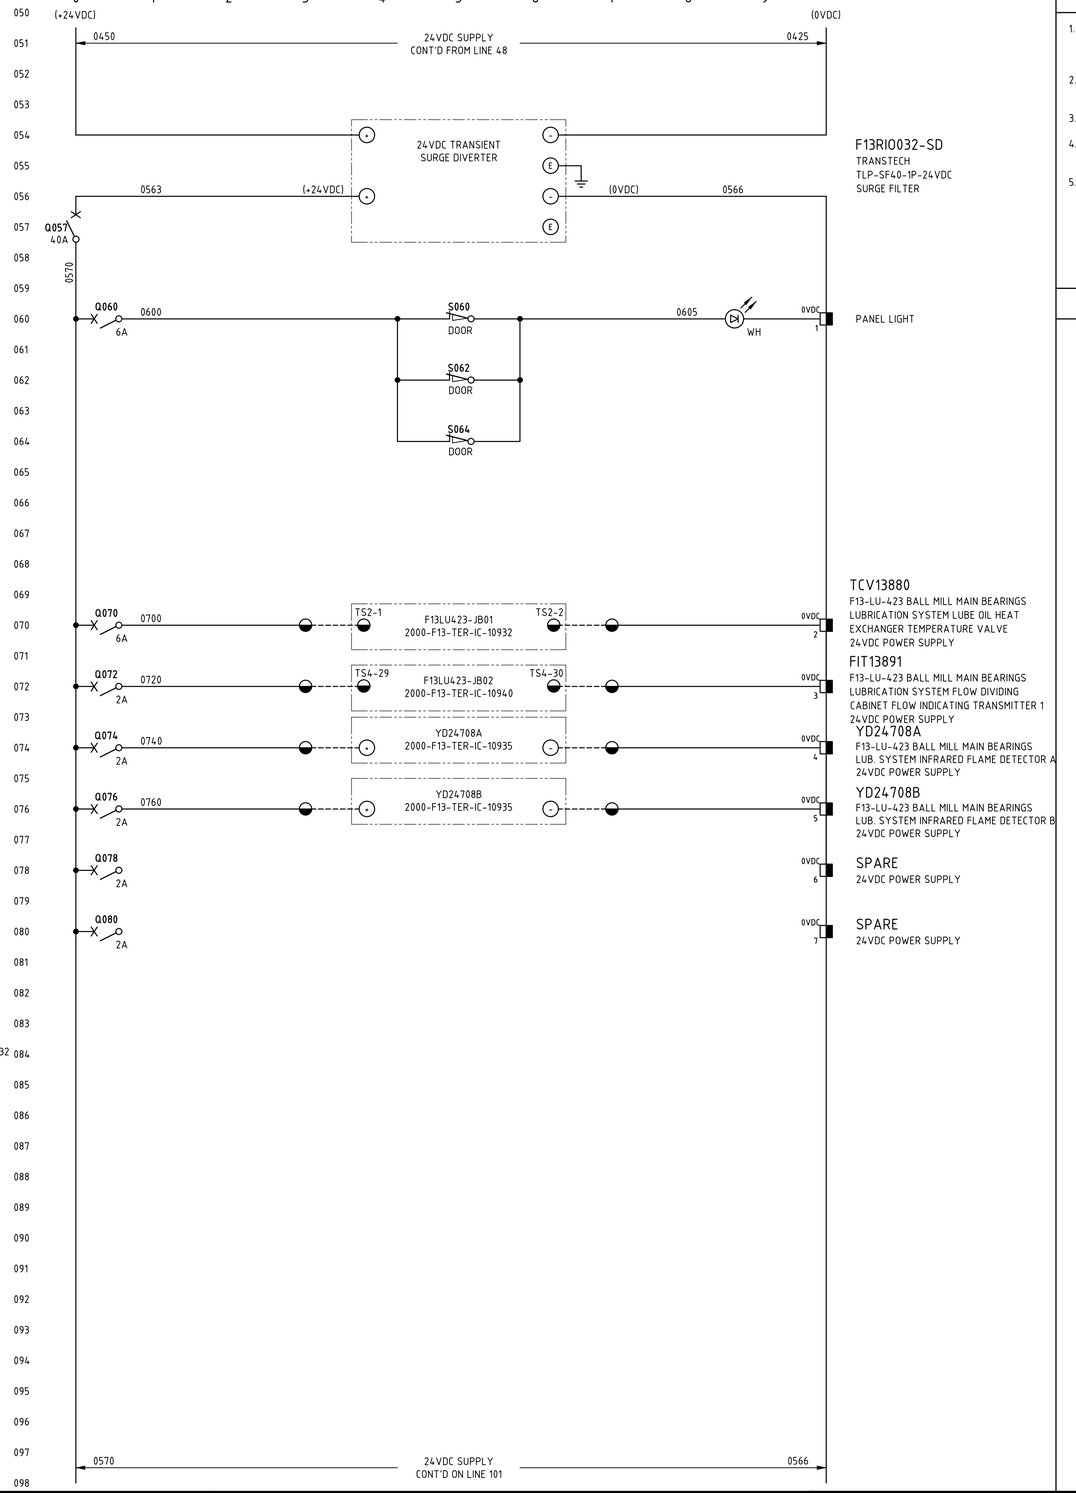

NOTES

1. TERMINALS ON TERMINAL STRIPS ABOVE 50VAC SHALL HAVE A SEPARATE PERSPEX SHROUD AND SHALL BE LABELLED "DANGER xxxVAC".
2. WIRE NUMBER FERRULES ON TERMINAL STRIP SHALL BE PREFIXED WITH EQUIPMENT NUMBER e.g. F13RIO032-xxxx.
3. EACH WIRE SHALL BE IDENTIFIED AT BOTH ENDS WITH FERRULES.
4. FOR NETWORK CONNECTION & BUS CABLING DETAILS REFER TO RIO PANEL COMMUNICATIONS TERMINATION DIAGRAMS.
5. INSTRUMENT EARTH BAR TO BE BONDED TO MAIN EARTH BAR WITH SOLID COPPER LINK.

LEGEND

- FIELD TERMINAL
- DCS OR I/O TERMINAL
- MARSHALLING TERMINAL
- DEVICE TERMINAL
- INDICATION LAMP, cc = COLOUR
- EARTH BAR
- INSTRUMENT EARTH BAR

DRG No.	REFERENCES	REV	DATE	DESCRIPTION	DRAW	CHECK	DESIGN	TECH APP	PROJ APP
2000-F13-DRG-IC-10931	F13-RIO-032 FIELD N-IO PANEL GENERAL ARRANGEMENT								
2000-F13-SCM-IC-10932	F13-RIO-032 FIELD N-IO PANEL SCHEMATIC DIAGRAM SHEET 2								
2000-F13-TER-IC-10930	F13-RIO-032 FIELD N-IO PANEL COMMS TERMINATION DIAGRAM SHEET 1 (TO SHEET 2 - 10931)	2	26AUG26	KCGM GROWTH PROJECT - SP1 AS-BUILT					
2000-F13-TER-IC-10932	F13-RIO-032 FIELD N-IO PANEL TERMINATION DIAGRAM SHEET 1 (TO SHEET 12 - 10943)	1	08JAN25	INSTRUMENTS ADDED. RE-ISSUED FOR CONSTRUCTION					
2000-F00-STD-EL-10001	GENERAL NOTES AND STANDARD DRAWINGS INDEX	0	03DEC24	APPROVED FOR CONSTRUCTION					

NORTHERN STAR RESOURCES LIMITED

PRIMERO
primero.com.au | DESIGN | CONSTRUCT | OPERATE

PRIMERO PROJECT NUMBER: 23517

INFORMATION AND REPRESENTATIONS ON THIS DRAWING ARE THE INTELLECTUAL PROPERTY OF PRIMERO UNLESS SPECIFICALLY IDENTIFIED OTHERWISE. ALL RIGHTS INCLUDING USE RESERVED

PROJECT: NORTHERN STAR RESOURCES LTD
KCGM GROWTH PROJECT

TITLE: MILLING & CLASSIFICATION - BALL MILL
F13-RIO-032 BALL MILL FIELD N-IO PANEL
SCHEMATIC DIAGRAM SHEET 1

SHEET	SCALE	DRG No.	REVISION
A1	NONE	2000-F13-SCM-IC-10931	2

O:\CAD PROJECTS\235 NORTHERN STAR RESOURCES LTD\23517 KCGM GROWTH PROJECT\03 DELIVERABLES\IC\F13 - MILLING & CLASSIFICATION\2000-F13-SCM-IC-10931.DWG 25AUG26 14:0PM GRENVILLE.DEASY