
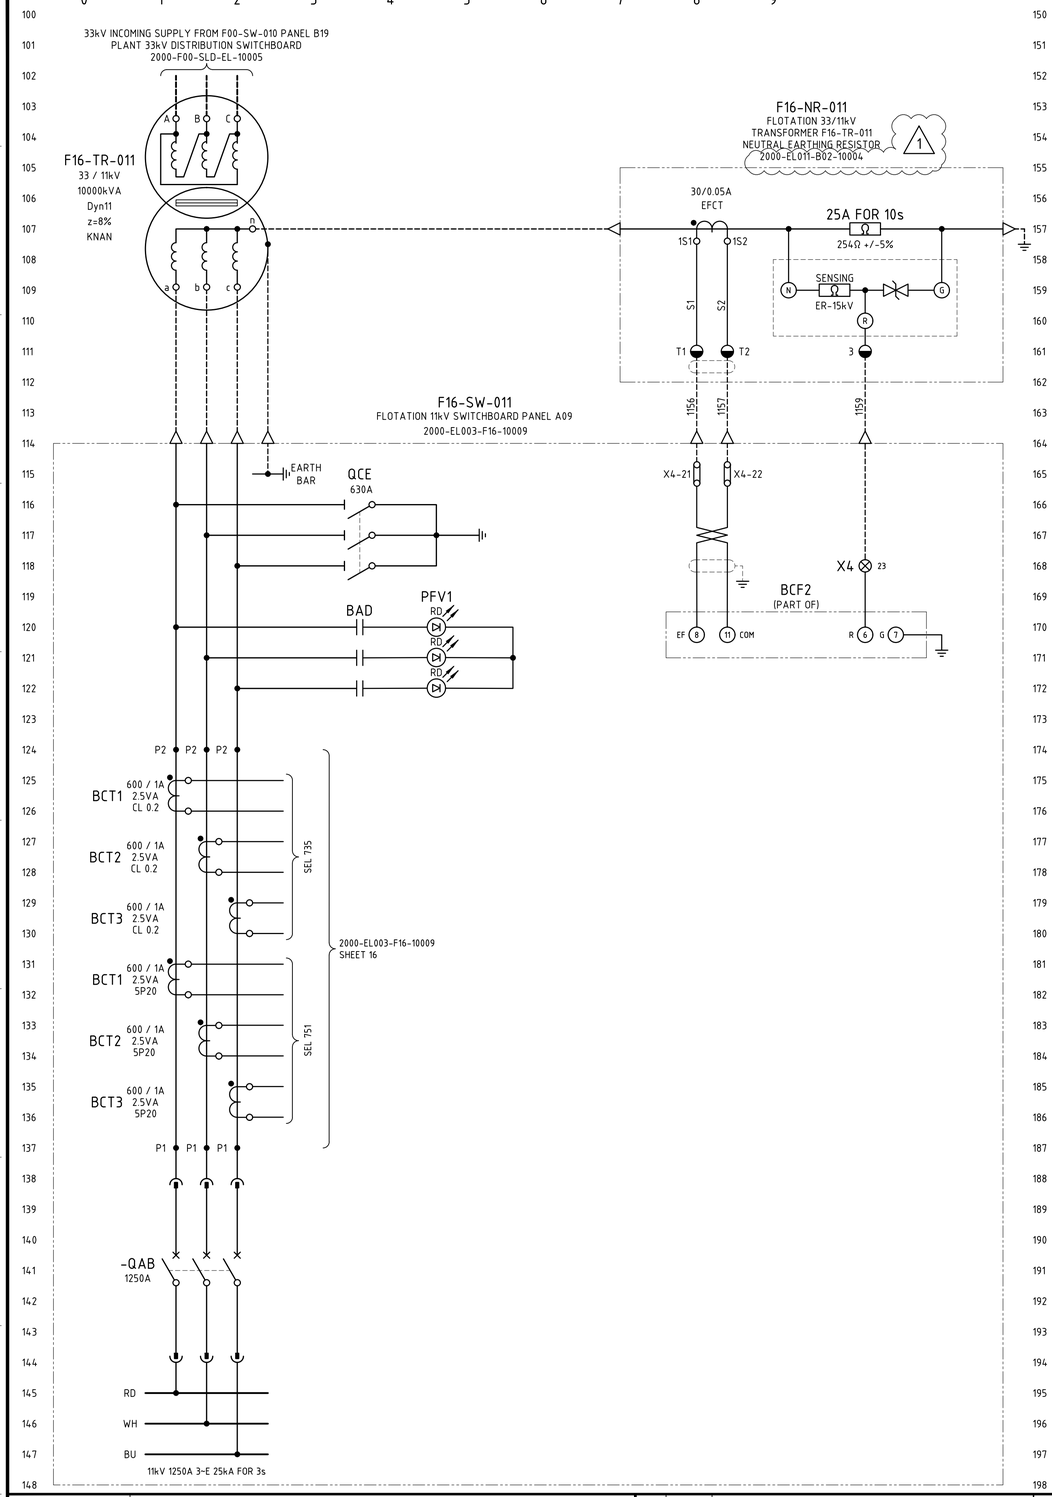


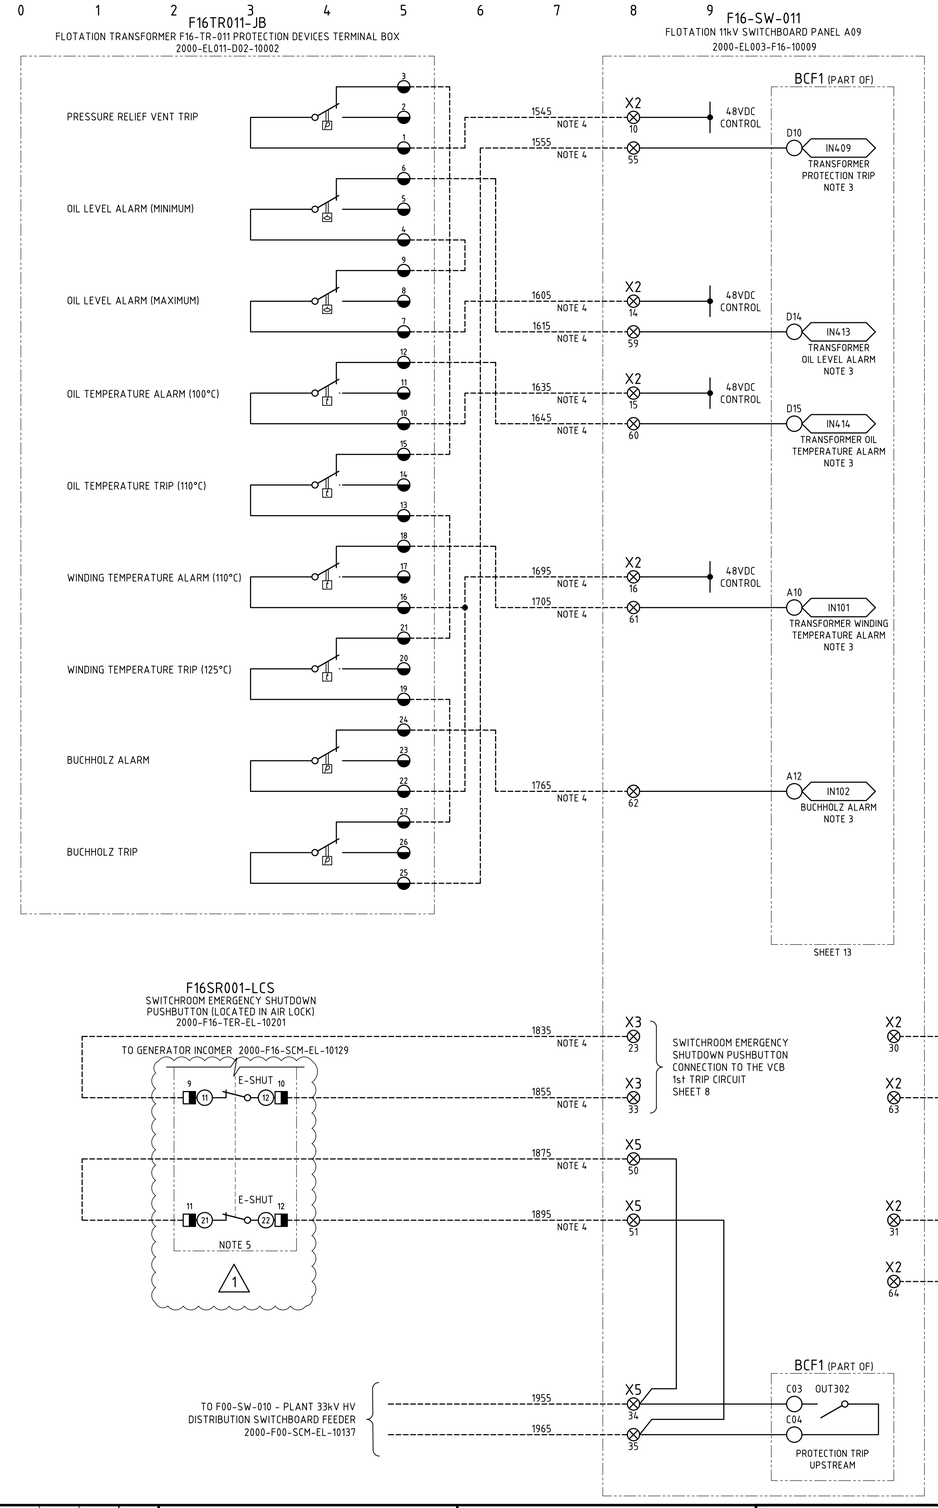

NOTES

1. WIRE NUMBER FERRULES ON TERMINAL STRIP SHALL BE PREFIXED WITH EQUIPMENT NUMBER e.g. F16SW011-1200, UNLESS OTHERWISE NOTED.
2. EACH WIRE SHALL BE IDENTIFIED AT BOTH ENDS WITH FERRULES.
3. ALL ALARMS AND TRIPS SHALL BE FAIL-SAFE. NOTE THAT THE PROTECTION RELAY INPUTS SHALL BE INVERTED, I.E. ALARM AND TRIP WHEN CONTACT IS OPENED.
4. NOTE THAT CROSS SECTIONAL AREA OF CABLES TO THE TRANSFORMER MARSHALLING PANEL FROM F00-SW-010 ARE INCREASED IN SIZE - REFER TO THE CABLE SCHEDULE.
5. E-SHUT CIRCUIT IS FAIL SAFE. NORMALLY CLOSED CONTACTS WILL BE OPEN WHEN THE E-SHUT BUTTON IS UN-ACTIVATED AND THE CIRCUIT HEALTHY.

LEGEND

- xx/xx/xx — DCS DIGITAL INPUT
- xx/xx/xx — DCS DIGITAL OUTPUT
- xx/xx/xx — DCS ANALOGUE INPUT
- xx/xx/xx — DCS ANALOGUE OUTPUT
- xx/xx/xx — DCS ANALOGUE RTD INPUT
- MCC TERMINAL
- VSD TERMINAL
- FIELD TERMINAL
- DCS OR I/O TERMINAL
- MARSHALLING TERMINAL
- (x) DEVICE TERMINAL

1

PANEL A09

DRG No.	REFERENCES
2000-EL003-F16-10009	F16-SW-011 ABB SCHEMATIC DIAGRAM
2000-F16-TER-EL-10117	F16-SW-011 11kV SWITCHBOARD - PANEL A09 (INCOMER) TERMINATION DIAGRAM SHEET 1
2000-F16-SLD-EL-10002	F16-SW-011 11kV SWITCHBOARD SINGLE LINE DIAGRAM SHEET 2
2000-F00-STD-EL-10001	GENERAL NOTES AND STANDARD DRAWINGS INDEX

REV	DATE	DESCRIPTION	DRAW	CHECK	DESIGN	TECH APP	PROJ APP
1	29AUG25	FAT REDLINES INCORPORATED				MB	
0	15JAN25	APPROVED FOR CONSTRUCTION					

NORTHERN STAR RESOURCES LIMITED

PRIMERO
primero.com.au | DESIGN | CONSTRUCT | OPERATE

PRIMERO PROJECT NUMBER: 23517

INFORMATION AND REPRESENTATIONS ON THIS DRAWING ARE THE INTELLECTUAL PROPERTY OF PRIMERO UNLESS SPECIFICALLY IDENTIFIED OTHERWISE. ALL RIGHTS INCLUDING USE RESERVED

PROJECT: NORTHERN STAR RESOURCES LTD
KCGM GROWTH PROJECT

TITLE: ROUGHER & SCAVENGER FLOTATION - F16-SW-011
F16-SW-011 INCOMER 1
SCHEMATIC DIAGRAM

SHEET	SCALE	DRG No.	REVISION
A1	NONE	2000-F16-SCM-EL-10117	1

O:\CAD PROJECTS\23S NORTHERN STAR RESOURCES LTD\23517 KCGM GROWTH PROJECT\03 DELIVERABLES\SEL\F16 - ROUGHER & SCAVENGER FLOTATION\2000-F16-SCM-EL-10117.DWG 09SEP25 6:42AM HOTSEAT04