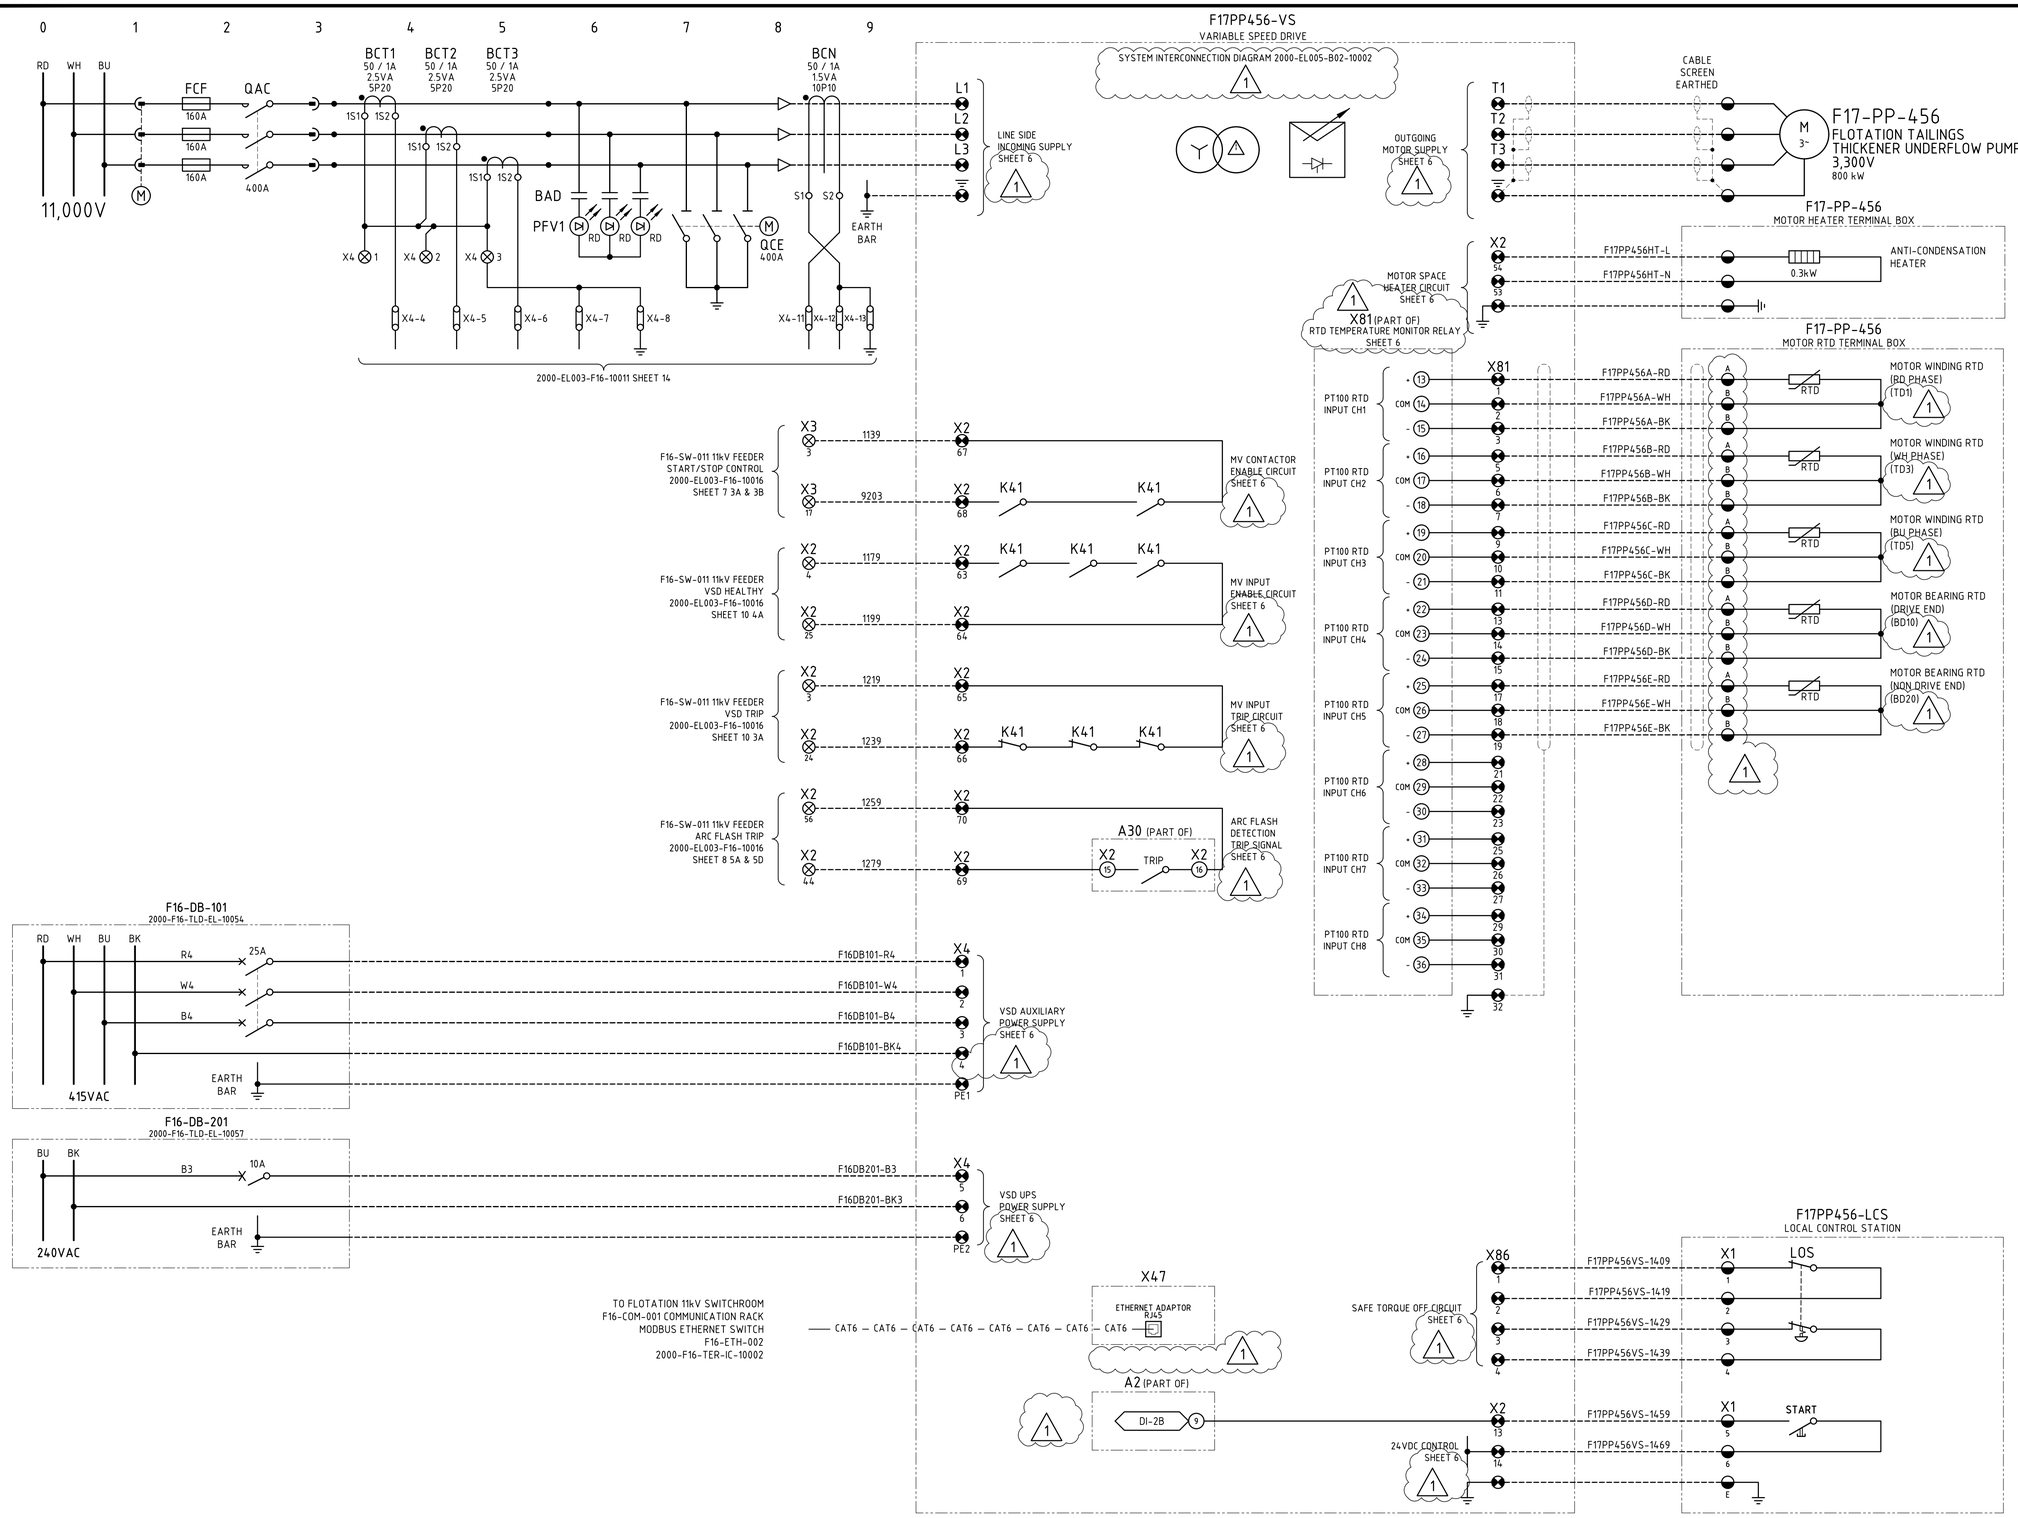


NOTES

1. WIRE NUMBER FERRULES ON TERMINAL STRIP SHALL BE PREFIXED WITH EQUIPMENT NUMBER e.g. F17PP456-1200, UNLESS OTHERWISE NOTED.
2. EACH WIRE SHALL BE IDENTIFIED AT BOTH ENDS WITH FERRULES.

LEGEND

- 11kV SWITCHBOARD TERMINAL
- VSD TERMINAL
- FIELD TERMINAL
- DCS OR I/O TERMINAL
- MARSHALLING TERMINAL
- DEVICE TERMINAL

PANEL A19

DRG No.	REFERENCES
2000-F16-TER-EL-10173	11kV SWITCHBOARD REMOTE SWITCHING PANEL TERMINATION DIAGRAM SHEET 3
2000-F16-SCM-EL-10178	11kV SWITCHBOARD REMOTE SWITCHING PANEL SCHEMATIC DIAGRAM SHEET 8
2000-EL005-D02-10002	FITPP456-VS SIEMENS VSD SCHEMATIC DIAGRAMS
2000-EL003-F16-10011	F16-SW-011 ABB SCHEMATIC DIAGRAM
2000-F16-TER-EL-10137	F16-SW-011 11kV SWITCHBOARD - PANEL A19 (F17PP456-VS) TERMINATION DIAGRAM SHEET 1
2000-F16-SLD-EL-10003	F16-SW-011 11kV SWITCHBOARD SINGLE LINE DIAGRAM SHEET 3
2000-F00-STD-EL-10001	GENERAL NOTES AND STANDARD DRAWINGS INDEX

REV	DATE	DESCRIPTION	DRAW	CHECK	DESIGN	TECH APP	PROJ APP
1	29AUG25	FAT REDLINES INCORPORATED					
0	15JAN25	APPROVED FOR CONSTRUCTION					

NORTHERN STAR RESOURCES LIMITED

PRIMERO
primero.com.au | DESIGN | CONSTRUCT | OPERATE
PRIMERO PROJECT NUMBER: 23517

INFORMATION AND REPRESENTATIONS ON THIS DRAWING ARE THE INTELLECTUAL PROPERTY OF PRIMERO UNLESS SPECIFICALLY IDENTIFIED OTHERWISE. ALL RIGHTS INCLUDING USE RESERVED

PROJECT: NORTHERN STAR RESOURCES LTD
KCGM GROWTH PROJECT

TITLE: ROUGHER & SCAVENGER FLOTATION - F16-SW-011
F17-PP-456 FLOT TAILS THICK U/FLOW PUMP 2 VSD FDR
SCHEMATIC DIAGRAM

SHEET	SCALE	DRG No.	REVISION
A1	NONE	2000-F16-SCM-EL-10137	1

O:\CAD PROJECTS\23517 NORTHERN STAR RESOURCES LTD\23517 KCGM GROWTH PROJECT\03 DELIVERABLES\ELV\F16 - ROUGHER & SCAVENGER FLOTATION\2000-F16-SCM-EL-10137.DWG 09SEP25 6:44AM HOTSEAT04