
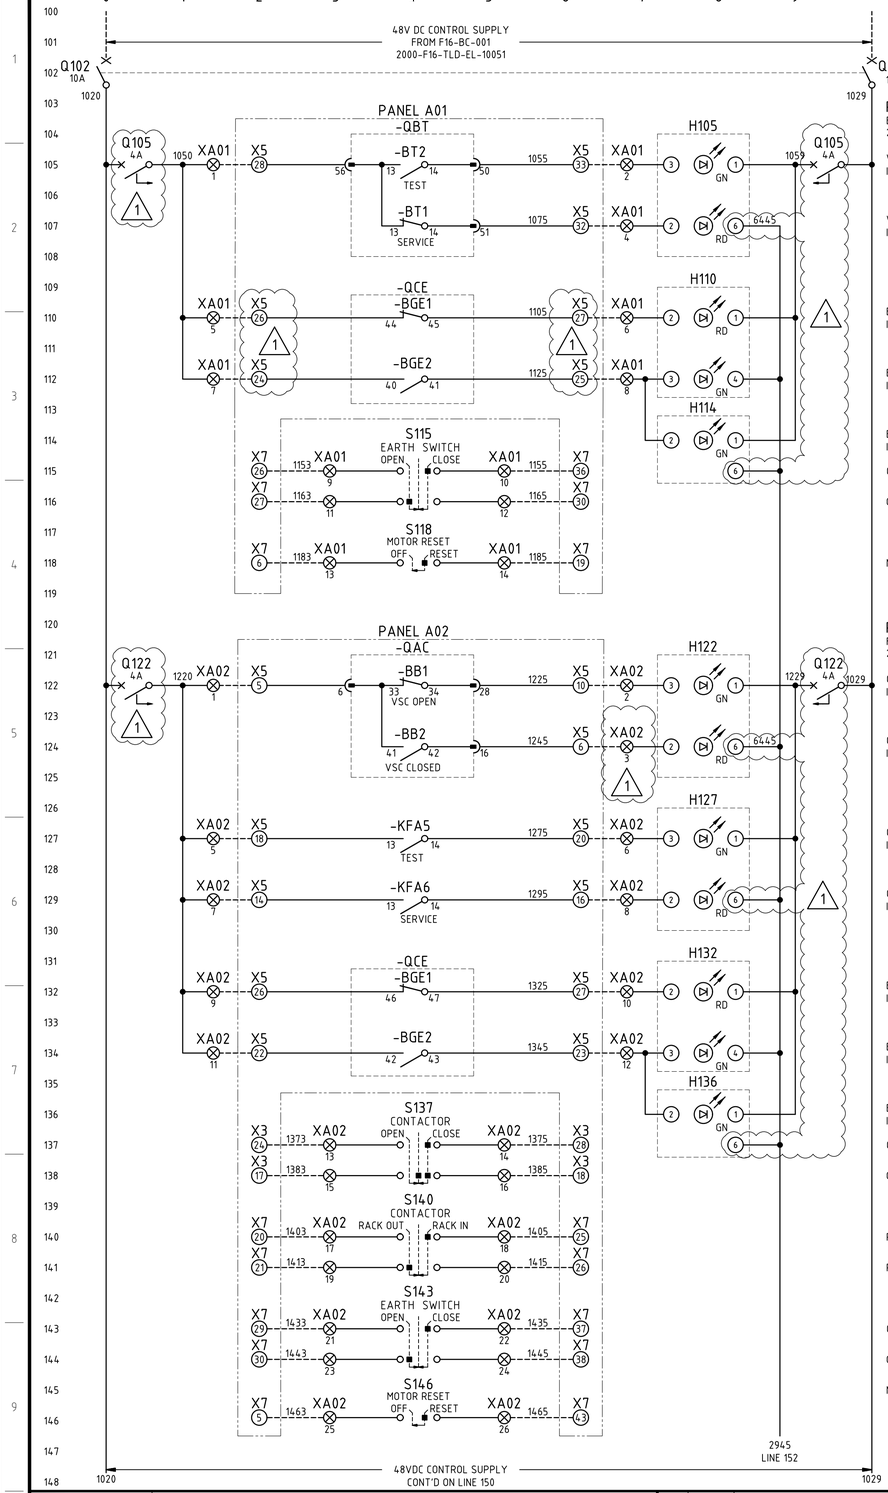


PANEL A01
BUS 1 VT & EARTH SWITCH
2000-EL003-F16-10006

- VT RACKED OUT INDICATION
- VT RACKED IN INDICATION
- EARTH SWITCH OPEN INDICATION
- EARTH SWITCH CLOSED INDICATION
- EARTH SYMBOL INDICATION
- CLOSE EARTH SWITCH COMMAND
- OPEN EARTH SWITCH COMMAND
- MOTOR RESET

PANEL A02
F16AG421-VS FEEDER
2000-EL003-F16-10016

- CONTACTOR OPEN INDICATION
- CONTACTOR CLOSED INDICATION
- CONTACTOR RACKED OUT INDICATION
- CONTACTOR RACKED IN INDICATION
- EARTH SWITCH OPEN INDICATION
- EARTH SWITCH CLOSED INDICATION
- EARTH SYMBOL INDICATION
- CLOSE CONTACTOR COMMAND
- OPEN CONTACTOR COMMAND
- RACK IN CONTACTOR COMMAND
- RACK OUT CONTACTOR COMMAND
- CLOSE EARTH SWITCH COMMAND
- OPEN EARTH SWITCH COMMAND
- MOTOR RESET

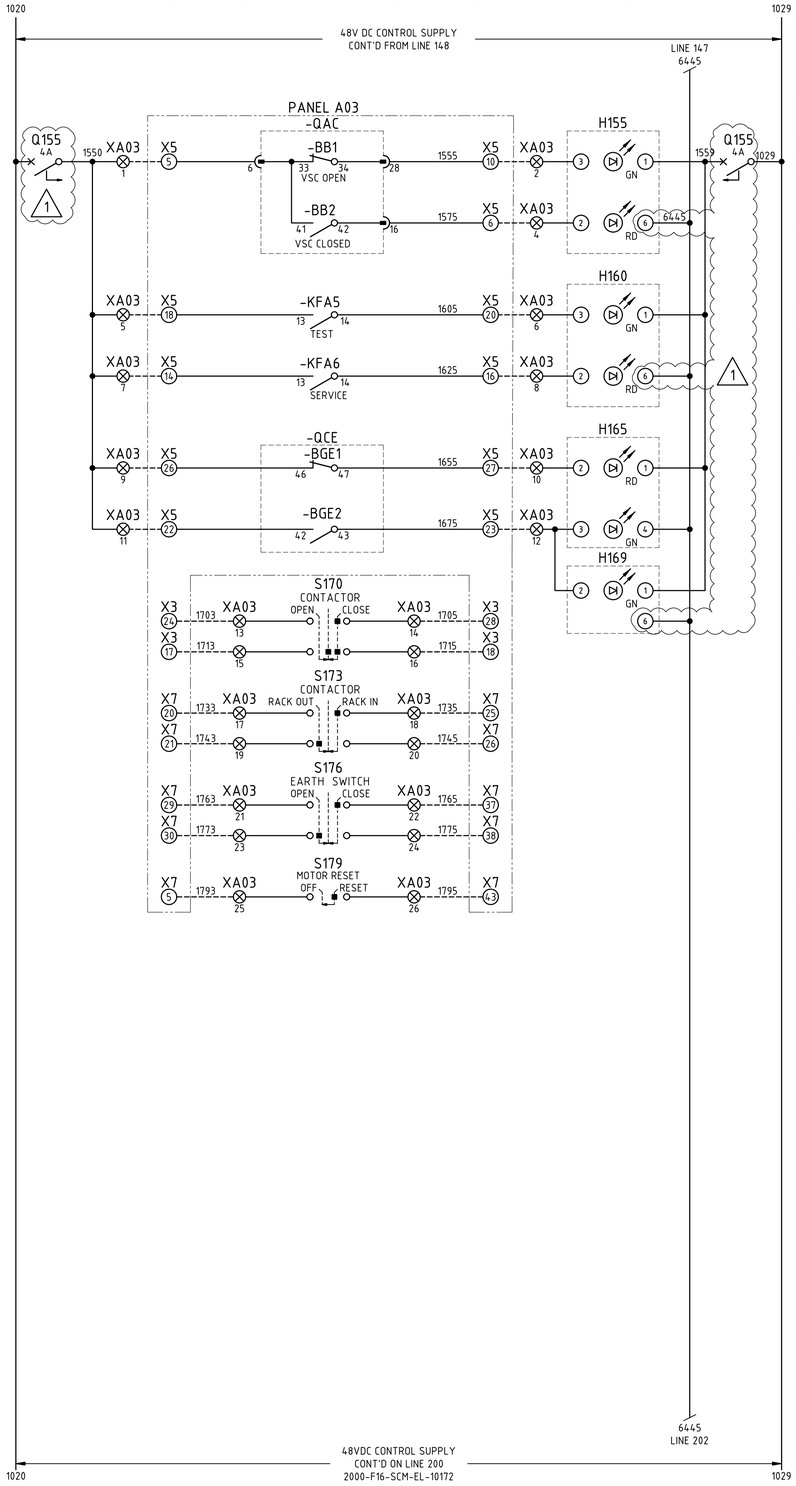

PANEL A03
F16AG422-VS
2000-EL003-F16-10016

- CONTACTOR OPEN INDICATION
- CONTACTOR CLOSED INDICATION
- CONTACTOR RACKED OUT INDICATION
- CONTACTOR RACKED IN INDICATION
- EARTH SWITCH OPEN INDICATION
- EARTH SWITCH CLOSED INDICATION
- EARTH SYMBOL INDICATION
- CLOSE CONTACTOR COMMAND
- OPEN CONTACTOR COMMAND
- RACK IN CONTACTOR COMMAND
- RACK OUT CONTACTOR COMMAND
- CLOSE EARTH SWITCH COMMAND
- OPEN EARTH SWITCH COMMAND
- EARTH SWITCH MOTOR RESET

NOTES

1. WIRE NUMBER FERRULES ON TERMINAL STRIP SHALL BE PREFIXED WITH EQUIPMENT NUMBER e.g. FxxPPxxx-1200, UNLESS OTHERWISE NOTED.
2. EACH WIRE SHALL BE IDENTIFIED AT BOTH ENDS WITH FERRULES.

LEGEND

- RSP TERMINAL
- HV SWITCHBOARD TERMINAL
- DEVICE TERMINAL

DRG No.	REFERENCES
2000-F16-DRG-EL-10053	F16SW011-LCS FLOTATION 11kV SWBD REMOTE SWITCHING PANEL LAYOUT
2000-F16-TER-EL-10171/4	F16SW011-LCS FLOTATION 11kV SWBD REMOTE SWITCHING PANEL TERMINATION DIAGRAM SHEET 1-4
2000-F16-SCM-EL-10171/9	F16SW011-LCS FLOTATION 11kV SWBD REMOTE SWITCHING PANEL SCHEMATIC DIAGRAM SHEET 1-9
2000-F16-SLD-EL-10001/3	F16-SW-011 FLOTATION 11kV SWBD SINGLE LINE DIAGRAM SHEET 1-3
2000-F00-STD-EL-10001	GENERAL NOTES AND STANDARD DRAWINGS INDEX

REV	DATE	DESCRIPTION	DRAW	CHECK	DESIGN	TECH APP	PROJ APP
1	29AUG25	FAT REDLINES INCORPORATED					
0	04NOV24	APPROVED FOR CONSTRUCTION					

NORTHERN STAR RESOURCES LIMITED

PRIMERO
primero.com.au | DESIGN | CONSTRUCT | OPERATE

PRIMERO PROJECT NUMBER: 23517

INFORMATION AND REPRESENTATIONS ON THIS DRAWING ARE THE INTELLECTUAL PROPERTY OF PRIMERO UNLESS SPECIFICALLY IDENTIFIED OTHERWISE. ALL RIGHTS INCLUDING USE RESERVED

PROJECT: NORTHERN STAR RESOURCES LTD
KCGM GROWTH PROJECT

TITLE: ROUGHER & SCAVENGER FLOTATION - F16SW011-LCS
11kV SWITCHBOARD REMOTE SWITCHING PANEL
SCHEMATIC DIAGRAM SHEET 1

SHEET	SCALE	DRG No.	REVISION
A1	NONE	2000-F16-SCM-EL-10171	1

O:\CAD PROJECTS\235 NORTHERN STAR RESOURCES LTD\23517 KCGM GROWTH PROJECT\03 DELIVERABLES\ELVF16 - ROUGHER & SCAVENGER FLOTATION\2000-F16-SCM-EL-10171.DWG 09SEP25 6:46AM HOTSEAT04