


F16-DB-001
FLOTATION
11kV SWITCHROOM
L&SP DISTRIBUTION BOARD
250 A

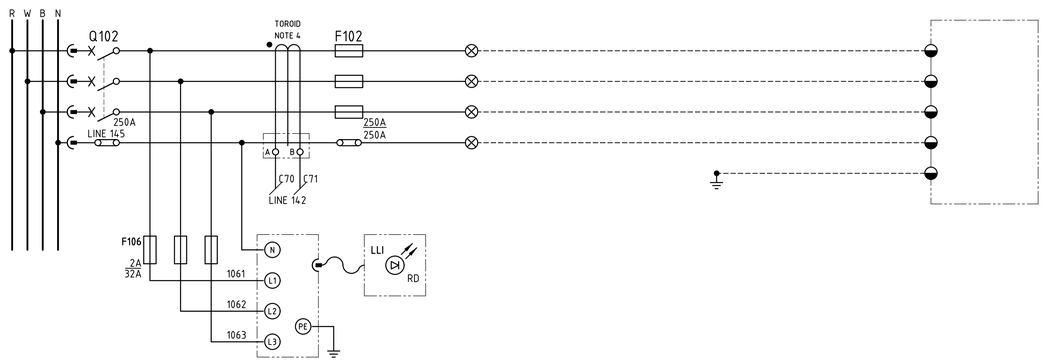




CABLE ZONE
24VDC TERMINALS

24VDC LOOPED POWER
NEXT MODULE
PREV MODULE

Q120	4A	2240
1		2250
2		2250
3		
4		
5		
6		
7		
8	⏚	EARTH

NOTE 2

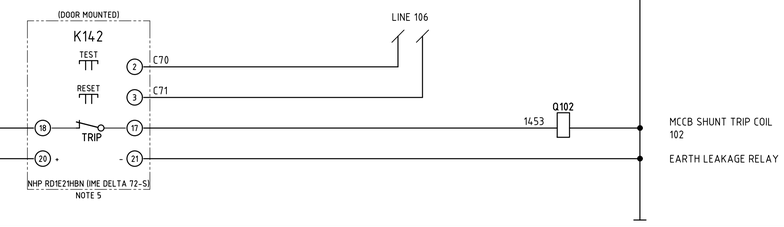


NOTES

1. TERMINALS ON TERMINAL STRIPS ABOVE 50VAC SHALL HAVE A SEPARATE PERSPEX SHROUD AND SHALL BE LABELLED "DANGER xxxVAC".
2. WIRE NUMBER FERRULES ON TERMINAL STRIP SHALL BE PREFIXED WITH EQUIPMENT NUMBER e.g. F16DB001-1200, UNLESS OTHERWISE NOTED.
3. EACH WIRE SHALL BE IDENTIFIED AT BOTH ENDS WITH FERRULES.
4. NHP TDGH2
   IN:90A IΔN MIN:0.03A TOROID TO SUIT CABLE DIAMETER.
5. EARTH LEAKAGE RELAY (ELV) USER INTERFACE TO BE MOUNTED ON MCC MODULE DOOR. RELAY ENERGISED (NORMALLY CLOSED CONTACT OPEN) IN NORMAL OPERATION.

LEGEND

00/01/00	DCS DIGITAL INPUT
00/02/00	DCS DIGITAL OUTPUT
⊗	MCC TERMINAL
◓	VSD TERMINAL
◒	FIELD TERMINAL
◑	DCS OR I/O TERMINAL
◧	MARSHALLING TERMINAL
⊗ x	DEVICE TERMINAL
⊗ cc	INDICATION LAMP cc = COLOUR

TERMINATION LEGEND

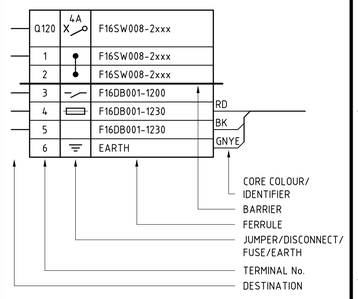

DRG No.	REFERENCES
2000-F16-SLD-EL-10221	F16-SW-008 415V EMERGENCY MCC SINGLE LINE DIAGRAM
2000-F00-STD-EL-10001	GENERAL NOTES AND STANDARD DRAWINGS INDEX

REV	DATE	DESCRIPTION	DRAW	CHECK	DESIGN	TECH APP	PROJ APP
2	07SEP26	KCGM GROWTH PROJECT - SP1 AS-BUILT					
1	26AUG25	FAT REDLINES INCORPORATED					
0	06SEP24	APPROVED FOR CONSTRUCTION					

NORTHERN STAR RESOURCES LIMITED

PRIMERO
primero.com.au | DESIGN | CONSTRUCT | OPERATE

PRIMERO PROJECT NUMBER: 23517

INFORMATION AND REPRESENTATIONS ON THIS DRAWING ARE THE INTELLECTUAL PROPERTY OF PRIMERO UNLESS SPECIFICALLY IDENTIFIED OTHERWISE. ALL RIGHTS INCLUDING USE RESERVED

PROJECT: NORTHERN STAR RESOURCES LTD
KCGM GROWTH PROJECT

TITLE: ROUGHER & SCAVENGER FLOTATION - F16-SW-008
F16-DB-001 FLOTATION 11kV SWRM L&SP DB
SCHEMATIC AND TERMINATION DIAGRAM

SHEET	SCALE	DRG No.	REVISION
A1	NONE	2000-F16-SCM-EL-10212	2

O:\CAD PROJECTS\235 NORTHERN STAR RESOURCES LTD\23517 KCGM GROWTH PROJECT\03 DELIVERABLES\EL\F16 - ROUGHER & SCAVENGER FLOTATION\2000-F16-SCM-EL-10212.DWG 04SEP26 3:28PM GRENVILLE.DEASY