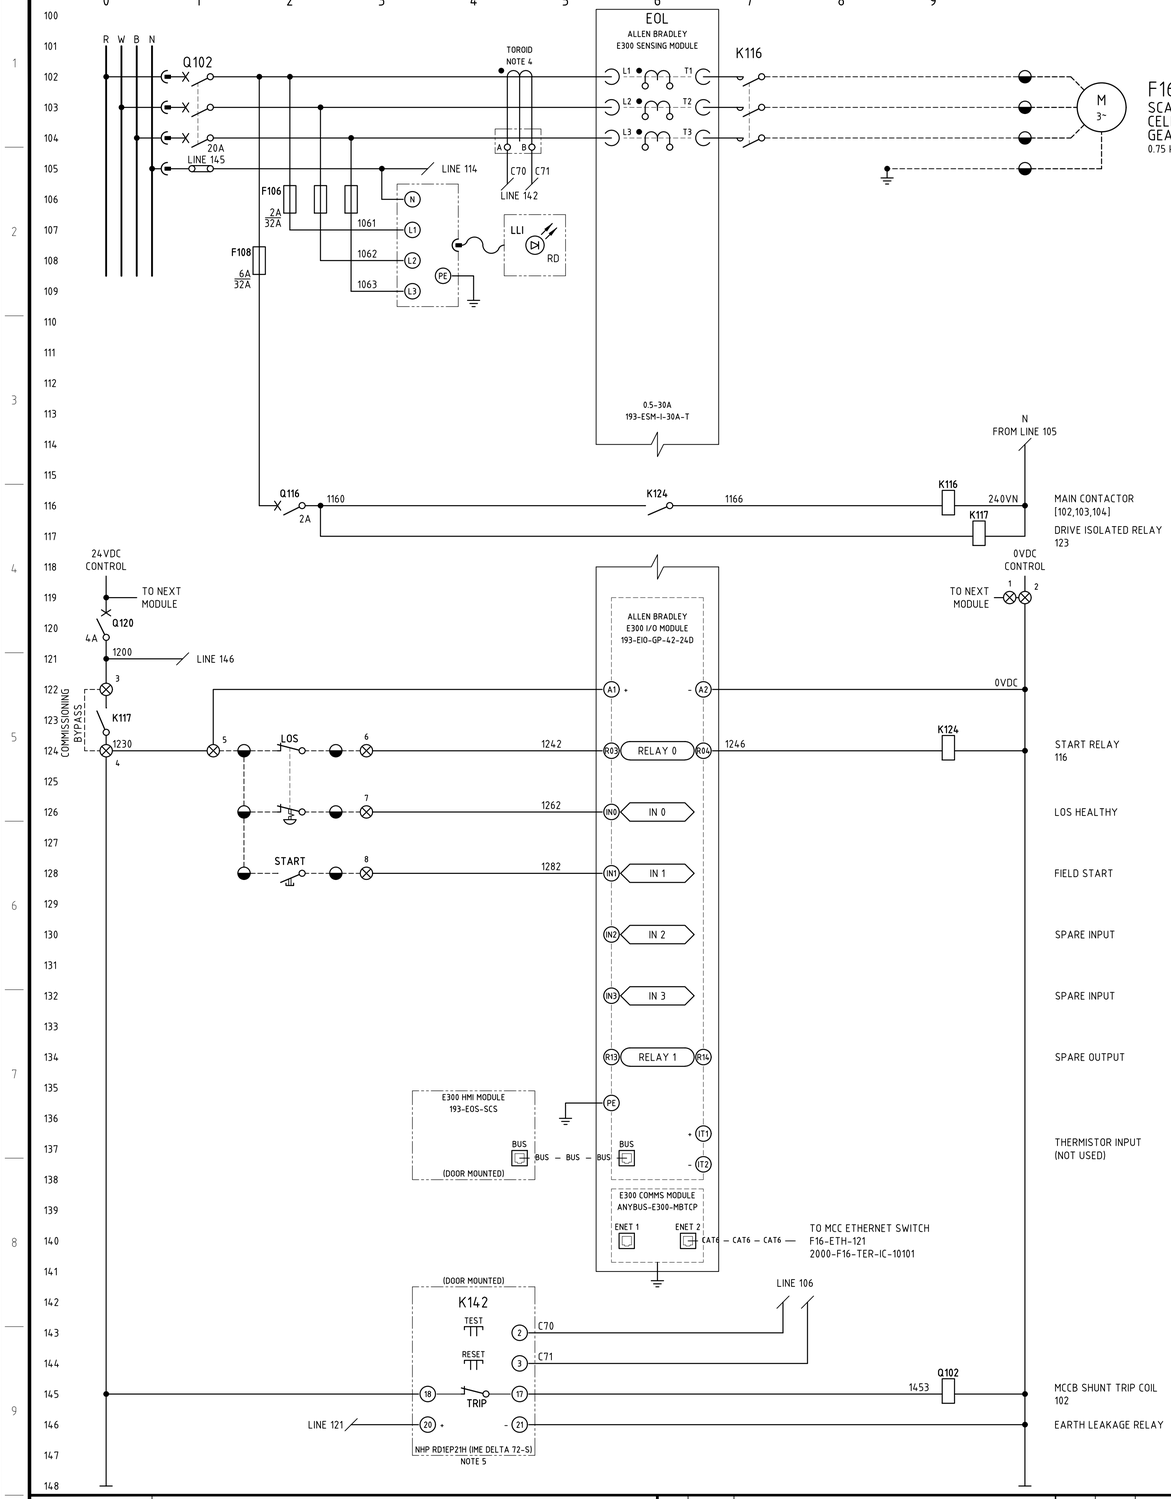


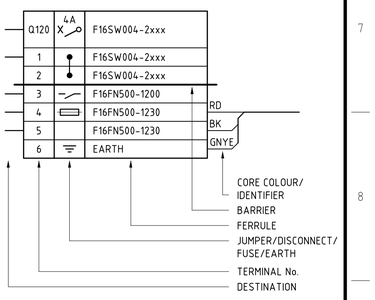

## NOTES

1. TERMINALS ON TERMINAL STRIPS ABOVE 50VAC SHALL HAVE A SEPARATE PERSPEX SHROUD AND SHALL BE LABELLED "DANGER xxxVAC".
2. WIRE NUMBER FERRULES ON TERMINAL STRIP SHALL BE PREFIXED WITH EQUIPMENT NUMBER e.g. F16FN500-1200, UNLESS OTHERWISE NOTED.
3. EACH WIRE SHALL BE IDENTIFIED AT BOTH ENDS WITH FERRULES.
4. NHP TDGB2
   IN:70A IΔN MIN:0.03A TOROID TO SUIT CABLE DIAMETER.
5. EARTH LEAKAGE RELAY (ELV) USER INTERFACE TO BE MOUNTED ON MCC MODULE DOOR. RELAY ENERGISED (NORMALLY CLOSED CONTACT OPEN) IN NORMAL OPERATION.

## LEGEND

- 00/01/00 — DCS DIGITAL INPUT
- 00/02/00 — DCS DIGITAL OUTPUT
- ⊗ — MCC TERMINAL
- ◕ — VSD TERMINAL
- ◒ — FIELD TERMINAL
- ◑ — DCS OR I/O TERMINAL
- ◧ — MARSHALLING TERMINAL
- (x) — DEVICE TERMINAL
- ⊗cc — INDICATION LAMP, cc = COLOUR

## TERMINATION LEGEND




| DRG No. | REFERENCES |
|---|---|
| 2000-F16-SLD-EL-10201 | F16-SW-004 415V MCC SINGLE LINE DIAGRAM SHEET 1 |
| 2000-F00-STD-EL-10001 | GENERAL NOTES AND STANDARD DRAWINGS INDEX |

| REV | DATE | DESCRIPTION | DRAW | CHECK | DESIGN | TECH APP | PROJ APP |
|---|---|---|---|---|---|---|---|
| 2 | 07SEP26 | KCGM GROWTH PROJECT - SP1 AS-BUILT | | | | | |
| 1 | 26AUG25 | FAT REDLINES INCORPORATED | | | | | |
| 0 | 12AUG24 | APPROVED FOR CONSTRUCTION | | | | | |

NORTHERN STAR RESOURCES LIMITED

PRIMERO
primero.com.au | DESIGN | CONSTRUCT | OPERATE

PRIMERO PROJECT NUMBER: 23517

INFORMATION AND REPRESENTATIONS ON THIS DRAWING ARE THE INTELLECTUAL PROPERTY OF PRIMERO UNLESS SPECIFICALLY IDENTIFIED OTHERWISE. ALL RIGHTS INCLUDING USE RESERVED

PROJECT: NORTHERN STAR RESOURCES LTD
KCGM GROWTH PROJECT

TITLE: ROUGHER & SCAVENGER FLOTATION - F16-SW-004
F16-FN-500 SCAVENGER FLOT CELL 1 GB COOLING FAN
SCHEMATIC DIAGRAM

| SHEET | SCALE | DRG No. | REVISION |
|---|---|---|---|
| A1 | NONE | 2000-F16-SCM-EL-10242 | 2 |

O:\CAD PROJECTS\235 NORTHERN STAR RESOURCES LTD\23517 KCGM GROWTH PROJECT\03 DELIVERABLES\ELV\F16 - ROUGHER & SCAVENGER FLOTATION\2000-F16-SCM-EL-10242.DWG 03SEP26 10:48AM ROBIN.LAW