
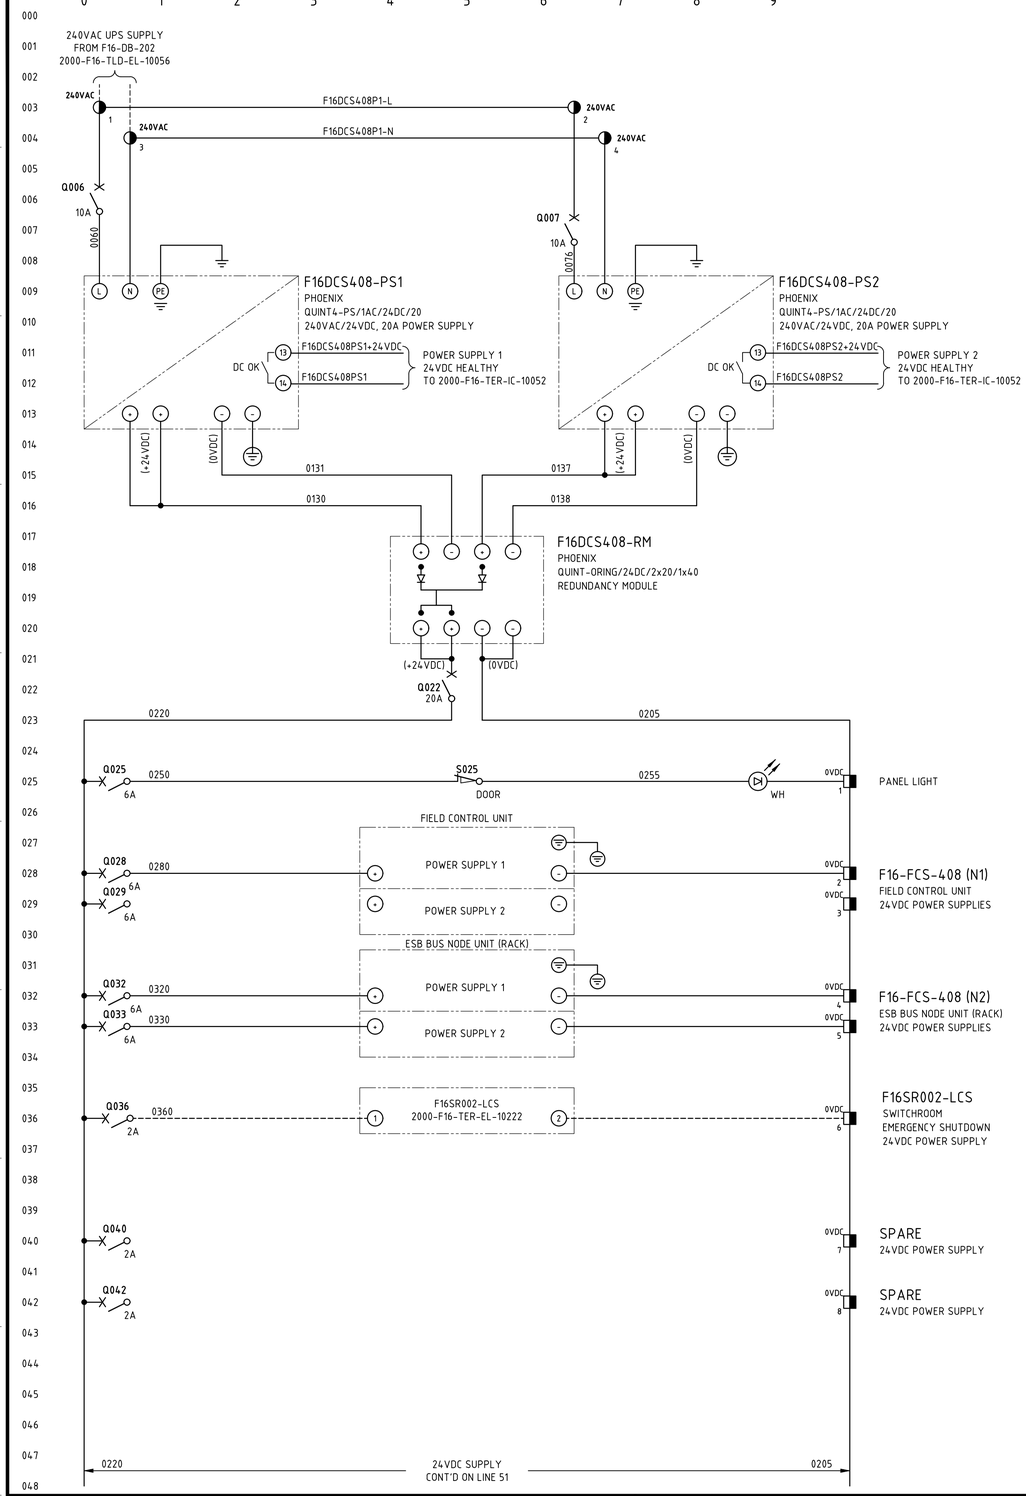


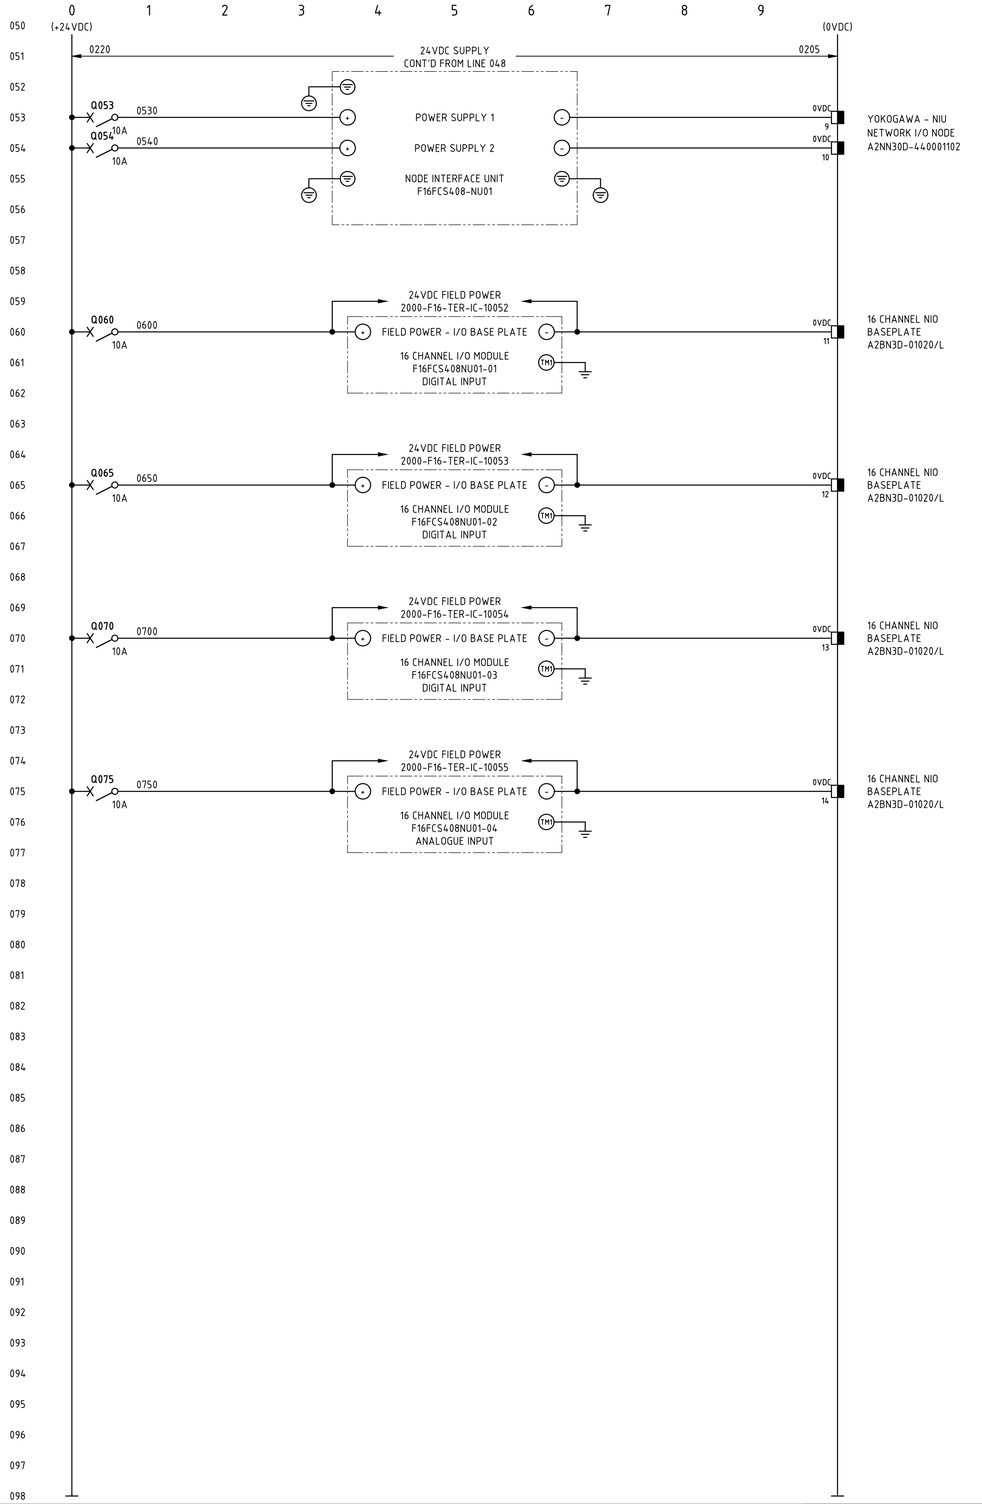


NOTES

1. TERMINALS ON TERMINAL STRIPS ABOVE 50VAC SHALL HAVE A SEPARATE PERSPEX SHROUD AND SHALL BE LABELLED "DANGER xxxVAC".
2. WIRE NUMBER FERRULES ON TERMINAL STRIP SHALL BE PREFIXED WITH EQUIPMENT NUMBER e.g. F16DCS405-xxxx.
3. EACH WIRE SHALL BE IDENTIFIED AT BOTH ENDS WITH FERRULES.
4. FOR NETWORK CONNECTION & BUS CABLING DETAILS REFER TO DCS PANEL COMMUNICATIONS TERMINATION DIAGRAMS.
5. INSTRUMENT EARTH BAR TO BE BONDED TO MAIN EARTH BAR WITH SOLID COPPER LINK.

LEGEND

- FIELD TERMINAL
- DCS OR I/O TERMINAL
- 0VDC TERMINAL FOR 24VDC
- DEVICE TERMINAL
- INDICATION LAMP, cc = COLOUR
- EARTH BAR
- INSTRUMENT EARTH BAR

NIO BASEPLATE

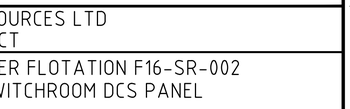

DRG No.	REFERENCES
2000-F16-TLD-EL-10056	F16-DB-202 LV SWITCHROOM 415V UPS DB THREE LINE DIAGRAM
2000-F16-DRG-IC-10051	F16-DCS-408 415V SWITCHROOM DCS PANEL GENERAL ARRANGEMENT
2000-F16-TER-IC-10051	F16-DCS-408 415V SWITCHROOM DCS PANEL COMMUNICATIONS TERMINATION DIAGRAM
2000-F16-TER-IC-10052	F16-DCS-408 415V SWITCHROOM DCS PANEL TERMINATION DIAGRAMS SHEET 1 (TO SHEET 4 - 10055)
2000-F00-STD-EL-10001	GENERAL NOTES AND STANDARD DRAWINGS INDEX

REV	DATE	DESCRIPTION	DRAW	CHECK	DESIGN	TECH APP	PROJ APP
3	07SEP26	KCGM GROWTH PROJECT - SP1 AS-BUILT					
2	26AUG25	FAT REDLINES INCORPORATED					
1	12DEC24	REVISED E-SHUT LCS DETAILS					
0	10OCT24	APPROVED FOR CONSTRUCTION					

NORTHERN STAR RESOURCES LIMITED

PRIMERO
primero.com.au | DESIGN | CONSTRUCT | OPERATE

PRIMERO PROJECT NUMBER: 23517

INFORMATION AND REPRESENTATIONS ON THIS DRAWING ARE THE INTELLECTUAL PROPERTY OF PRIMERO UNLESS SPECIFICALLY IDENTIFIED OTHERWISE. ALL RIGHTS INCLUDING USE RESERVED

PROJECT: NORTHERN STAR RESOURCES LTD
KCGM GROWTH PROJECT

TITLE: ROUGHER & SCAVENGER FLOTATION F16-SR-002
F16-DCS-408 415V SWITCHROOM DCS PANEL
SCHEMATIC DIAGRAM

SHEET	SCALE	DRG No.	REVISION
A1	NONE	2000-F16-SCM-IC-10051	3

O:\CAD PROJECTS\235 NORTHERN STAR RESOURCES LTD\235I7 KCGM GROWTH PROJECT\03 DELIVERABLES\IC\F16 - ROUGHER & SCAVENGER FLOTATION\2000-F16-SCM-IC-10051.DWG 03SEP26 2:08PM ROBINLAW