
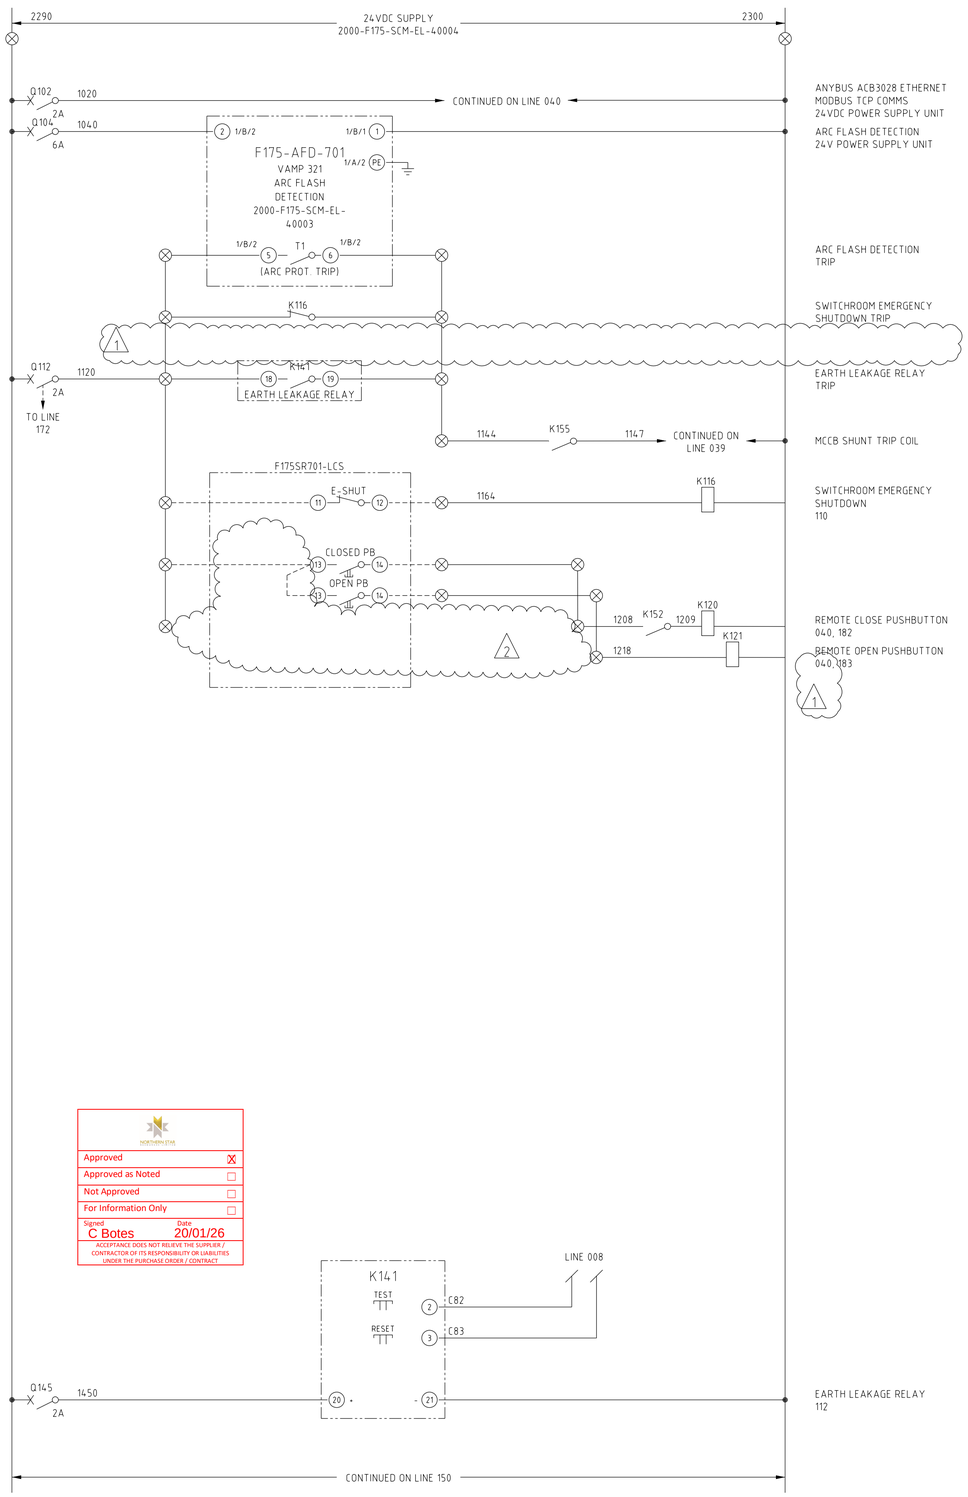


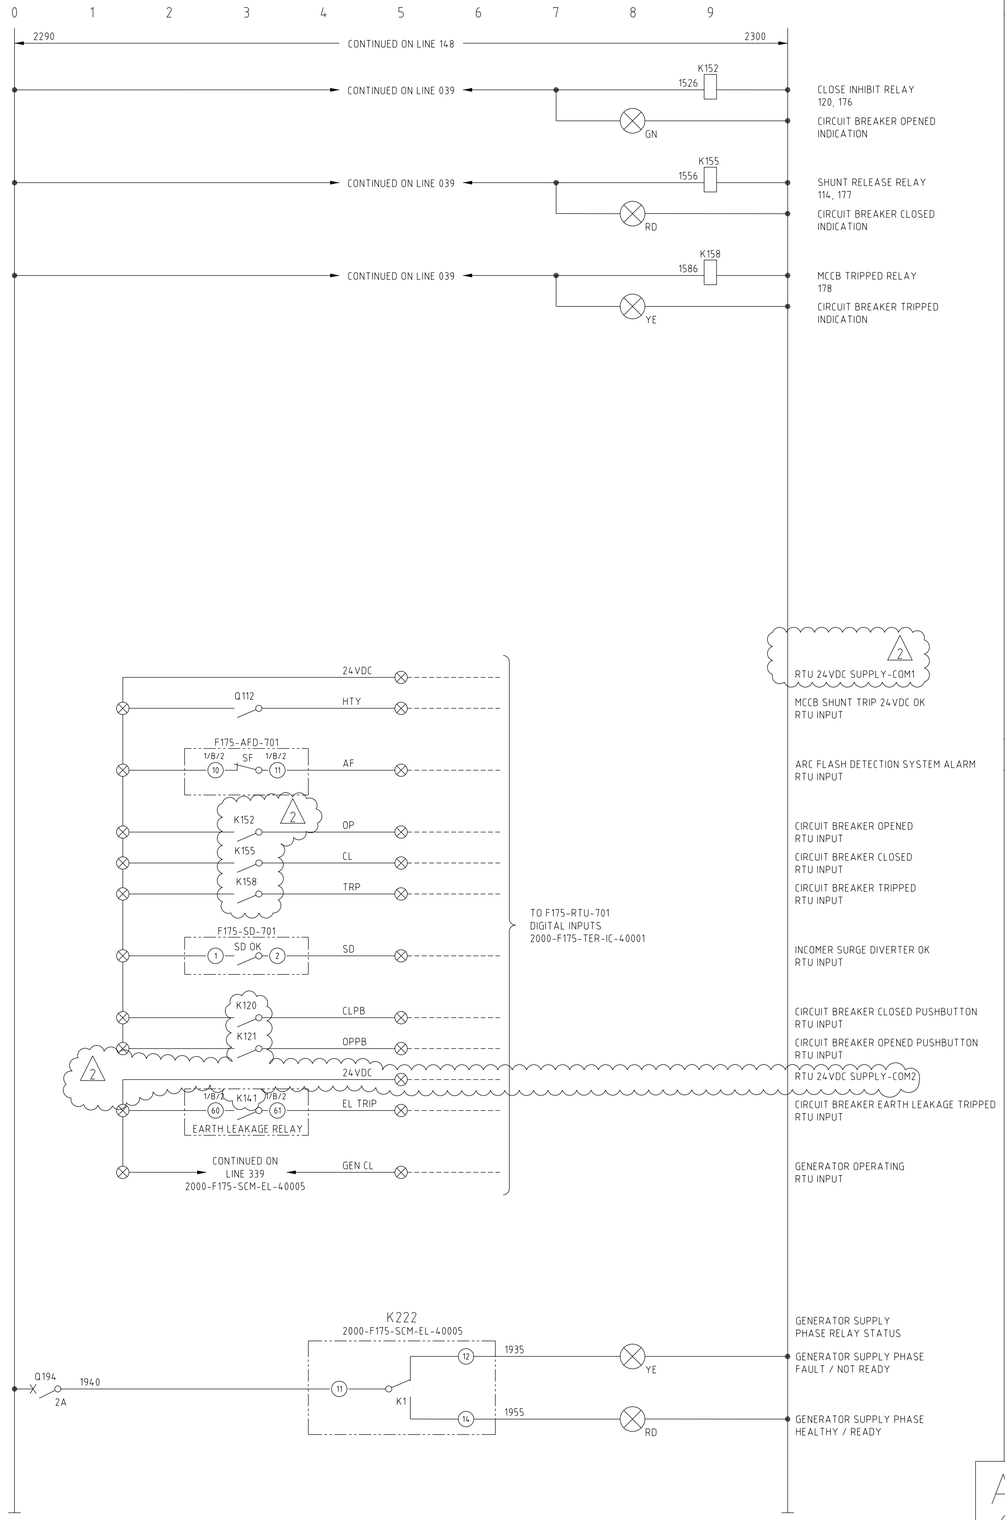

NOTES

1. REFER TO INCOMER SCHEMATIC DIAGRAM SHEET 1 FOR NOTES.
2. UPSTREAM FEEDER TRIP DETAILS TBC.

LEGEND

- 00/01/00 — DCS DIGITAL INPUT
- 00/02/00 — DCS DIGITAL OUTPUT
- MCC TERMINAL
- VSD TERMINAL
- FIELD TERMINAL
- DCS OR I/O TERMINAL
- MARSHALLING TERMINAL
- DEVICE TERMINAL
- INDICATION LAMP (cc = COLOUR)

NORTHERN STAR

Approved	X
Approved as Noted	
Not Approved	
For Information Only	

Signed C Botes Date 20/01/26

ACCEPTANCE DOES NOT RELIEVE THE SUPPLIER / CONTRACTOR OF ITS RESPONSIBILITY OR LIABILITIES UNDER THE PURCHASE ORDER / CONTRACT

APPROVED FOR CONSTRUCTION

REFERENCES	DWG No	REV	DATE	REVISION
F175-SW-701 LV MOTOR CONTROL CENTER INCOMER SCHEMATIC DIAGRAM SHEET 3	2000-F175-SCM-EL-40005	2	15.DEC.25	RE-APPROVED FOR CONSTRUCTION
F175-SW-701 LV MOTOR CONTROL CENTER INCOMER SCHEMATIC DIAGRAM SHEET 1	2000-F175-SCM-EL-40001	1	04.DEC.25	RE-ISSUED FOR CONSTRUCTION
F175-SW-701 LV MOTOR CONTROL CENTER SINGLE LINE DIAGRAM	2000-F175-SLD-EL-40001	0	21.MAY.25	APPROVED FOR CONSTRUCTION

	DRN	CHK	TECH APP	APP
Initial		DS		DS

NORTHERN STAR RESOURCES LIMITED

DRA PACIFIC (PTY) LIMITED

[redacted]	[redacted]	13.MAR.2025
CHECKED	[redacted]	10.APR.2025
DESIGNED	[redacted]	10.APR.2025
TECH APP	[redacted]	10.APR.2025
[redacted]APP	[redacted]	21.MAY.2025
CLIENT APP		

PROJECT: KCGM
FIM TSF PROJECT

TITLE: SOUTHLAKES BOOSTER STATION
F175-SW-701 LV MCC MAIN INCOMER
SCHEMATIC DIAGRAM SHEET 2

A1 | SCALE NTS | DRG No 2000-F175-SCM-EL-40002 | REV 2