
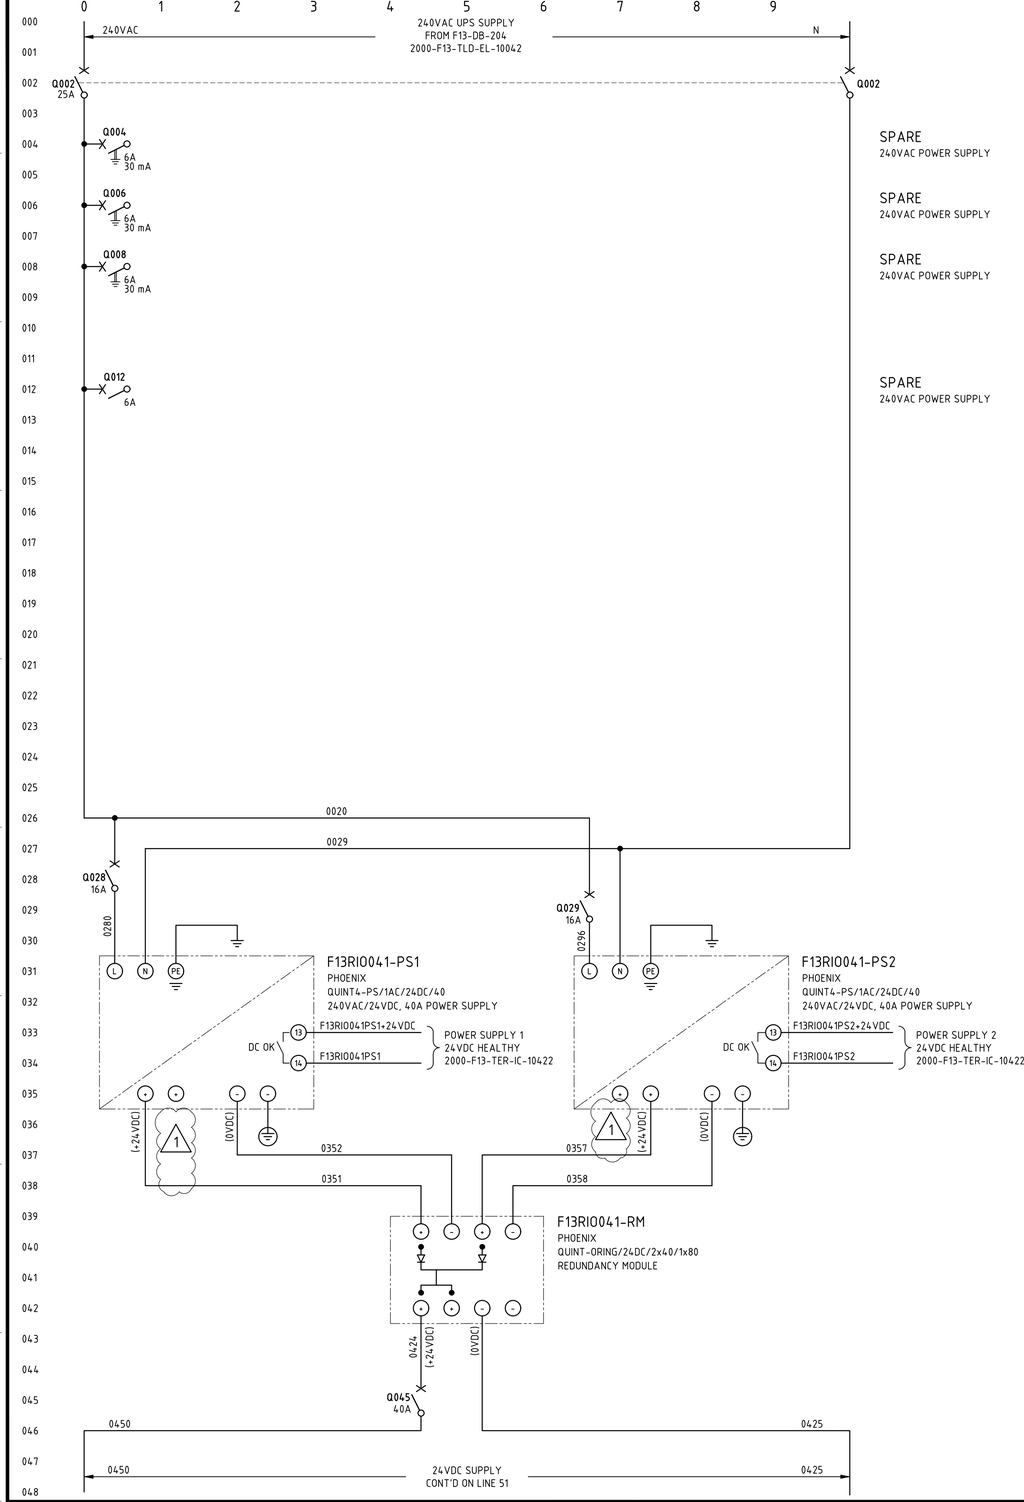


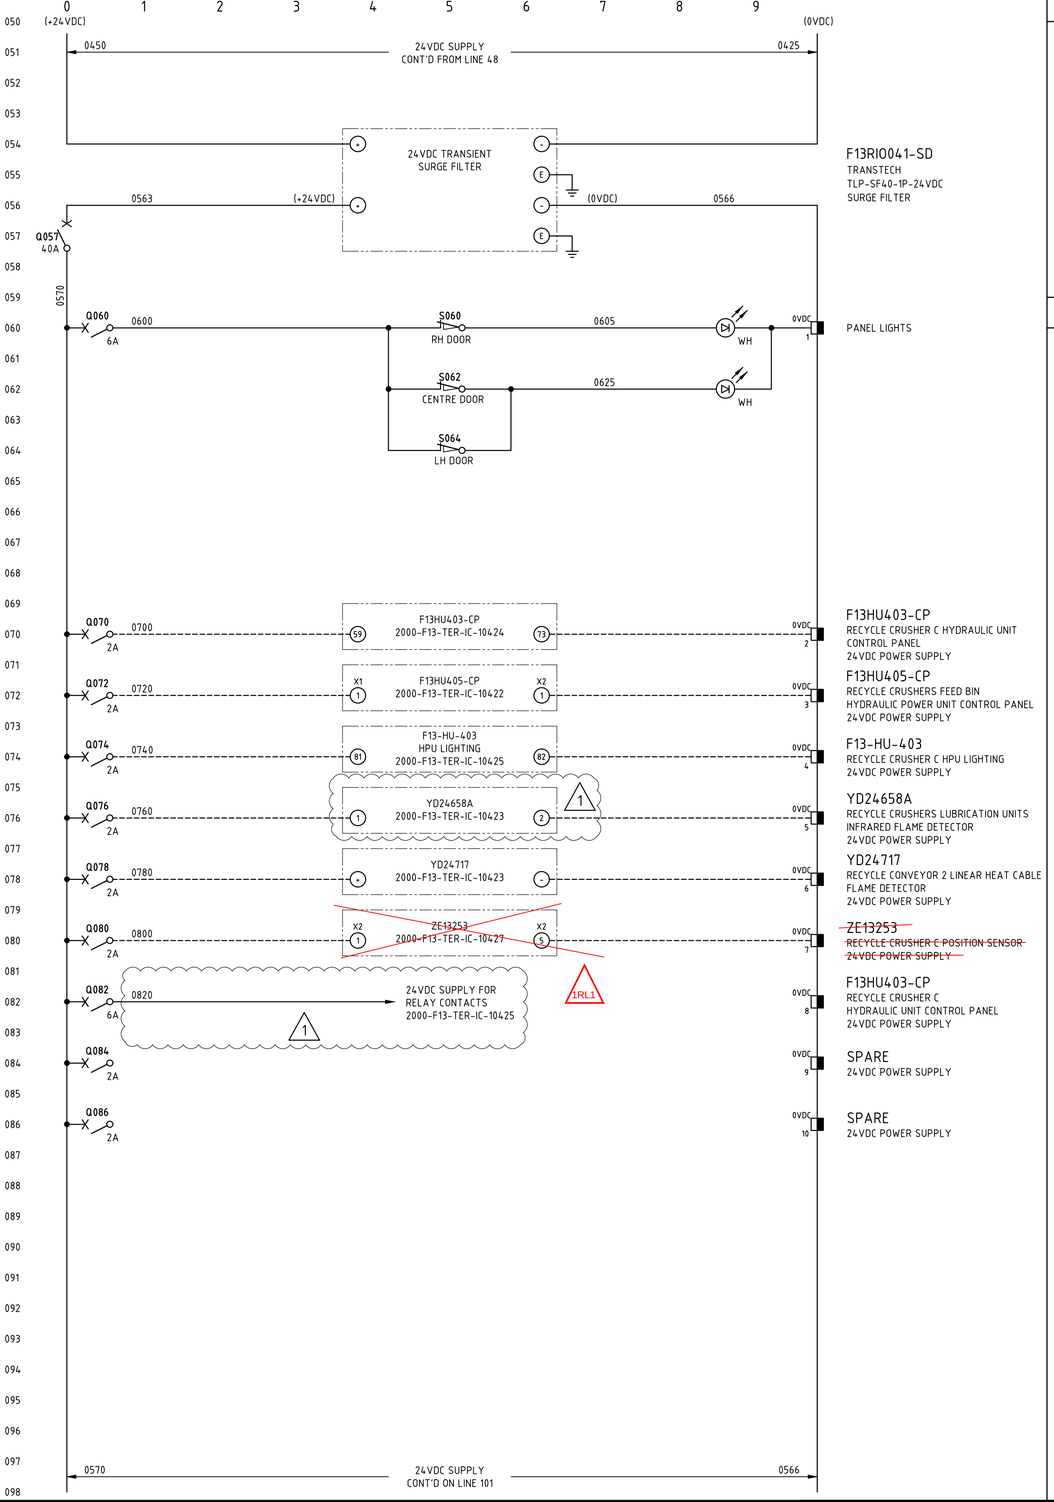

NOTES

1. TERMINALS ON TERMINAL STRIPS ABOVE 50VAC SHALL HAVE A SEPARATE PERSPEX SHROUD AND SHALL BE LABELLED "DANGER xxxVAC".
2. WIRE NUMBER FERRULES ON TERMINAL STRIP SHALL BE PREFIXED WITH EQUIPMENT NUMBER e.g. F13RI0041-xxxx.
3. EACH WIRE SHALL BE IDENTIFIED AT BOTH ENDS WITH FERRULES.
4. FOR NETWORK CONNECTION & BUS CABLING DETAILS REFER TO RIO PANEL COMMUNICATIONS TERMINATION DIAGRAMS.
5. INSTRUMENT EARTH BAR TO BE BONDED TO MAIN EARTH BAR WITH SOLID COPPER LINK.

LEGEND

- FIELD TERMINAL
- DCS OR I/O TERMINAL
- 0VDC TERMINAL FOR 24VDC
- 0VDC TERMINAL FOR 54VDC
- DEVICE TERMINAL
- INDICATION LAMP (cc = COLOUR)
- EARTH BAR
- INSTRUMENT EARTH BAR

AS CONSTRUCTED

CHANGE: ☒ NO CHANGE: ☐

SIGNATURE: Karl Whitelaw
NAME: Karl Whitelaw
DATE: 27 / 10 / 25

ENGINEER SIGN OFF

SIGNATURE: Jordan Peace
NAME: Jordan Peace
DATE: 27 / 10 / 25

DRG No.	REFERENCES
2000-F13-TLD-EL-10042	F13-DB-204 SWITCHROOM 240V UPS DB THREE LINE DIAGRAM
2000-F13-DRG-IC-10421	F13-RIO-041 FIELD N-IO PANEL GENERAL ARRANGEMENT
2000-F13-SCM-IC-10422	F13-RIO-041 FIELD N-IO PANEL SCHEMATIC DIAGRAM SHEET 2
2000-F13-TER-IC-10420	F13-RIO-041 FIELD N-IO PANEL COMMUNICATIONS TERMINATION DIAGRAM SHEET 1 (TO SHEET 2 - 10421)
2000-F13-TER-IC-10422	F13-RIO-041 FIELD N-IO PANEL TERMINATION DIAGRAM SHEET 1 (TO SHEET 9 - 10430)
2000-F00-STD-EL-10001	GENERAL NOTES AND STANDARD DRAWINGS INDEX

REV	DATE	DESCRIPTION
1RL1	17OCT25	AS CONSTRUCTED FOR SP1
1	05MAY25	FAT REDLINES INCORPORATED
0	04FEB25	APPROVED FOR CONSTRUCTION

[redacted]

DRAW | CHECK | DESIGN | TECH APP | PROJ APP

NORTHERN STAR RESOURCES LIMITED

PRIMERO
primero.com.au | DESIGN | CONSTRUCT | OPERATE

PRIMERO PROJECT NUMBER: 23517

INFORMATION AND REPRESENTATIONS ON THIS DRAWING ARE THE INTELLECTUAL PROPERTY OF PRIMERO UNLESS SPECIFICALLY IDENTIFIED OTHERWISE. ALL RIGHTS INCLUDING USE RESERVED

PROJECT: NORTHERN STAR RESOURCES LTD
KCGM GROWTH PROJECT

TITLE: MILLING & CLASSIFICATION - RECYCLE CRUSHING
F13-RIO-041 RECYCLE CRUSHING FIELD N-IO PANEL
SCHEMATIC DIAGRAM SHEET 1

SHEET	SCALE	DRG No.	REVISION
A1	NONE	2000-F13-SCM-IC-10421	1RL1

O:\CAD PROJECTS\235 NORTHERN STAR RESOURCES LTD\23517 KCGM GROWTH PROJECT\03 DELIVERABLES\IC\F13 - MILLING & CLASSIFICATION\2000-F13-SCM-IC-10421.DWG 05MAY25 8:18AM SANDRA CULL