

Docusign Envelope ID: D3EAC8FF-146A-4610-AFF4-26203B4BB02C

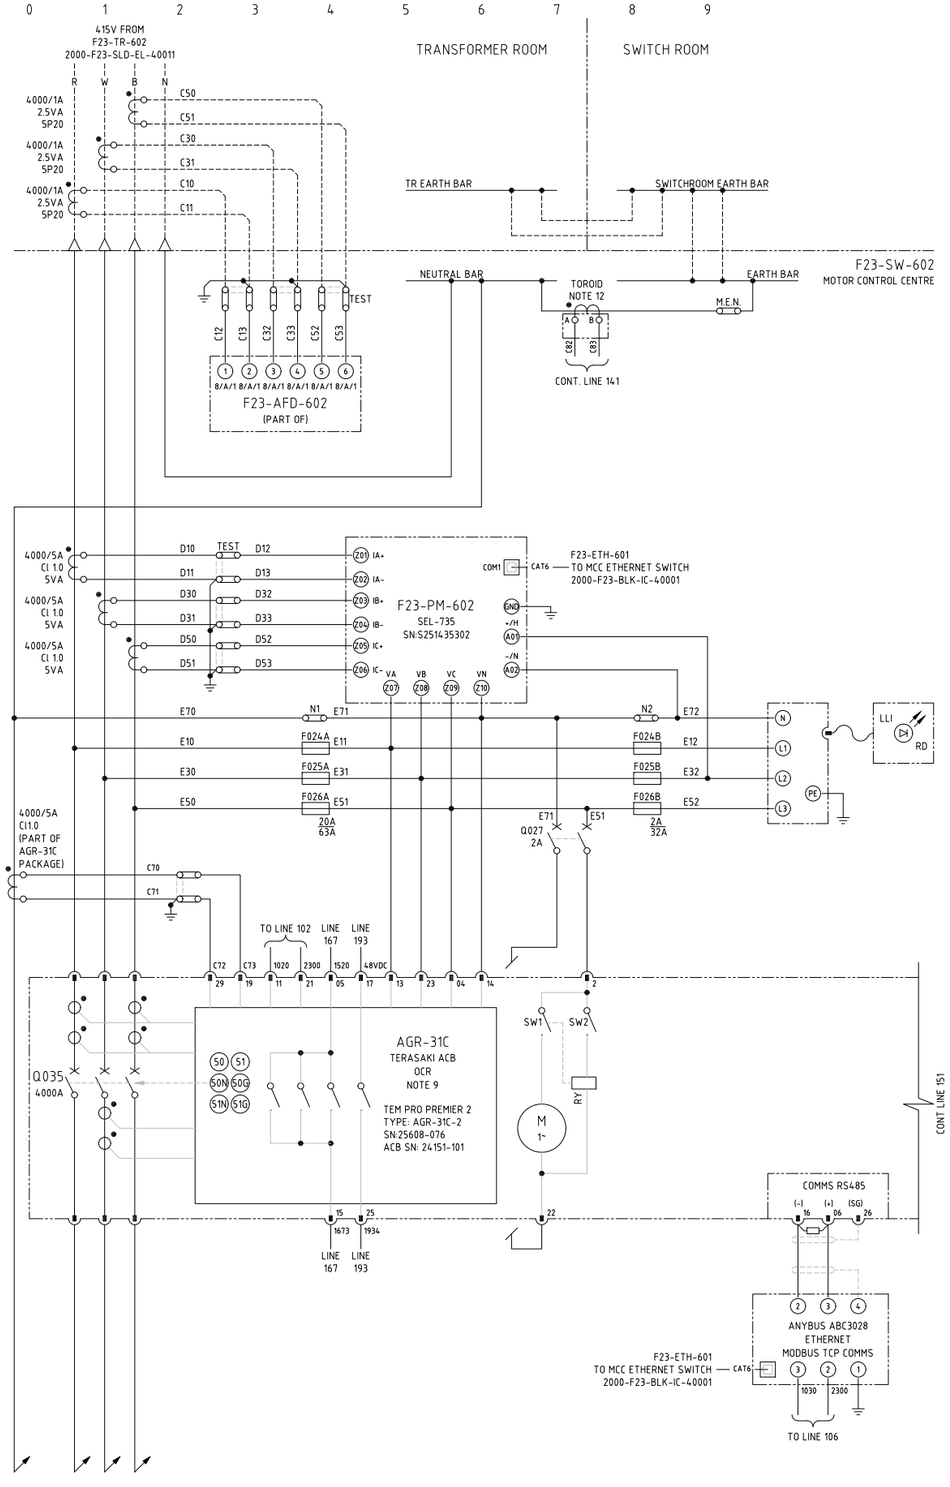

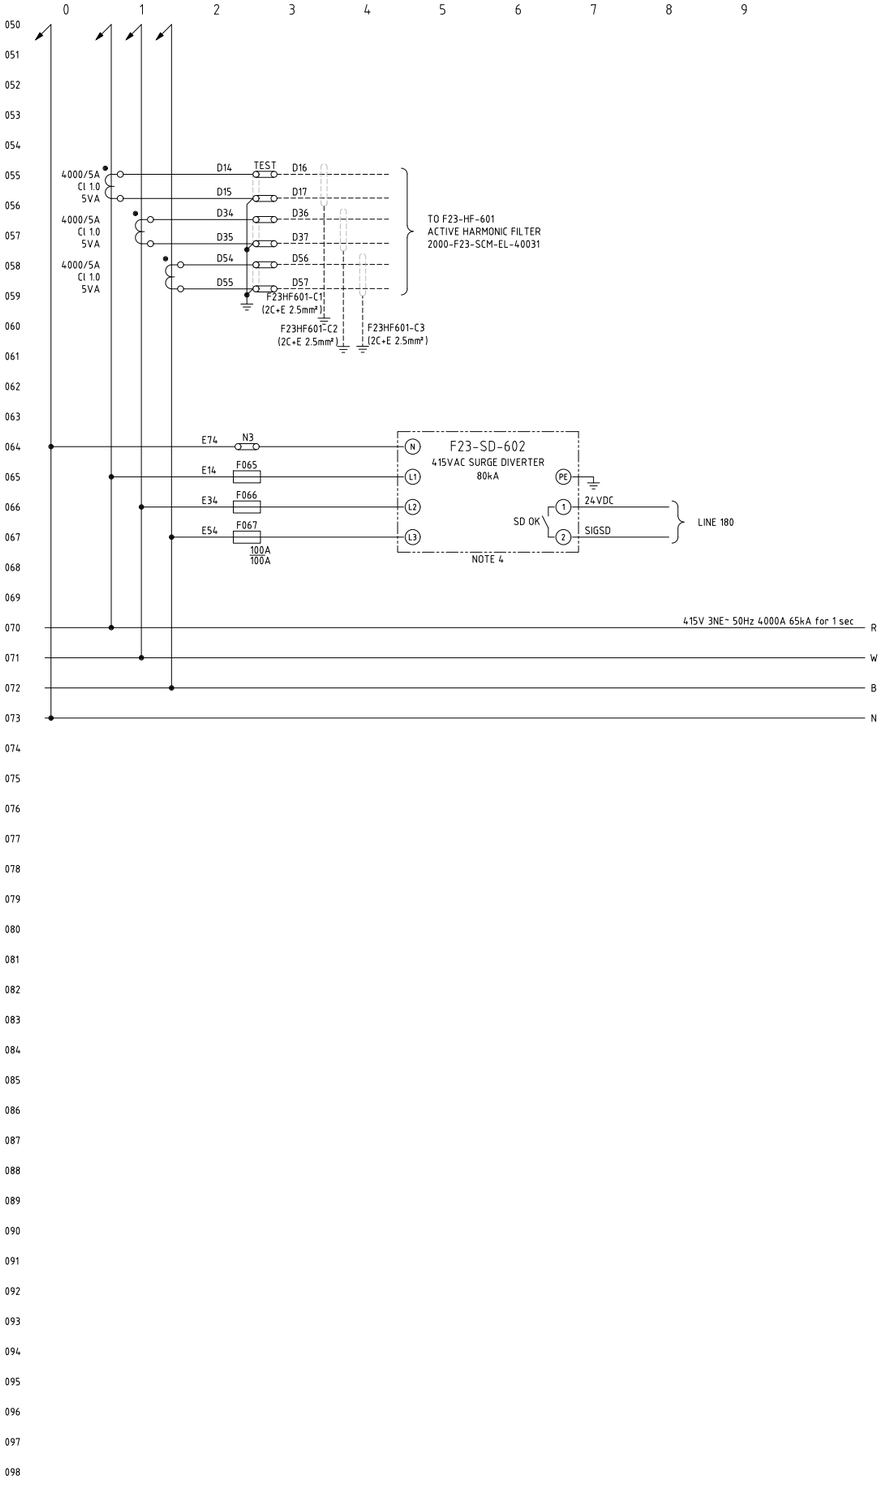

NOTES

1. EARTH-NEUTRAL LINK SHALL BE INSTALLED IN INCOMER TIER. SIGNAGE SHALL BE PLACED ON MCC AND ON TRANSFORMER READING "M.E.N. LINK LOCATED IN F23-SW-602 INCOMER TIER" CABLE SHALL BE IDENTIFIED C/W LABEL STATING "M.E.N. LINK - DO NOT REMOVE".
2. UPSTREAM TRANSFORMER FEEDER SHALL BE TRIPPED ON ACTIVATION OF SWITCHROOM EMERGENCY PUSHBUTTON, DETECTION OF EARTH FAULT OR ARC FAULT FOR INCOMER ZONE. 415VAC MCC INCOMER TO BE TRIPPED FOR BUSBAR, OUTGOING MODULE AND OUTGOING CABLE ZONE ARC FAULTS.
3. ALL CIRCUIT BREAKER STATUS VIA DRY CONTACT TO DCS CUBICLE.
4. SURGE DIVERTERS SHALL PROVIDE FEEDBACK TO DCS VIA VOLT-FREE CONTACTS. SURGE DIVERTER FUSES SHALL BE SIZED BY VENDOR TO SUIT DUTY.
5. MINIATURE CIRCUIT BREAKERS SHALL BE SIZED AND RATED TO SUIT ACB AND INCOMER REQUIREMENTS.
6. ALL TERMINATIONS ABOVE 50VAC SHALL BE TO IP2x OR ABOVE, IF NOT, TO HAVE A SEPARATE PERSPEX SHROUD FITTED AND SHALL BE LABELLED "DANGER xxxVAC".
7. WIRE NUMBER FERRULES ON TERMINAL STRIP SHALL BE PREFIXED WITH EQUIPMENT NUMBER e.g. F23SW602-0600.
8. EACH WIRE SHALL BE IDENTIFIED AT BOTH ENDS WITH FERRULES.
9. SPLIT CIRCUIT BETWEEN LATCH RELEASE COIL (LRC), MODBUS OPEN/ CLOSE, RACKING MOTOR AND UNDER VOLTAGE TRIP OPTION TO BE SPECIFIED WHEN ORDERING.
10. REMOTE CIRCUIT BREAKER OPEN/ CLOSE AND CIRCUIT BREAKER RACKING FROM DCS IS DISABLED: THIS FEATURE MAY BE ENABLED BY NSR IN THE FUTURE.
11. ALL CIRCUIT BREAKER PROTECTION, ARC FLASH DETECTION (AFD) AND POWER METER STATUS VIA MODBUS TCP FOR COMMUNICATION BLOCK DIAGRAM REFER 2000-F23-BLK-IC-40001.
12. EARTH LEAKAGE RELAY USER INTERFACE TO BE MOUNTED ON MCC MODULE DOOR.
    TOROID DETAILS
    TDGC2
    SN:0286850154
    IN:170A
13. PHASE CT's FOR ARC FLASH DETECTION PROTECTION AND CURRENT SUPERVISION LOCATED IN UPSTREAM DRY TRANSFORMER ENCLOSURE TO AVOID AND MCC 'BLIND SPOT' FOR CURRENT SUPERVISED LIGHT SENSOR BASED SCHEME.
14. CT DETAILS:

	R	W	B
POWER MONITOR CTs			
RATIO	4000/5A	4000/5A	4000/5A
BURDEN	30,50(VA)	30,50(VA)	30,50(VA)
CLASS	0.5,1	0.5,1	0.5,1
SN	8913330188	9655750008	9655750021
ACB NEUTRAL CTs			
RATIO	4000/5A	4000/5A	4000/5A
BURDEN	5VA	5VA	5VA
CLASS	1.0	1.0	1.0
SN	80121-04	80121-04	80121-04
HARMONIC FILTEER CTs			
RATIO	4000/5A	4000/5A	4000/5A
BURDEN	30,50(VA)	30,50(VA)	30,50(VA)
CLASS	0.5,1	0.5,1	0.5,1
SN	893330072	8913330027	8913330164

LEGEND

- 00/01/00 — DCS DIGITAL INPUT
- 00/02/00 — DCS DIGITAL OUTPUT
- ⊗ — MCC TERMINAL
- ◓ — VSD TERMINAL
- ◒ — FIELD TERMINAL
- ◑ — DCS OR I/O TERMINAL
- ◨ — MARSHALLING TERMINAL
- (x) — DEVICE TERMINAL
- ⊗cc — INDICATION LAMP cc = COLOUR

AS BUILT

REFERENCES	DWG No	REV	DATE	REVISION	DRN	CHK	APP
LV MCC INCOMER SCHEMATIC DIAGRAM SHT 2 OF 2	2000-F23-SCH-EL-40012	2	[redacted]26	AS BUILT FOR FIM III TSF	MZ	[redacted]	MC [redacted]
F23-SW-602 LV MCC SINGLE LINE DIAGRAM SHT 2 OF 2	2000-F23-SLD-EL-40012	1	07.JUL.25	RE-APPROVED FOR CONSTRUCTION	TG	KVN	KVN
F23-SW-602 LV MCC SINGLE LINE DIAGRAM SHT 1 OF 2	2000-F23-SLD-EL-40011	0	17.JAN.25	ISSUED FOR CONSTRUCTION	TG	KVN	KVN

NORTHERN STAR RESOURCES LIMITED

DRA PACIFIC (PTY) LIMITED

[redacted]	[redacted]OM	11.NOV.2024
CHECKED	J.Y.WEE	11.NOV.2024
DESIGNED	[redacted]NAMEN	1[redacted]2024
TECH APP	P.[redacted]	26.NOV.2024
[redacted]APP	[redacted]	2[redacted]2025
CLIENT APP		

PROJECT: KCGM
FIM TSF PROJECT

TITLE: FIM III BOOSTER STATION
F23-SW-602 LV MOTOR CONTROL CENTRE INCOMER SCHEMATIC DIAGRAM SHEET 1

[redacted] SCALE NTS | DRG No. 2000-F23-SCM-EL-40011 | REV 2