


Docusign Envelope ID: D3EAC8FF-146A-4610-AFF4-26203B4BB02C

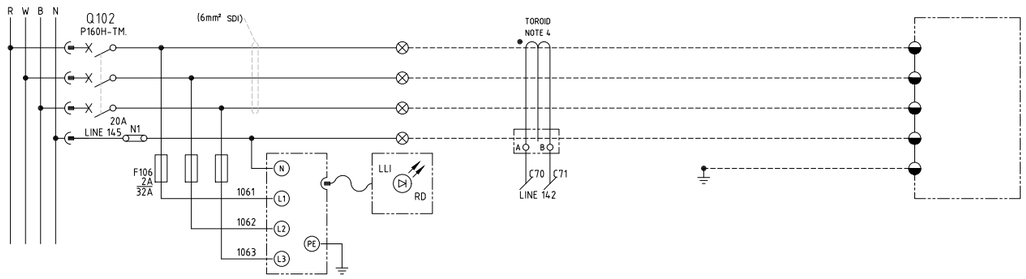


F23-FL-600
FIM III BOOSTER PUMPS
SEAL WATER
SELF CLEANING FILTER
1.0kW

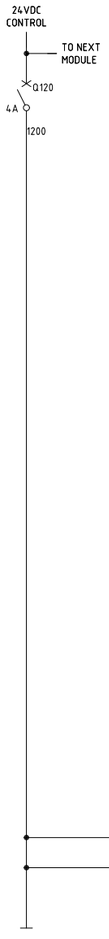

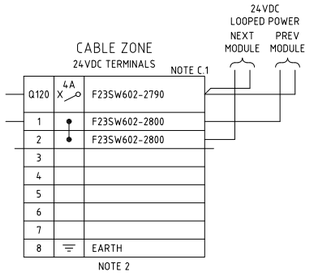



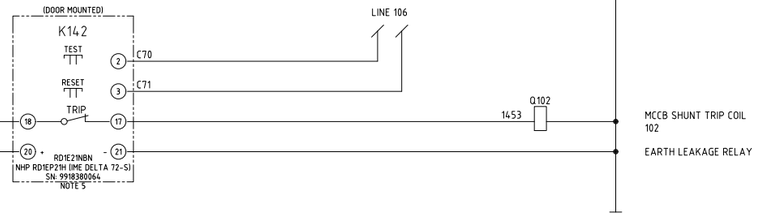

MCC CELL LOCATION 4R-01

NOTES

1. TERMINALS ON TERMINAL STRIPS ABOVE 50VAC SHALL HAVE A SEPARATE PERSPEX SHROUD AND SHALL BE LABELLED "DANGER xxxVAC".
2. WIRE NUMBER FERRULES ON TERMINAL STRIP SHALL BE PREFIXED WITH EQUIPMENT NUMBER e.g. F23FL600-1200.
3. EACH WIRE SHALL BE IDENTIFIED AT BOTH ENDS WITH FERRULES.
4. NHP TDG×2 TOROID TO SUIT CABLE DIAMETER (TOROID MIN. 30mA).
   TOROID DETAILS
   TOGB2
   SN: 0461520109
   IN: 70A
5. EARTH LEAKAGE RELAY USER INTERFACE TO BE MOUNTED ON MCC MODULE DOOR.
   RELAY SETTINGS SET TO:
   IΔn = "1A".
   DELAY = "100ms".
   RANGES = "x1".
   FAILSAFE MODE = "Ne".
   RESET = "MAN".
6. REFER TO CABLE SCHEDULE 2000-F23-LST-EL-40003.


LEGEND

- 00/01/00 — DCS DIGITAL INPUT
- 00/02/00 — DCS DIGITAL OUTPUT
- ⊗ — MCC TERMINAL
- ◓ — VSD TERMINAL
- ◒ — FIELD TERMINAL
- ◑ — DCS OR I/O TERMINAL
- ◧ — MARSHALLING TERMINAL
- (x) — DEVICE TERMINAL
- ⊗ cc — INDICATION LAMP, cc = COLOUR

DCS LEGEND



TERMINATION LEGEND

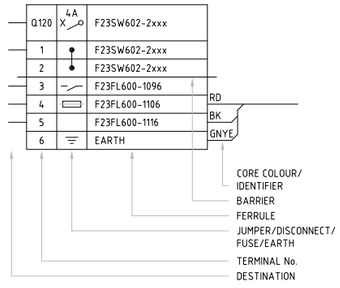

AS BUILT

REV	DATE	REVISION	DRN	CHK	TECH APP	APP
2	13.MAR.26	AS BUILT FOR FIM III TSF	[redacted]	[redacted]	[redacted]	[redacted]
1	07.JUL.25	RE-APPROVED FOR CONSTRUCTION			KVN	
0	17.JAN.25	ISSUED FOR CONSTRUCTION			KVN	

REFERENCES	DWG No
F23-SW-602 LV MOTOR CONTROL CENTRE SINGLE LINE DIAGRAM SHT 1 OF 2	2000-F23-SLD-EL-40011
GENERAL NOTES AND STANDARD DRAWINGS INDEX	2000-F00-STD-EL-10001

NORTHERN STAR RESOURCES LIMITED

DRA PACIFIC (PTY) LIMITED

[redacted]	[redacted]	02.DEC.2024
CHECKED	[redacted]	19.DEC.2024
DESIGNED	T. GROOM	20.NOV.2024
TECH APP	[redacted]	20.DEC.2024
[redacted] APP	T. HAMDORF	17.JAN.2025
CLIENT APP		

PROJECT: KCGM
FIM TSF PROJECT

TITLE: FIM III BOOSTER STATION
F23-FL-600 FIM III BOOSTER PUMPS SEAL WATER SELF CLEANING FILTER
CONTROL SCHEMATIC DIAGRAM

A1 | SCALE NTS | DRG No. 2000-F23-SCM-EL-40024 | REV 2