


Docusign Envelope ID: D3EAC8FF-146A-4610-AFF4-26203B4BB02C

F23-HF-601

FIM III BOOSTER STATION
LV MCC
ACTIVE HARMONIC FILTER
300 A

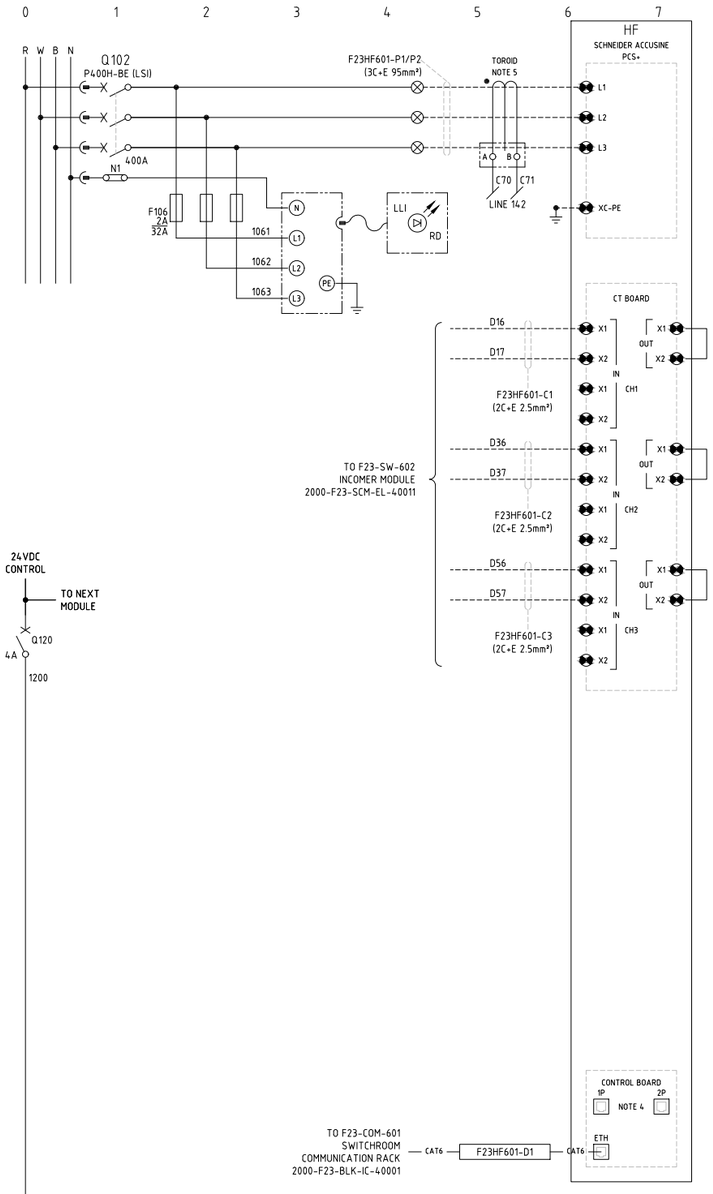

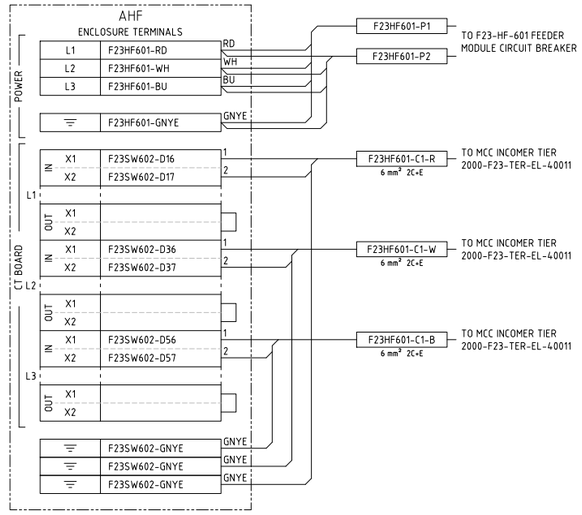

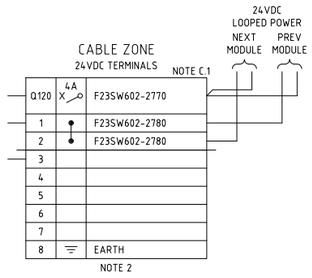

NOTES

1. TERMINALS ON TERMINAL STRIPS ABOVE 50VAC SHALL HAVE A SEPARATE PERSPEX SHROUD AND SHALL BE LABELLED "DANGER xxxVAC".
2. WIRE NUMBER FERRULES ON TERMINAL STRIP SHALL BE PREFIXED WITH EQUIPMENT NUMBER e.g. F23HF601-1200.
3. EACH WIRE SHALL BE IDENTIFIED AT BOTH ENDS WITH FERRULES.
4. P1 & P2 PORTS ARE FACTORY FITTED WITH RJ45 TERMINATOR.
5. NHP TDG×2 TOROID TO SUIT CABLE DIAMETER.
   TOROID DETAILS
   TDGF2
   SN: 0436160660
   IN:400A
6. EARTH LEAKAGE RELAY USER INTERFACE TO BE MOUNTED ON MCC MODULE DOOR.
   RELAY SETTINGS SET TO:
   IΔN ="1A".
   DELAY = "100MS".
   RANGES = "X1".
   FAILSAFE MODE = "NE".
   RESET = "MAN".
7. REFER TO CABLE SCHEDULE 2000-F23-LST-EL-40003.


LEGEND

- 00/01/00 — DCS DIGITAL INPUT
- 00/02/00 — DCS DIGITAL OUTPUT
- MCC TERMINAL
- VSD TERMINAL
- FIELD TERMINAL
- DCS OR I/O TERMINAL
- MARSHALLING TERMINAL
- DEVICE TERMINAL
- INDICATION LAMP (cc = COLOUR)

DCS LEGEND



TERMINATION LEGEND

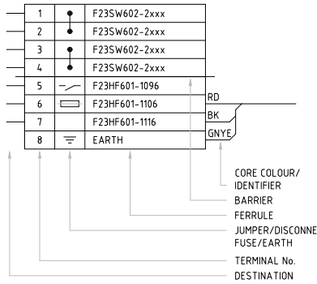

MCC CELL LOCATION 3R-17

AS BUILT

REFERENCES	DWG No	REV	DATE	REVISION	DRN	CHK	TECH APP	APP
		3	13.MAR.26	AS BUILT FOR FIM III TSF	[redacted]	[redacted]	MC	[redacted]
		2	07.JUL.25	RE-APPROVED FOR CONSTRUCTION			KVN	
F23-SW-602 LV MOTOR CONTROL CENTRE SINGLE LINE DIAGRAM SHT 1 OF 2	2000-F23-SLD-EL-40011	1	17.MAR.25	RE-APPROVED FOR CONSTRUCTION		KVN	[redacted]VN	
GENERAL NOTES AND STANDARD DRAWINGS INDEX	2000-F00-STD-EL-10001	0	17.JAN.25	APPROVED FOR CONSTRUCTION	TG	KVN	KVN	

NORTHERN STAR RESOURCES LIMITED

DRA PACIFIC (PTY) LIMITED

[redacted]	[redacted]	02.DEC.2024
CHECKED	[redacted]	19.DEC.2024
DESIGNED	[redacted]	20.NOV.2024
TECH APP	[redacted]	20.DEC.2024
[redacted]APP	[redacted]	17.JAN.2025
CLIENT APP		

PROJECT: KCGM
FIM TSF PROJECT

TITLE: FIM III BOOSTER STATION
F23-HF-601 LV MCC ACTIVE HARMONIC FILTER FEEDER
CONTROL SCHEMATIC DIAGRAM

[redacted] SCALE NTS | DRG No. 2000-F23-SCM-EL-40031 | REV 3