
Docusign Envelope ID: D3EAC8FF-146A-4610-AFF4-26203B4BB02C

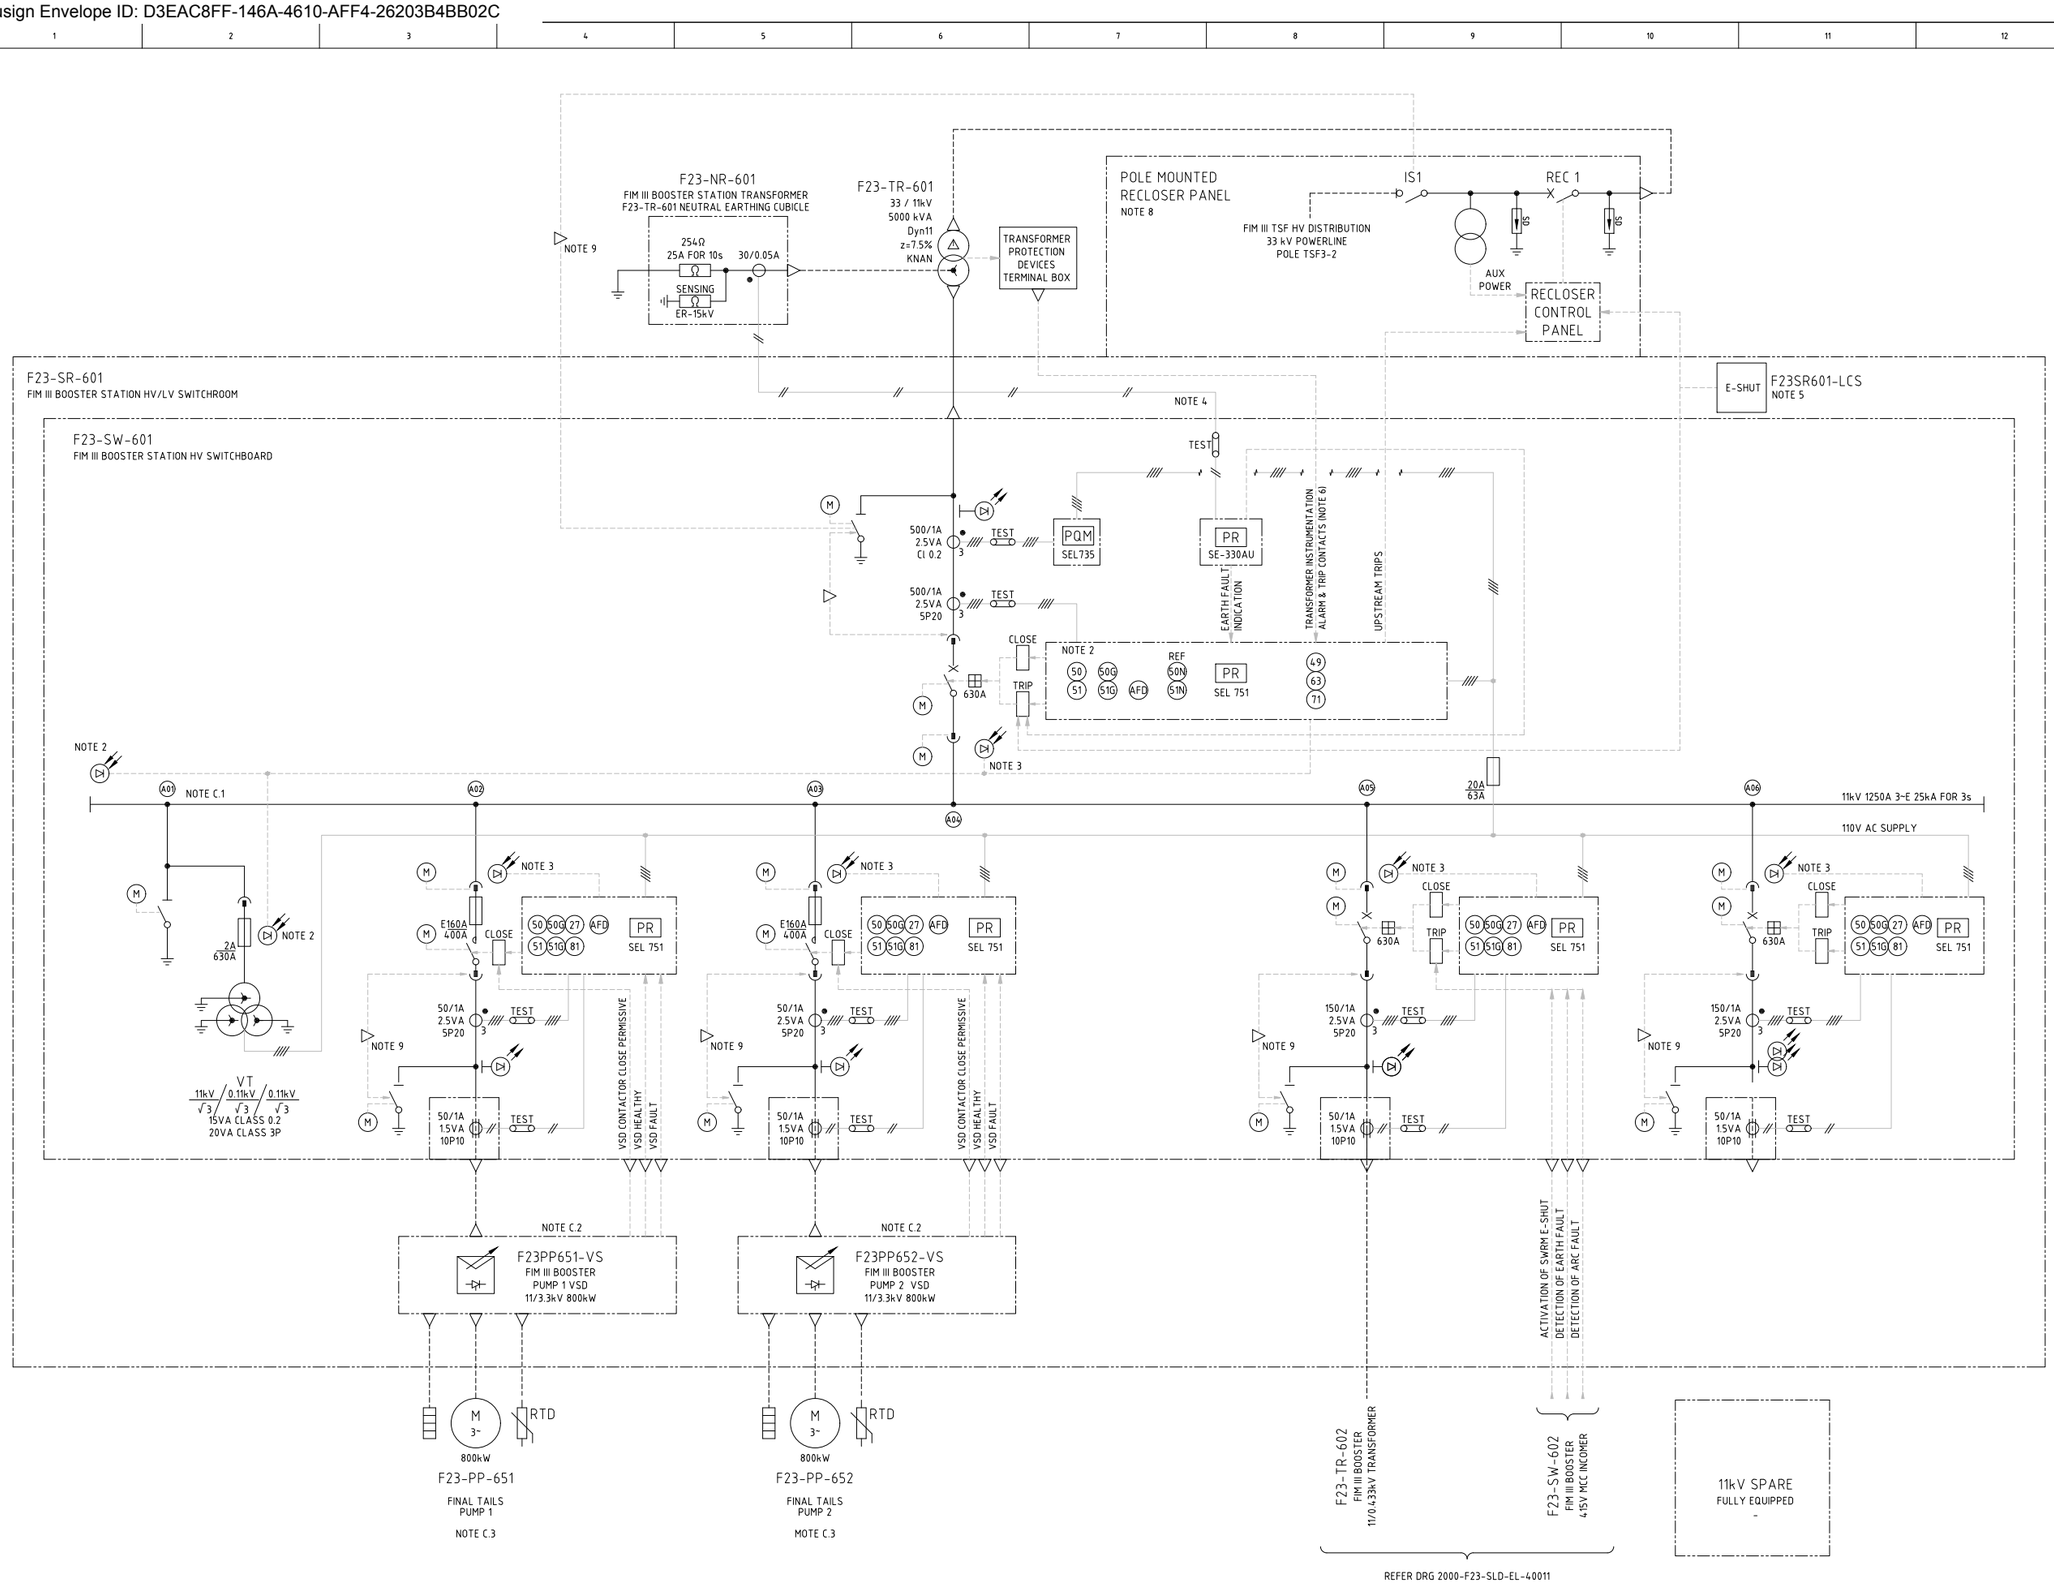

NOTES

1. THE SWITCHBOARD SHALL BE EXTENDABLE AT ONE END FOR FUTURE EXPANSION AND SUPPLIED WITH ONE SPARE TIER AS SHOWN.
2. ARC FLASH INCOMER CIRCUIT BREAKER COMPARTMENT IS NOT CURRENT SUPERVISED.
   TRIPPING OF BUS AND DOWNSTREAM CB/FC COMPARTMENT IS CURRENT SUPPERVISED.
3. ARC FLASH POINT DETECTORS SHALL BE PLACED IN THE CABLE ZONE. CIRCUIT BREAKER CHAMBER OR FUSE CONTACTOR CHAMBER AND THE BUSBAR CHAMBER. THE DETECTORS SHALL BE CONNECTED DIRECTLY TO THE PROTECTION RELAY IN EACH PANEL.
4. ONE OFF 30/0.05A PROTECTION CT SHALL BE INSTALLED IN THE NER CUBICLE AND CONNECTED TO THE INCOMER PROTECTION RELAY TO MONITOR FOR EARTH FAULT DETECTION.
5. SWITCHROOM EMERGENCY SHUTDOWN (E-SHUT) PUSH BUTTON IS HARD WIRED DIRECTLY TO THE SHUNT TRIP OF THE INCOMER CIRCUIT BREAKER AND UPSTREAM 33kV FEEDER.
6. 33/11kV TRANSFORMER INSTRUMENTATION TRIP CONTACTS SHALL BE HARDWIRED TO THE 11kV SWITCHBOARD INCOMER PROTECTION RELAY WHICH SHALL INTERTRIP THE THE UPSTREAM 33kV FEEDER.
7. UPSTREAM 33kV FEEDER SHALL BE TRIPPED ON THE EARTH AND ARC FAULT DETECTION OF THE DOWNSTREAM INCOMER ACB.
8. 33kV POWER SUPPLY EQUIPMENT BY OTHERS, INCLUDING RECLOSER AND RECLOSER CONTROL PANEL.
9. FOR MECHANICAL KEY INTERLOCK DETAILS REFER TO DRAWING NO. 2000-F23-SLD-EL-40002.
10. REFER TO CABLE SCHEDULE 2000-F23-LST-EL-40003.

LEGEND

- PR — INCOMER / FEEDER PROTECTION RELAY
- PQM — POWER QUALITY METER
- ARC FLASH SENSOR (POINT TYPE) NOTE 2, 8
- CAPACITIVE VOLTAGE INDICATION
- KEY-OPERATED INTERLOCK
- MECHANICAL INTERLOCK DEVICE
- KEY EXCHANGE BOX
- E-SHUT — EMERGENCY SHUTDOWN

AS BUILT

REFERENCES	DWG No	REV	DATE	REVISION	DRN	CHK	TECH APP	PROJ APP
		3	13.MAR.26	AS BUILT FOR FIM III TSF	M.E	K	M.B	MBB
F23-SW-601 HV SWITCHBOARD KEY INTERLOCKING SINGLE LINE DIAGRAM	2000-F23-SLD-EL-40002	2	11.NOV.25	RE-APPROVED FORCONSTRUCTION	[redacted]	[redacted]	T	TH
F23-SW-602 LV MOTOR CONTROL CENTRE SINGLE LINE DIAGRAM SHT 2 OF 2	2000-F23-SLD-EL-40012	1	07.JUL.25	RE-APPROVED FOR CONSTRUCTION	[redacted]	K.VN	[redacted]	TH
F23-SW-602 LV MOTOR CONTROL CENTRE SINGLE LINE DIAGRAM SHT 1 OF 2	2000-F23-SLD-EL-40011	0	17.JAN.25	ISSUED FOR CONSTRUCTION	[redacted]	[redacted]	K.VN	TH

NORTHERN STAR RESOURCES LIMITED

DRA PACIFIC (PTY) LIMITED

[redacted]	[redacted]	11.NOV.2024
CHECKED	J.Y.WEE	11.NOV.2024
DESIGNED	[redacted]	11.NOV.2024
TECH APP	[redacted]	26.NOV.2024
[redacted]APP	T.HAMDORF	22.MAY.2025
CLIENT APP		

PROJECT: KCGM
FIM TSF PROJECT

TITLE: FIM III BOOSTER STATION
F23-SW-601 HV SWITCHBOARD
SINGLE LINE DIAGRAM

A1 | SCALE NTS | DRG No. 2000-F23-SLD-EL-40001 | REV 3