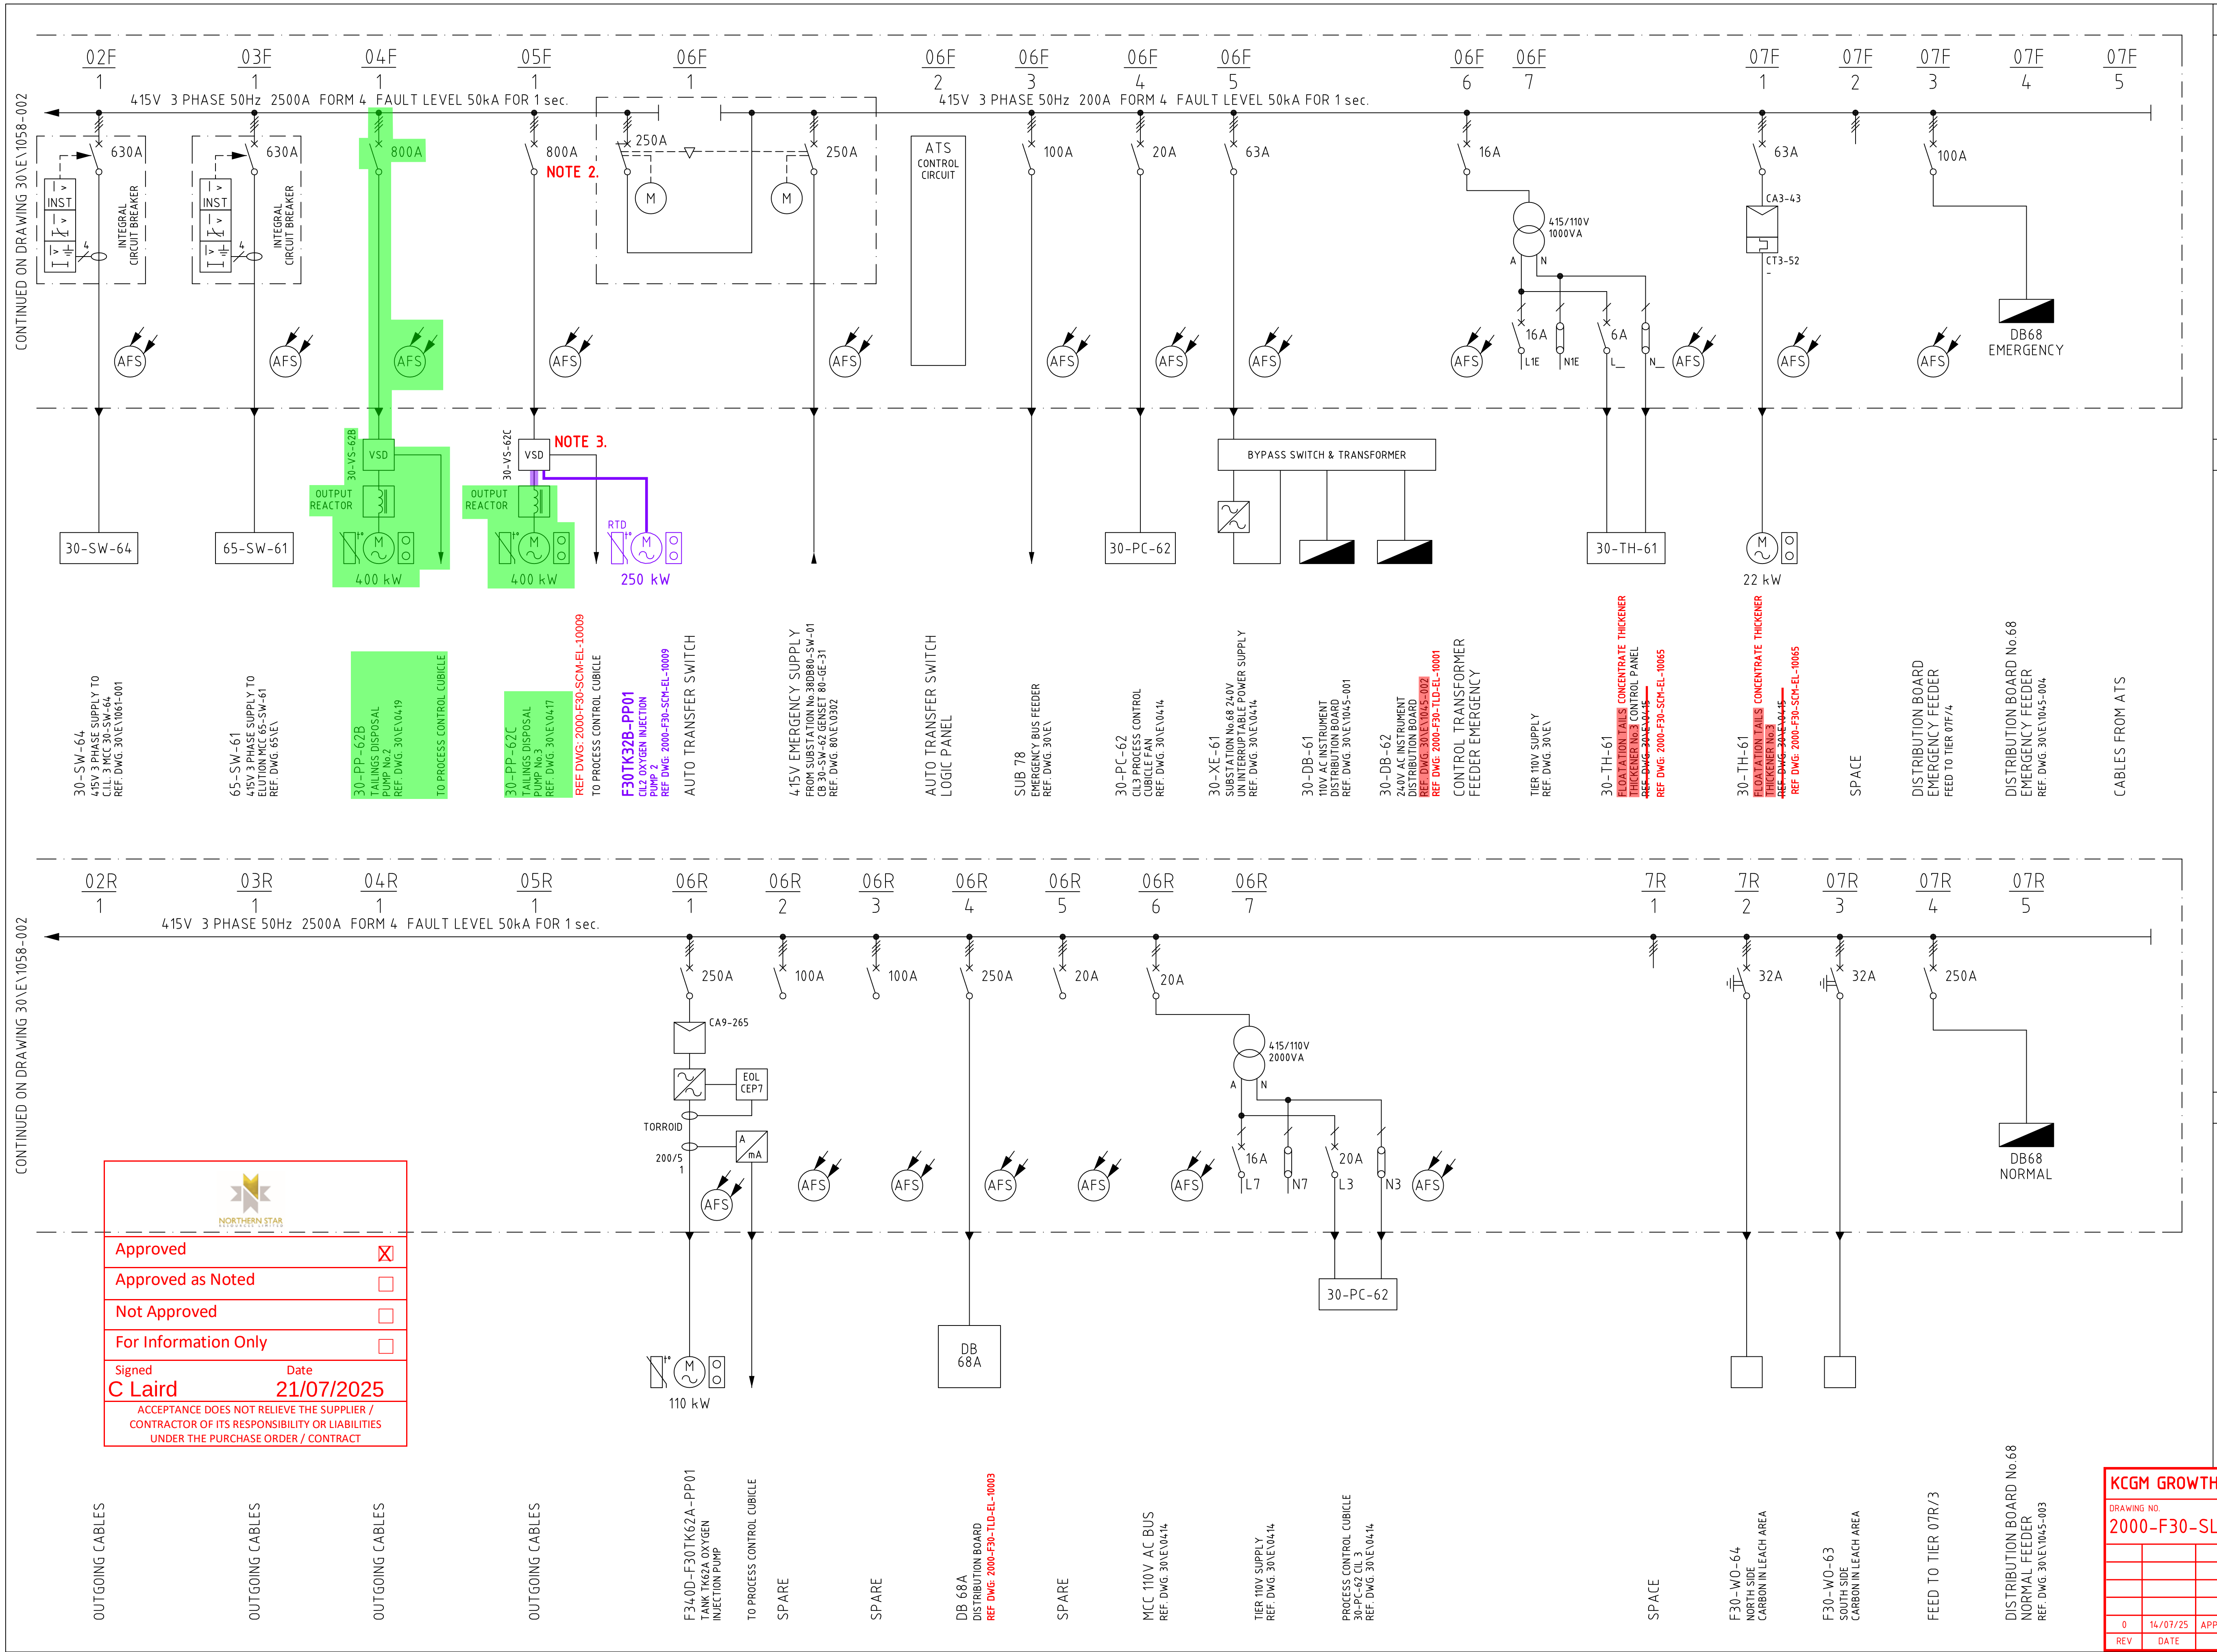

NORTHERN STAR

Approved ☒

Approved as Noted ☐

Not Approved ☐

For Information Only ☐

Signed C Laird
Date 21/07/2025

ACCEPTANCE DOES NOT RELIEVE THE SUPPLIER / CONTRACTOR OF ITS RESPONSIBILITY OR LIABILITIES UNDER THE PURCHASE ORDER / CONTRACT

LEGEND

LOCATION

SUB STATION 68

30-SW-62

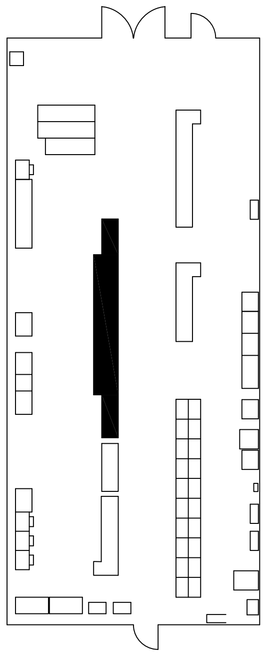

NOTES

1. ALL AFS (ARC FLASH SENSORS) ARE CONNECTED TO THE ARC FLASH RELAY VIA I/O UNITS
2. MCC FEEDER RE-PURPOSED AS PART OF THE KCGM GROWTH PROJECT.
3. VSD RE-PURPOSED AS PART OF THE KCGM GROWTH PROJECT.

LEGEND

—	STAGE 1 - NEW
🟥	STAGE 1 - REMOVE
🟨	STAGE 1 - DECOMMISSIONED (OTHERS)
—	STAGE 2 - NEW
🟪	STAGE 2 - REMOVE
🟩	STAGE 2 - DECOMMISSIONED (OTHERS)

KCGM GROWTH PROJECT

DRAWING NO.
2000-F30-SLD-EL-10102

REV	DATE	DESCRIPTION	CHECK	TECH APP
0	14/07/25	APPROVED FOR CONSTRUCTION	RF [redacted]	[redacted] M

MK	DATE	REVISION	BY	CKD	APP	MK	DATE	REVISION	BY	CKD	APP
						5	11/03/22	AS BUILT	[redacted]	GB	[redacted]
						4	12/03/21	ISSUED FOR CONSTRUCTION - OXYGEN INJECTION PROJECT	[redacted]	CV	[redacted]
						3	16/09/20	2019 S.L.D. UPDATE PROJECT "AS BUILT"	[redacted]	RA	[redacted]
						2A	23/08/19	2019 S.L.D. UPDATE PROJECT "AS BUILT"- FIELD REVIEW	[redacted]	RH	[redacted]
						1	20/03/18	EQUIPMENT ON DRAWING REPOSITIONED & ARC FLASH PROTECTION INSTALLED	[redacted]	JMR	[redacted]

REFERENCE DRAWINGS	DWG NO.

SCALE	NTS	
DRAWN	[redacted]	20/03/18
DESIGNED		
CHECKED		
APPROVED		
PROJ.APP		
PROJ. FILE #.		

FIMISTON PLANT
CARBON IN LEACH (C.I.L. 3)
SUBSTATION No.68 MCC 30-SW-62
SINGLE LINE DIAGRAM

SIZE	DRAWING NUMBER	REV
A1	30\E\1058-003	5

KALGOORLIE CONSOLIDATED GOLD MINES PTY. LTD. ABN 009 377 619 003