



Docusign Envelope ID: D3EAC8FF-146A-4610-AFF4-26203B4BB02C

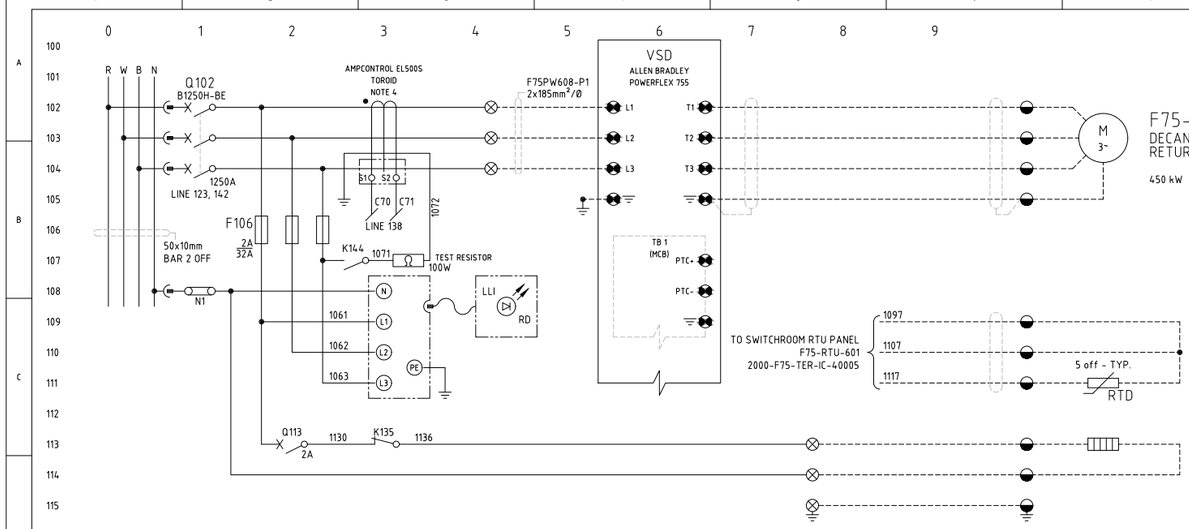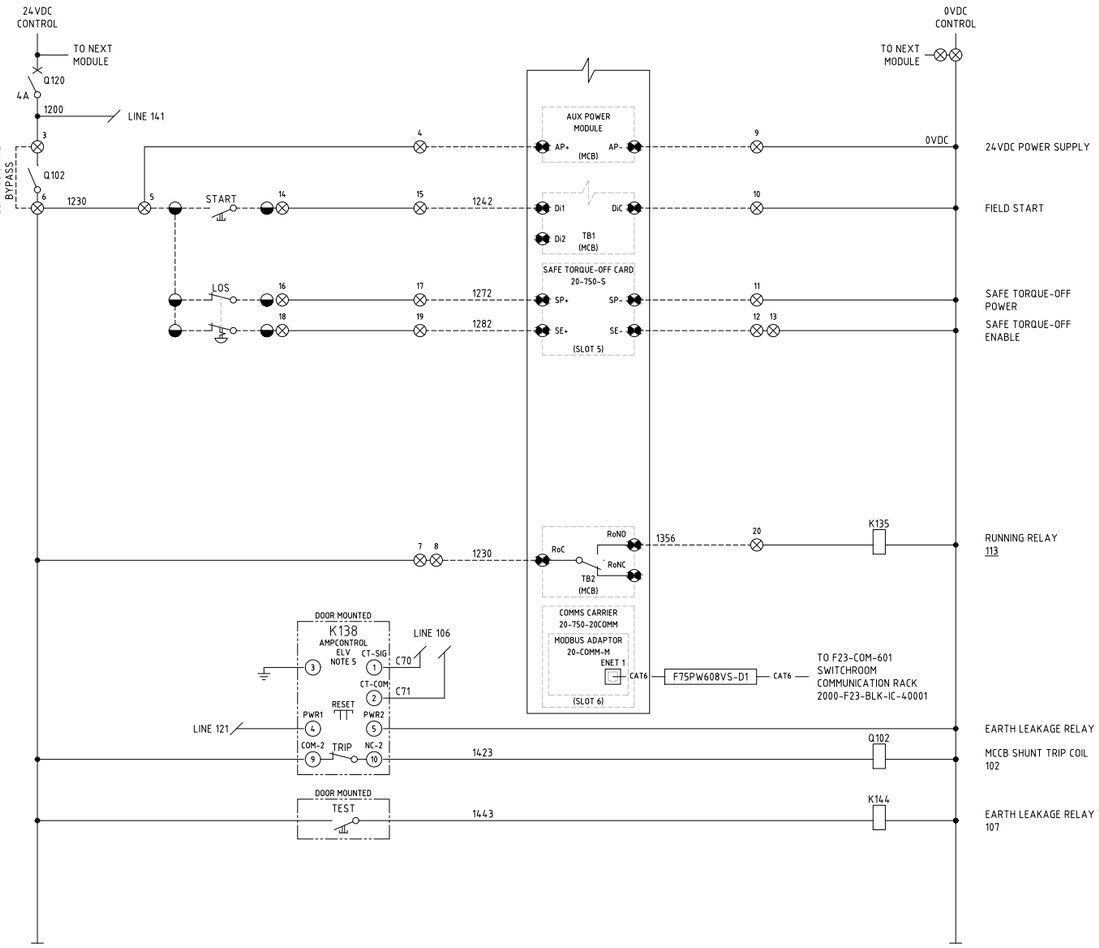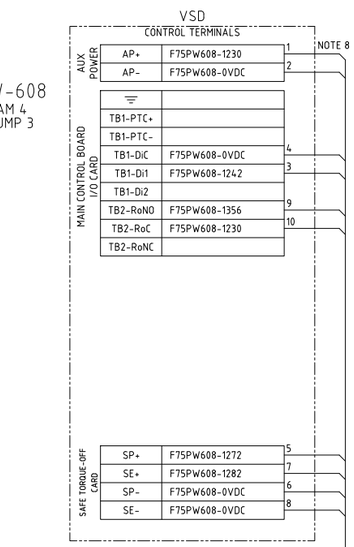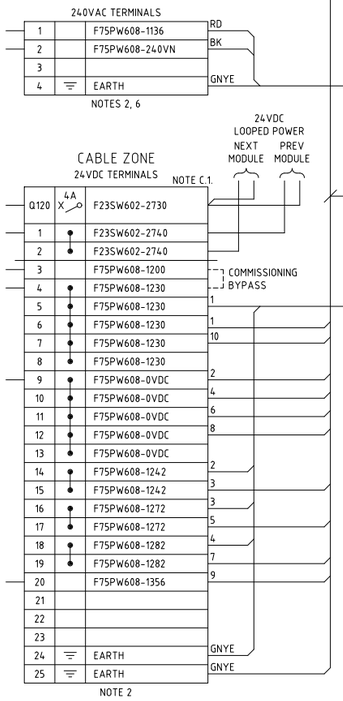


## NOTES

1. TERMINALS ON TERMINAL STRIPS ABOVE 50VAC SHALL HAVE A SEPARATE PERSPEX SHROUD AND SHALL BE LABELLED "DANGER xxxVAC".
2. WIRE NUMBER FERRULES ON TERMINAL STRIP SHALL BE PREFIXED WITH EQUIPMENT NUMBER e.g. F75PW608-1200.
3. EACH WIRE SHALL BE IDENTIFIED AT BOTH ENDS WITH FERRULES.
4. THE ELV RELAY REQUIRES A SEPARATELY PURCHASED EL500S TOROID FOR MEASUREMENT OF THE EARTH LEAKAGE CURRENT. EL500S TOROIDS ARE AVAILABLE IN THE FOLLOWING WINDOW SIZES: 25mm, 60mm & 112mm. AMPCONTROL (177655) 100/1
5. EARTH LEAKAGE RELAY (ELV) USER INTERFACE TO BE MOUNTED ON MCC MODULE DOOR. RELAY SETTINGS SET TO: TRIP LEVEL = "1A" (POSITION 0). TRIP DELAY = "100ms" (POSITION 1). AMPCONTROL (170447).
6. 240VAC TERMINALS FOR THE HEATER CIRCUITS SHALL BE LOCATED IN THE MCC DRIVE MODULE.
7. REFER TO CABLE SCHEDULE 2000-F23-LST-EL-40003.
8. 24VDC TERMINATED TO P13 TERMINALS AT BOTTOM OF MAIN CARD AUX AT TOP IS SPARE.


## LEGEND

- 00/01/00 — DCS DIGITAL INPUT
- 00/02/00 — DCS DIGITAL OUTPUT
- ⊗ — MCC TERMINAL
- ◓ — VSD TERMINAL
- ◒ — FIELD TERMINAL
- ◑ — DCS OR I/O TERMINAL
- ▮ — MARSHALLING TERMINAL
- (x) — DEVICE TERMINAL
- ⊗cc — INDICATION LAMP, cc = COLOUR

## DCS LEGEND




## TERMINATION LEGEND

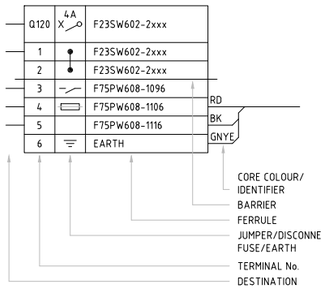


MCC CELL LOCATION 1R-01

AS BUILT

| REFERENCES | DWG No | REV | DATE | REVISION | DRN | CHK | TECH APP |
|---|---|---|---|---|---|---|---|
| | | 2 | 13.MAR.26 | AS-BUILT FOR FIM TSF III | ET | EA | MC |
| F23-SW-602 LV MOTOR CONTROL CENTRE SINGLE LINE DIAGRAM SHT 2 OF 2 | 2000-F23-SLD-EL-40012 | 1 | 13.JUN.25 | RE-APPROVED FOR CONSTRUCTION | TG | [redacted] | KVN |
| GENERAL NOTES AND STANDARD DRAWINGS INDEX | 2000-F00-STD-EL-10001 | 0 | 17.JAN.25 | ISSUED FOR CONSTRUCTION | TG | [redacted] | KVN |

NORTHERN STAR RESOURCES LIMITED

DRA PACIFIC (PTY) LIMITED

| | | |
|---|---|---|
| [redacted] | [redacted] | 02.DEC.2024 |
| CHECKED | [redacted] WEE | 02.DEC.2024 |
| DE[redacted] | [redacted] NAMEN | 02.DEC.2024 |
| TECH APP | K[redacted] | 20.DEC.2024 |
| [redacted]APP | T. HAMDORF | 17.JAN.2025 |
| CLIENT APP | | |

PROJECT: KCGM
FIM TSF PROJECT

TITLE: FIM III BOOSTER STATION
F75-PW-608 DECANT DAM 4 RETURN PUMP 3
CONTROL SCHEMATIC DIAGRAM

[redacted] SCALE NTS | DRG No. 2000-F75-SCM-EL-40003 | REV 2