
Docusign Envelope ID: D3EAC8FF-146A-4610-AFF4-26203B4BB02C

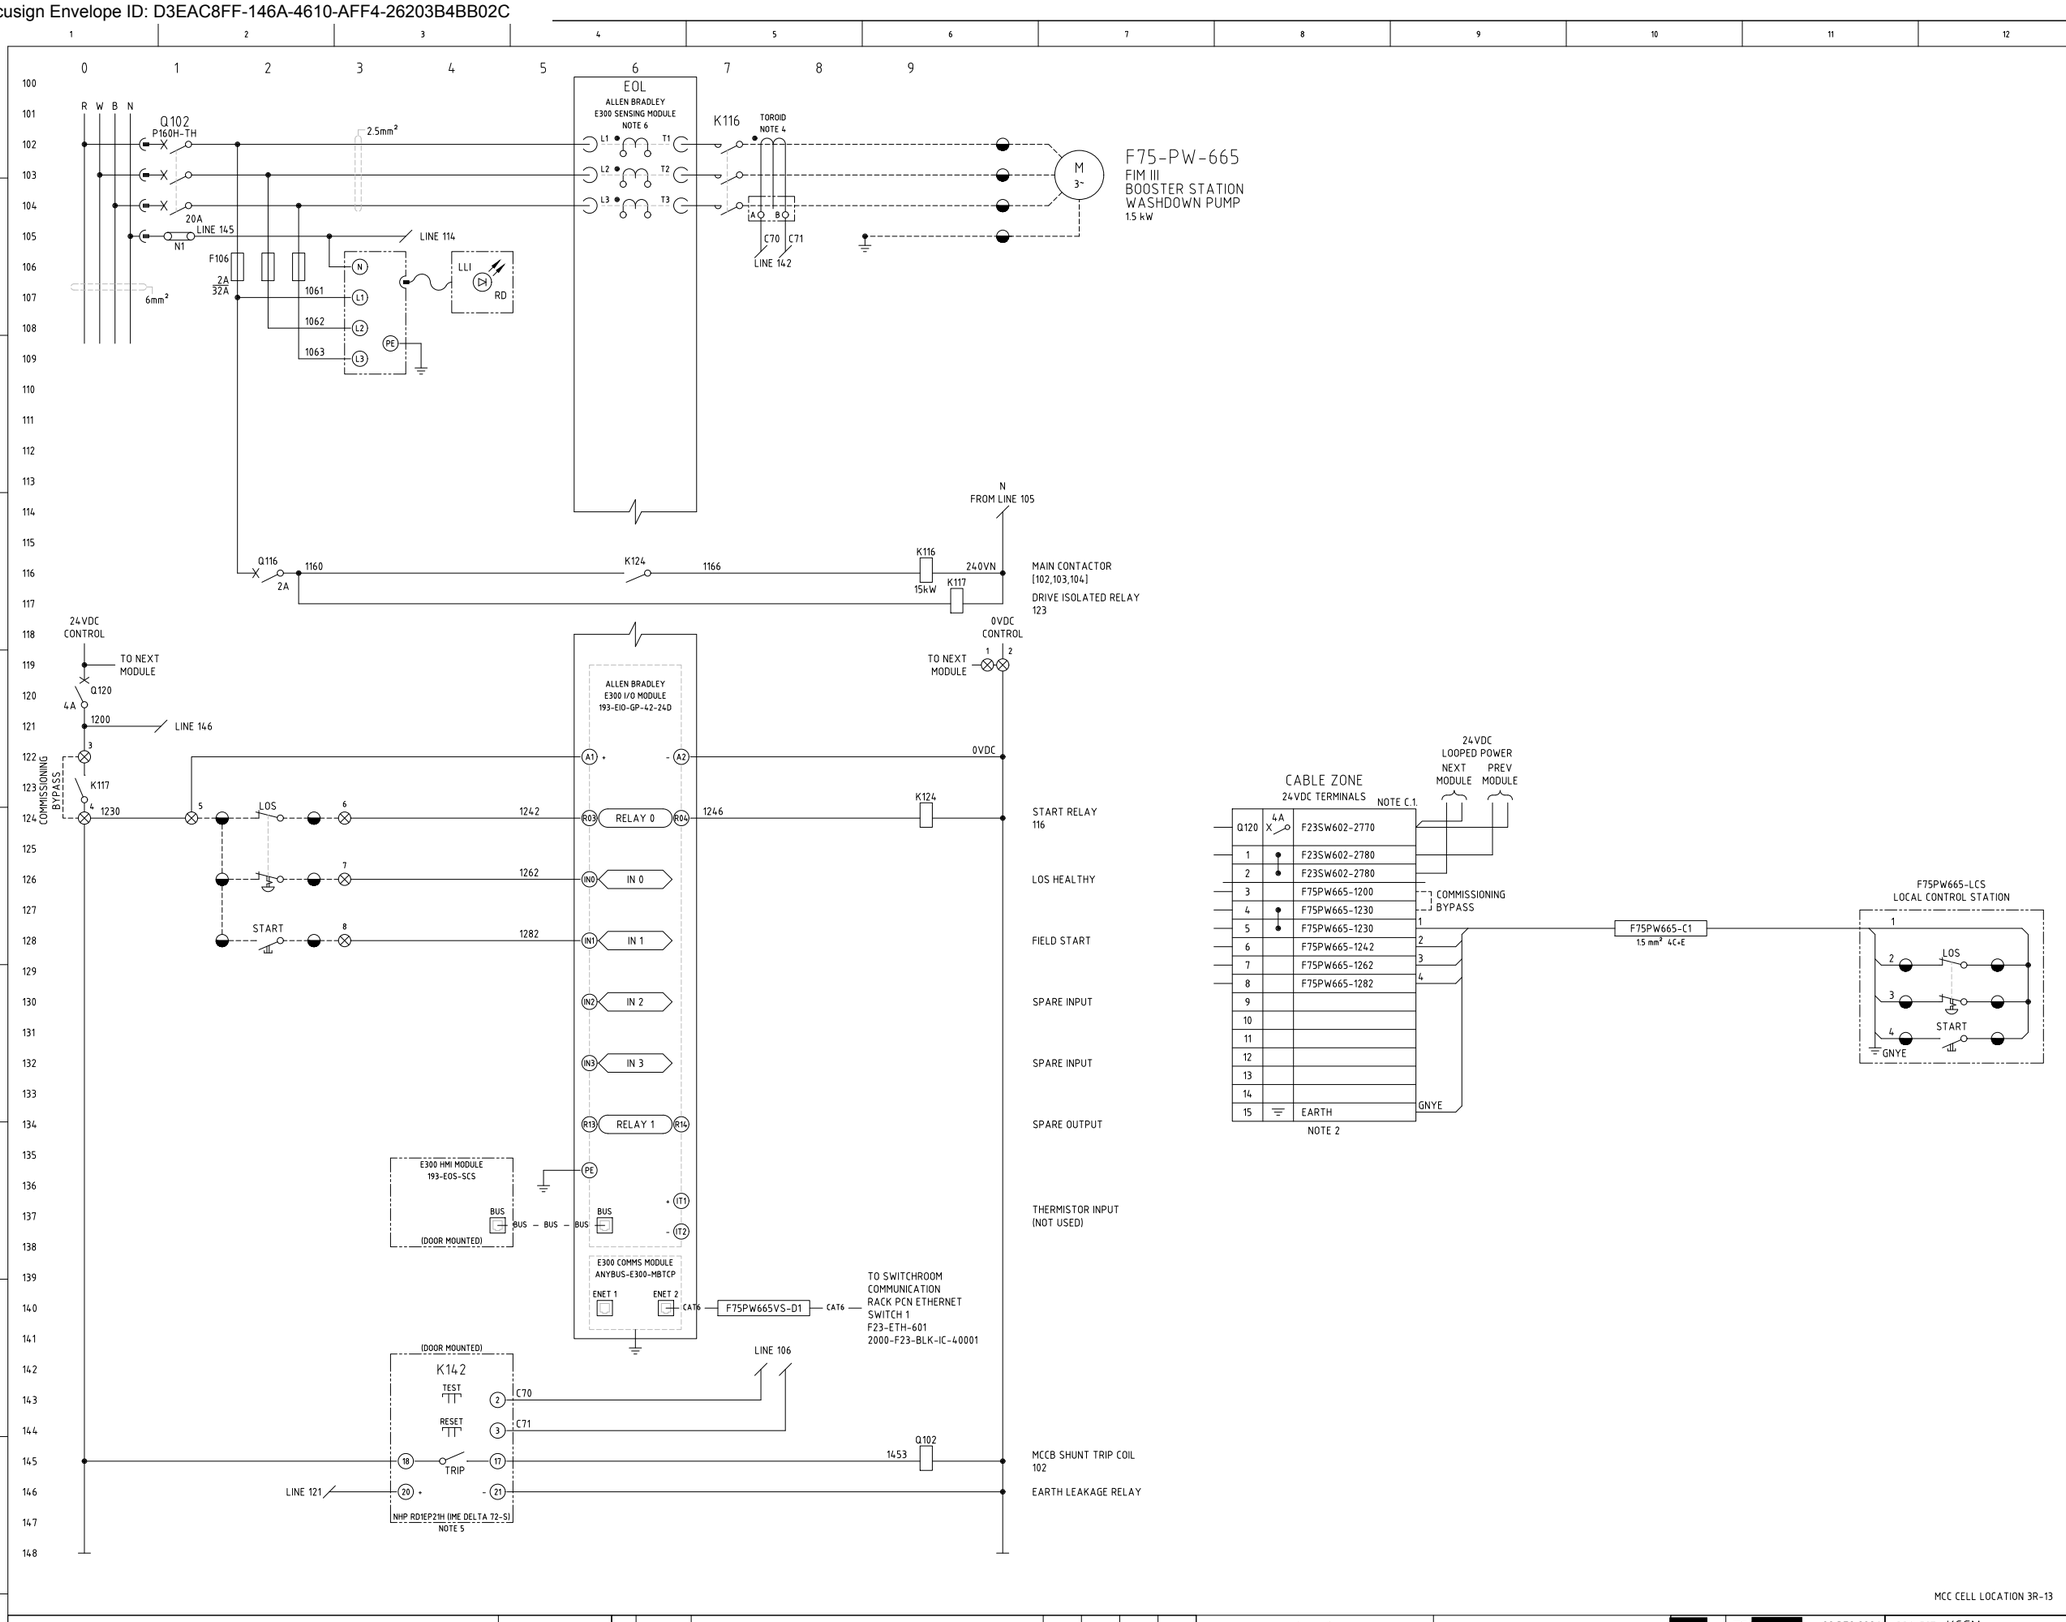

NOTES

1. TERMINALS ON TERMINAL STRIPS ABOVE 50VAC SHALL HAVE A SEPARATE PERSPEX SHROUD AND SHALL BE LABELLED "DANGER xxxVAC".
2. WIRE NUMBER FERRULES ON TERMINAL STRIP SHALL BE PREFIXED WITH EQUIPMENT NUMBER e.g. F75PW665-1200.
3. EACH WIRE SHALL BE IDENTIFIED AT BOTH ENDS WITH FERRULES.
4. NHP TDG×2 TOROID TO SUIT CABLE DIAMETER. (TDGB2) In:70A.
5. EARTH LEAKAGE RELAY USER INTERFACE TO BE MOUNTED ON MCC MODULE DOOR.
   RELAY SETTINGS SET TO:
   IΔn ="1A".
   DELAY = "100ms".
   RANGES = "x1".
   FAILSAFE MODE = "Ne".
   RESET = "MAN".
6. E300 SENSING MODULE FOR VOLTAGE/ CURRENT/ GROUND FAULT (VIG RANGE) TO SUIT MOTOR kW DUTY. (193-ESM-I-30A-T) 0.5-30A
7. REFER TO CABLE SCHEDULE 2000-F23-LST-EL-40003.


LEGEND

- 00/01/00 — DCS DIGITAL INPUT
- 00/02/00 — DCS DIGITAL OUTPUT
- ⊗ — MCC TERMINAL
- VSD TERMINAL
- FIELD TERMINAL
- DCS OR I/O TERMINAL
- MARSHALLING TERMINAL
- (x) — DEVICE TERMINAL
- ⊗ cc — INDICATION LAMP, cc = COLOUR

DCS LEGEND



TERMINATION LEGEND

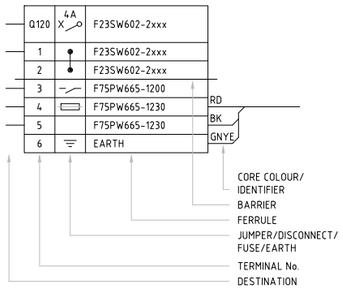

MCC CELL LOCATION 3R-13

AS BUILT

REFERENCES	DWG No	REV	DATE	REVISION	DRN	CHK	TECH APP	APP
		2	13.MAR.26	AS-BUILT FOR FIM TSF III	ET	EA		
F23-SW-602 LV MOTOR CONTROL CENTRE SINGLE LINE DIAGRAM SHT 2 OF 2	2000-F23-SLD-EL-40012	1	13.JUN.25	RE-APPROVED FOR CONSTRUCTION	TG		KVN	
GENERAL NOTES AND STANDARD DRAWINGS INDEX	2000-F00-STD-EL-10001	0	17.JAN.25	ISSUED FOR CONSTRUCTION	TG		TECH APP	

NORTHERN STAR RESOURCES LIMITED

DRA PACIFIC (PTY) LIMITED

	[redacted]	02.DEC.2024
CHECKED	[redacted] WEE	02.DEC.2024
DE[redacted]	K.VAN NAMEN	02.DEC.2024
TECH APP	K[redacted]	20.DEC.2024
[redacted]PP	T. HAMDORF	17.JAN.2025
CLIENT APP		

PROJECT: KCGM
GROWTH PROJECT - ENABLING WORKS

TITLE: FIM III BOOSTER STATION
F75-PW-665 FIM III BOOSTER STATION WASHDOWN PUMP
CONTROL SCHEMATIC DIAGRAM

[redacted] SCALE NTS | DRG No. 2000-F75-SCM-EL-40005 | REV 2