
Docusign Envelope ID: D3EAC8FF-146A-4610-AFF4-26203B4BB02C

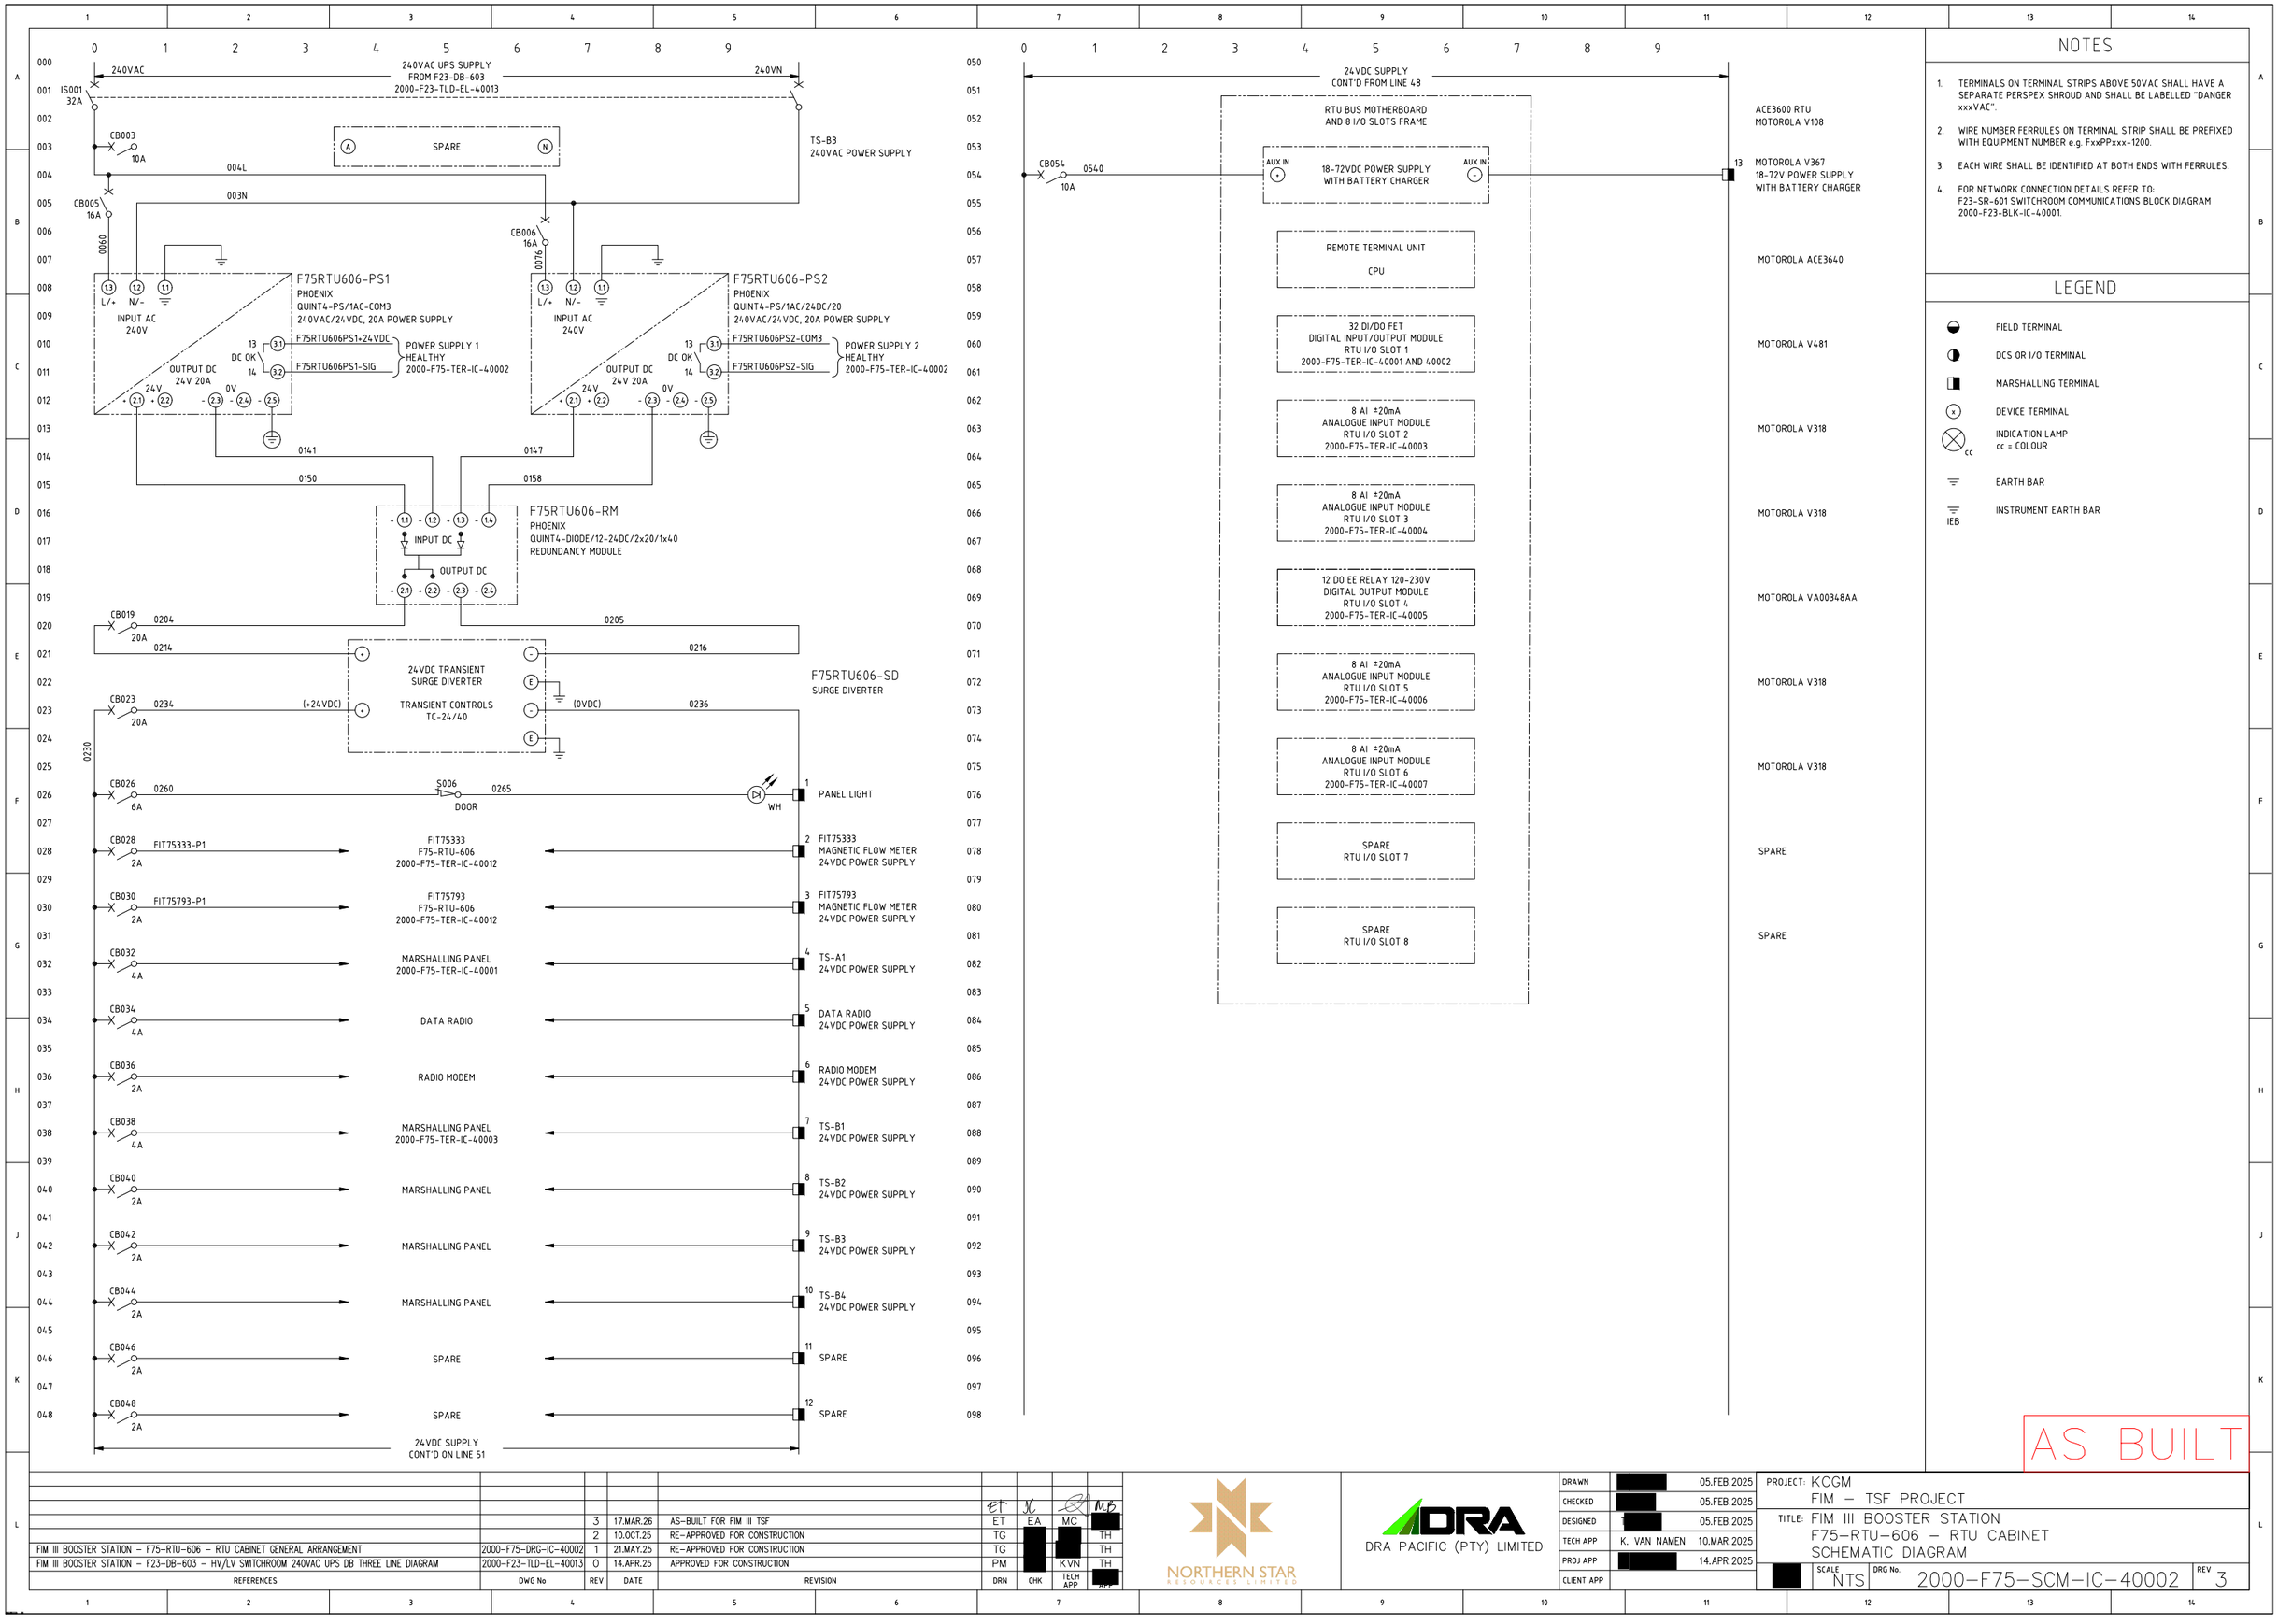

NOTES

1. TERMINALS ON TERMINAL STRIPS ABOVE 50VAC SHALL HAVE A SEPARATE PERSPEX SHROUD AND SHALL BE LABELLED "DANGER xxxVAC".
2. WIRE NUMBER FERRULES ON TERMINAL STRIP SHALL BE PREFIXED WITH EQUIPMENT NUMBER e.g. FxxPPxxx-1200.
3. EACH WIRE SHALL BE IDENTIFIED AT BOTH ENDS WITH FERRULES.
4. FOR NETWORK CONNECTION DETAILS REFER TO:
   F23-SR-601 SWITCHROOM COMMUNICATIONS BLOCK DIAGRAM
   2000-F23-BLK-IC-40001.

LEGEND

- FIELD TERMINAL
- DCS OR I/O TERMINAL
- MARSHALLING TERMINAL
- DEVICE TERMINAL (x)
- INDICATION LAMP, cc = COLOUR (cc)
- EARTH BAR
- INSTRUMENT EARTH BAR (IEB)

AS BUILT

REFERENCES	DWG No	REV	DATE	REVISION	DRN	CHK	TECH APP	APP
		3	17.MAR.26	AS-BUILT FOR FIM III TSF	ET	EA	MC	MB
		2	10.OCT.25	RE-APPROVED FOR CONSTRUCTION	TG	[redacted]	[redacted]	TH
FIM III BOOSTER STATION – F75-RTU-606 – RTU CABINET GENERAL ARRANGEMENT	2000-F75-DRG-IC-40002	1	21.MAY.25	RE-APPROVED FOR CONSTRUCTION	TG	[redacted]	[redacted]	TH
FIM III BOOSTER STATION – F23-DB-603 – HV/LV SWITCHROOM 240VAC UPS DB THREE LINE DIAGRAM	2000-F23-TLD-EL-40013	0	14.APR.25	APPROVED FOR CONSTRUCTION	PM	[redacted]	KVN	TH

NORTHERN STAR RESOURCES LIMITED

DRA PACIFIC (PTY) LIMITED

DRAWN	[redacted]	05.FEB.2025
CHECKED	[redacted]	05.FEB.2025
DESIGNED	[redacted]	05.FEB.2025
TECH APP	K. VAN NAMEN	10.MAR.2025
PROJ APP	[redacted]	14.APR.2025
CLIENT APP		

PROJECT: KCGM
FIM – TSF PROJECT

TITLE: FIM III BOOSTER STATION
F75–RTU–606 – RTU CABINET
SCHEMATIC DIAGRAM

[redacted] SCALE NTS DRG No. 2000–F75–SCM–IC–40002 REV 3