
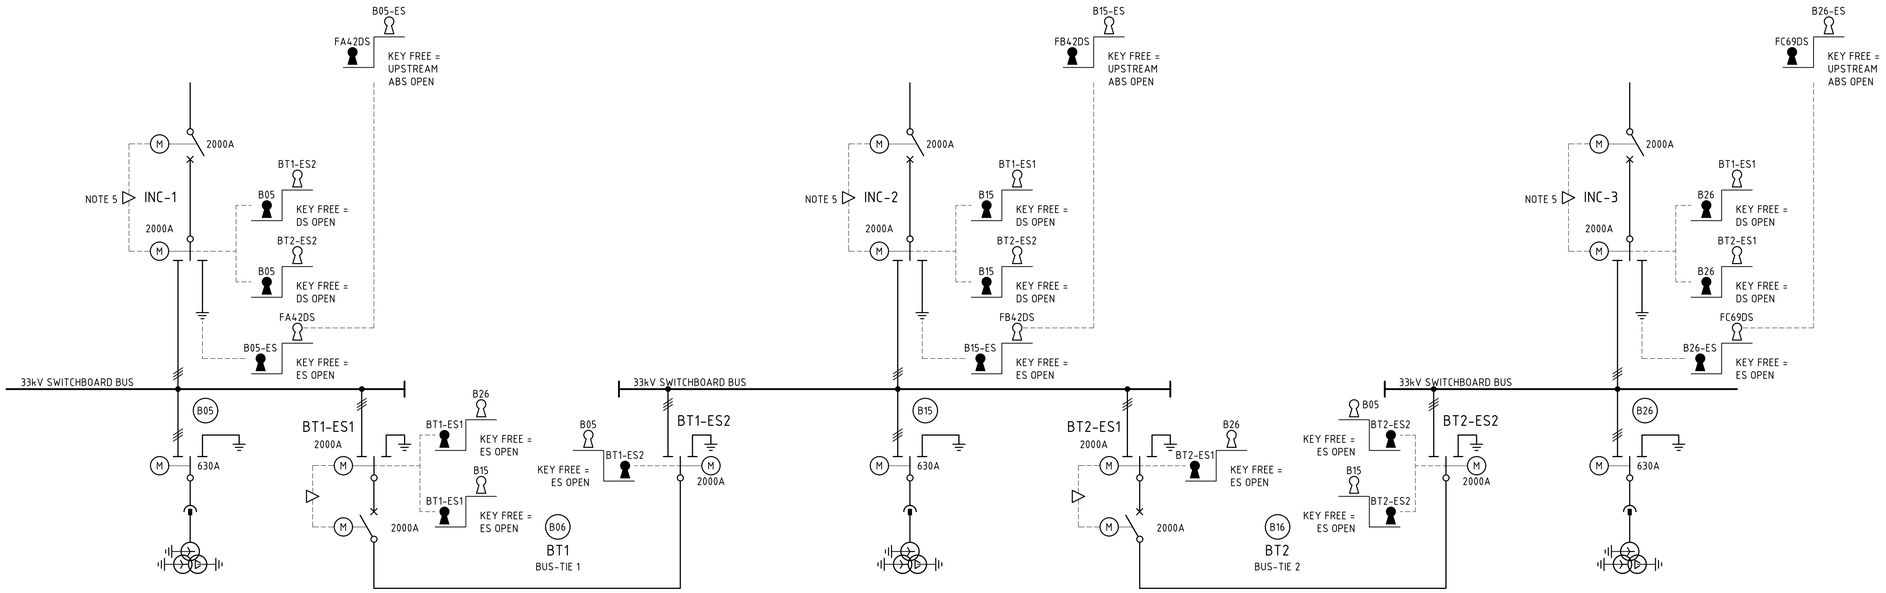



F00-SW-010 33kV BUS EARTH SWITCH KEY INTERLOCKING SCHEME
ALL INTERLOCKING IS SINGLE KEY - 1 OUT OF 2 - INTERLOCKING

NOTES


1. INCOMER 1 (INC-1) DISCONNECTOR SHALL BE KEY INTERLOCKED WITH BUS-TIE 1 (BT1) EARTH SWITCH BT1-ES2 AND BUS-TIE 2 (BT2) EARTH SWITCH BT2-ES2 SUCH THAT THESE EARTH SWITCHES MAY ONLY BE CLOSED WITH THE INCOMER 1 (INC-1) DISCONNECTOR LOCKED IN AN OPEN STATE .
2. INCOMER 2 (INC-2) DISCONNECTOR SHALL BE KEY INTERLOCKED WITH BUS-TIE 1 (BT1) EARTH SWITCH BT1-ES1 AND BUS-TIE 2 (BT2) EARTH SWITCH BT2-ES2 SUCH THAT THESE EARTH SWITCHES MAY ONLY BE CLOSED WITH THE INCOMER 2 (INC-2) DISCONNECTOR LOCKED IN AN OPEN STATE.
3. INCOMER 3 (INC-3) DISCONNECTOR SHALL BE KEY INTERLOCKED WITH BUS-TIE 1 (BT1) EARTH SWITCH BT1-ES1 AND BUS-TIE 2 (BT2) EARTH SWITCH BT2-ES1 SUCH THAT THESE EARTH SWITCHES MAY ONLY BE CLOSED WITH THE INCOMER 3 (INC-3) DISCONNECTOR LOCKED IN AN OPEN STATE.
4. EARTHED KEY CONDITION ONLY VALID WHEN THE EARTH SWITCH & CIRCUIT BREAKER ARE CLOSED.
5. 415V SWITCHROOM TRANSFORMER ROOM DOOR SHALL BE FORTRESS KEY INTERLOCKED (KEYED ALIKE) WITH THE UPSTREAM 33kV FEEDER EARTH SWITCH.
6. 33kV EARTH SWITCH SHALL BE FORTRESS KEY INTERLOCKED WITH THE VSD HV COMPARTMENT DOORS VIA THE KEY EXCHANGE BOX.
7. UPSTREAM 33kV OVERHEAD LINE POLE MOUNTED DISCONNECTOR SWITCH SHALL BE KEY INTERLOCKED WITH THE 33kV INCOMER EARTH SWITCH SUCH THAT THE UPSTREAM 33kV OVERHEAD LINE DISCONNECTOR SWITCH CAN ONLY BE CLOSED WHEN THE 33kV INCOMER EARTH SWITCH IS OPEN.
8. AN ELECTRICAL INTERLOCK PREVENTS OPERATION OF THE THREE-POSITION SWITCH WHEN THE CIRCUIT BREAKER IS CLOSED, TO PREVENT THE THREE-POSITION SWITCH FROM SWITCHING ON LOAD.
9. TRANSFORMER ENCLOSURE DOOR STATUS SHALL BE MONITORED BY THE DCS. OPENING OF DOOR SHALL RAMP STOP THE RELEVANT SWITCHROOM AREA AND OPEN THE UPSTREAM CB.

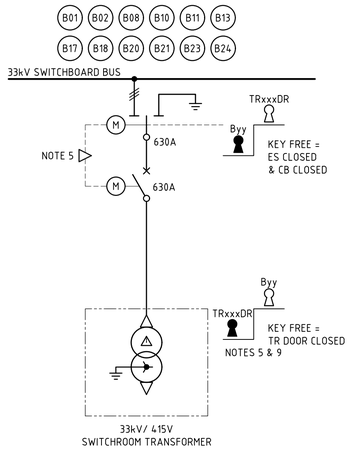

33kV FEEDER TO 415V SWITCHROOM
TRANSFORMER ACCESS DOOR
KEY INTERLOCKING SCHEME
ALL INTERLOCKING IS SINGLE KEY
1 OUT OF 2 INTERLOCKING

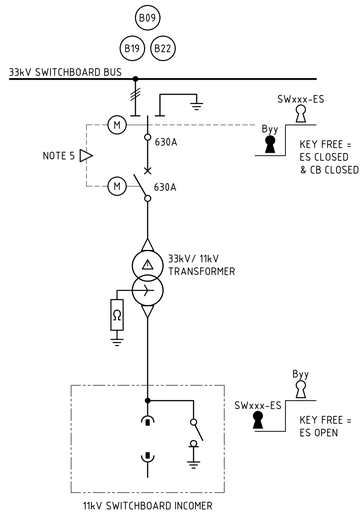

33kV FEEDER TO 11kV SWITCHBOARD
INCOMER EARTH SWITCH
KEY INTERLOCKING SCHEME
ALL INTERLOCKING IS SINGLE KEY
1 OUT OF 2 INTERLOCKING

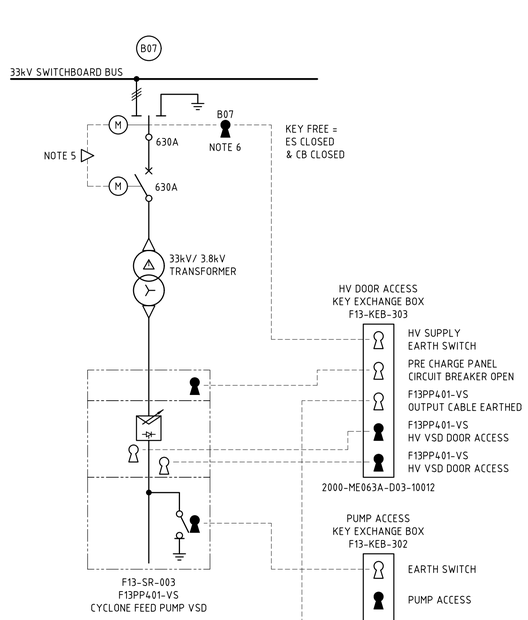

33kV FEEDER TO HV VSD
MAIN PANEL ACCESS DOOR
KEY INTERLOCKING SCHEME

LEGEND

- MECHANICAL OR ELECTRICAL INTERLOCK DEVICE
- KEY FREE
- KEY CAPTIVE
- KEY EXCHANGE BOX

DRG No.	REFERENCES	REV	DATE	DESCRIPTION	DRAW	CHECK	DESIGN	TECH APP	PROJ APP
2000-ME063A-D03-10012	F13PP401-VS FORTRESS KEY INTERLOCKING SCHEMATIC								
2000-F00-LST-EL-11004	ELECTRICAL INTERLOCKING SCHEDULE								
2000-F00-DRG-EL-10001	F00-SR-010 33kV PLANT HV DISTRIBUTION SWITCHROOM ELECTRICAL EQUIPMENT LAYOUT	2	10SEP26	KCGM GROWTH PROJECT - SP1 AS-BUILT					
2000-F00-SLD-EL-10002	F00-SW-010 33kV PLANT HV DISTRIBUTION SWITCHBOARD SINGLE LINE DIAGRAM SHEET 1 OF 5	1	30MAY25	FAT REDLINES INCORPORATED					
2000-F00-STD-EL-10001	GENERAL NOTES AND STANDARD DRAWINGS INDEX	0	08OCT24	APPROVED FOR CONSTRUCTION					

NORTHERN STAR RESOURCES LIMITED

PRIMERO
primero.com.au | DESIGN | CONSTRUCT | OPERATE

PRIMERO PROJECT NUMBER: 23517

INFORMATION AND REPRESENTATIONS ON THIS DRAWING ARE THE INTELLECTUAL PROPERTY OF PRIMERO UNLESS SPECIFICALLY IDENTIFIED OTHERWISE. ALL RIGHTS INCLUDING USE RESERVED

PROJECT: NORTHERN STAR RESOURCES LTD
KCGM GROWTH PROJECT

TITLE: GENERAL FIMISTON SITE
F00-SW-010 33kV SWITCHBOARD
ELECTRICAL INTERLOCKING SINGLE LINE DIAGRAM SHEET 1

SHEET	SCALE	DRG No.	REVISION
A1	NONE	2000-F00-SLD-EL-10051	2

O:\CAD PROJECTS\235 NORTHERN STAR RESOURCES LTD\235TI KCGM GROWTH PROJECT\03 DELIVERABLES\EL\F00 - GENERAL FIMISTON SITE\2000-F00-SLD-EL-10051.DWG 09SEP26 9:02AM ROBIN.LAW