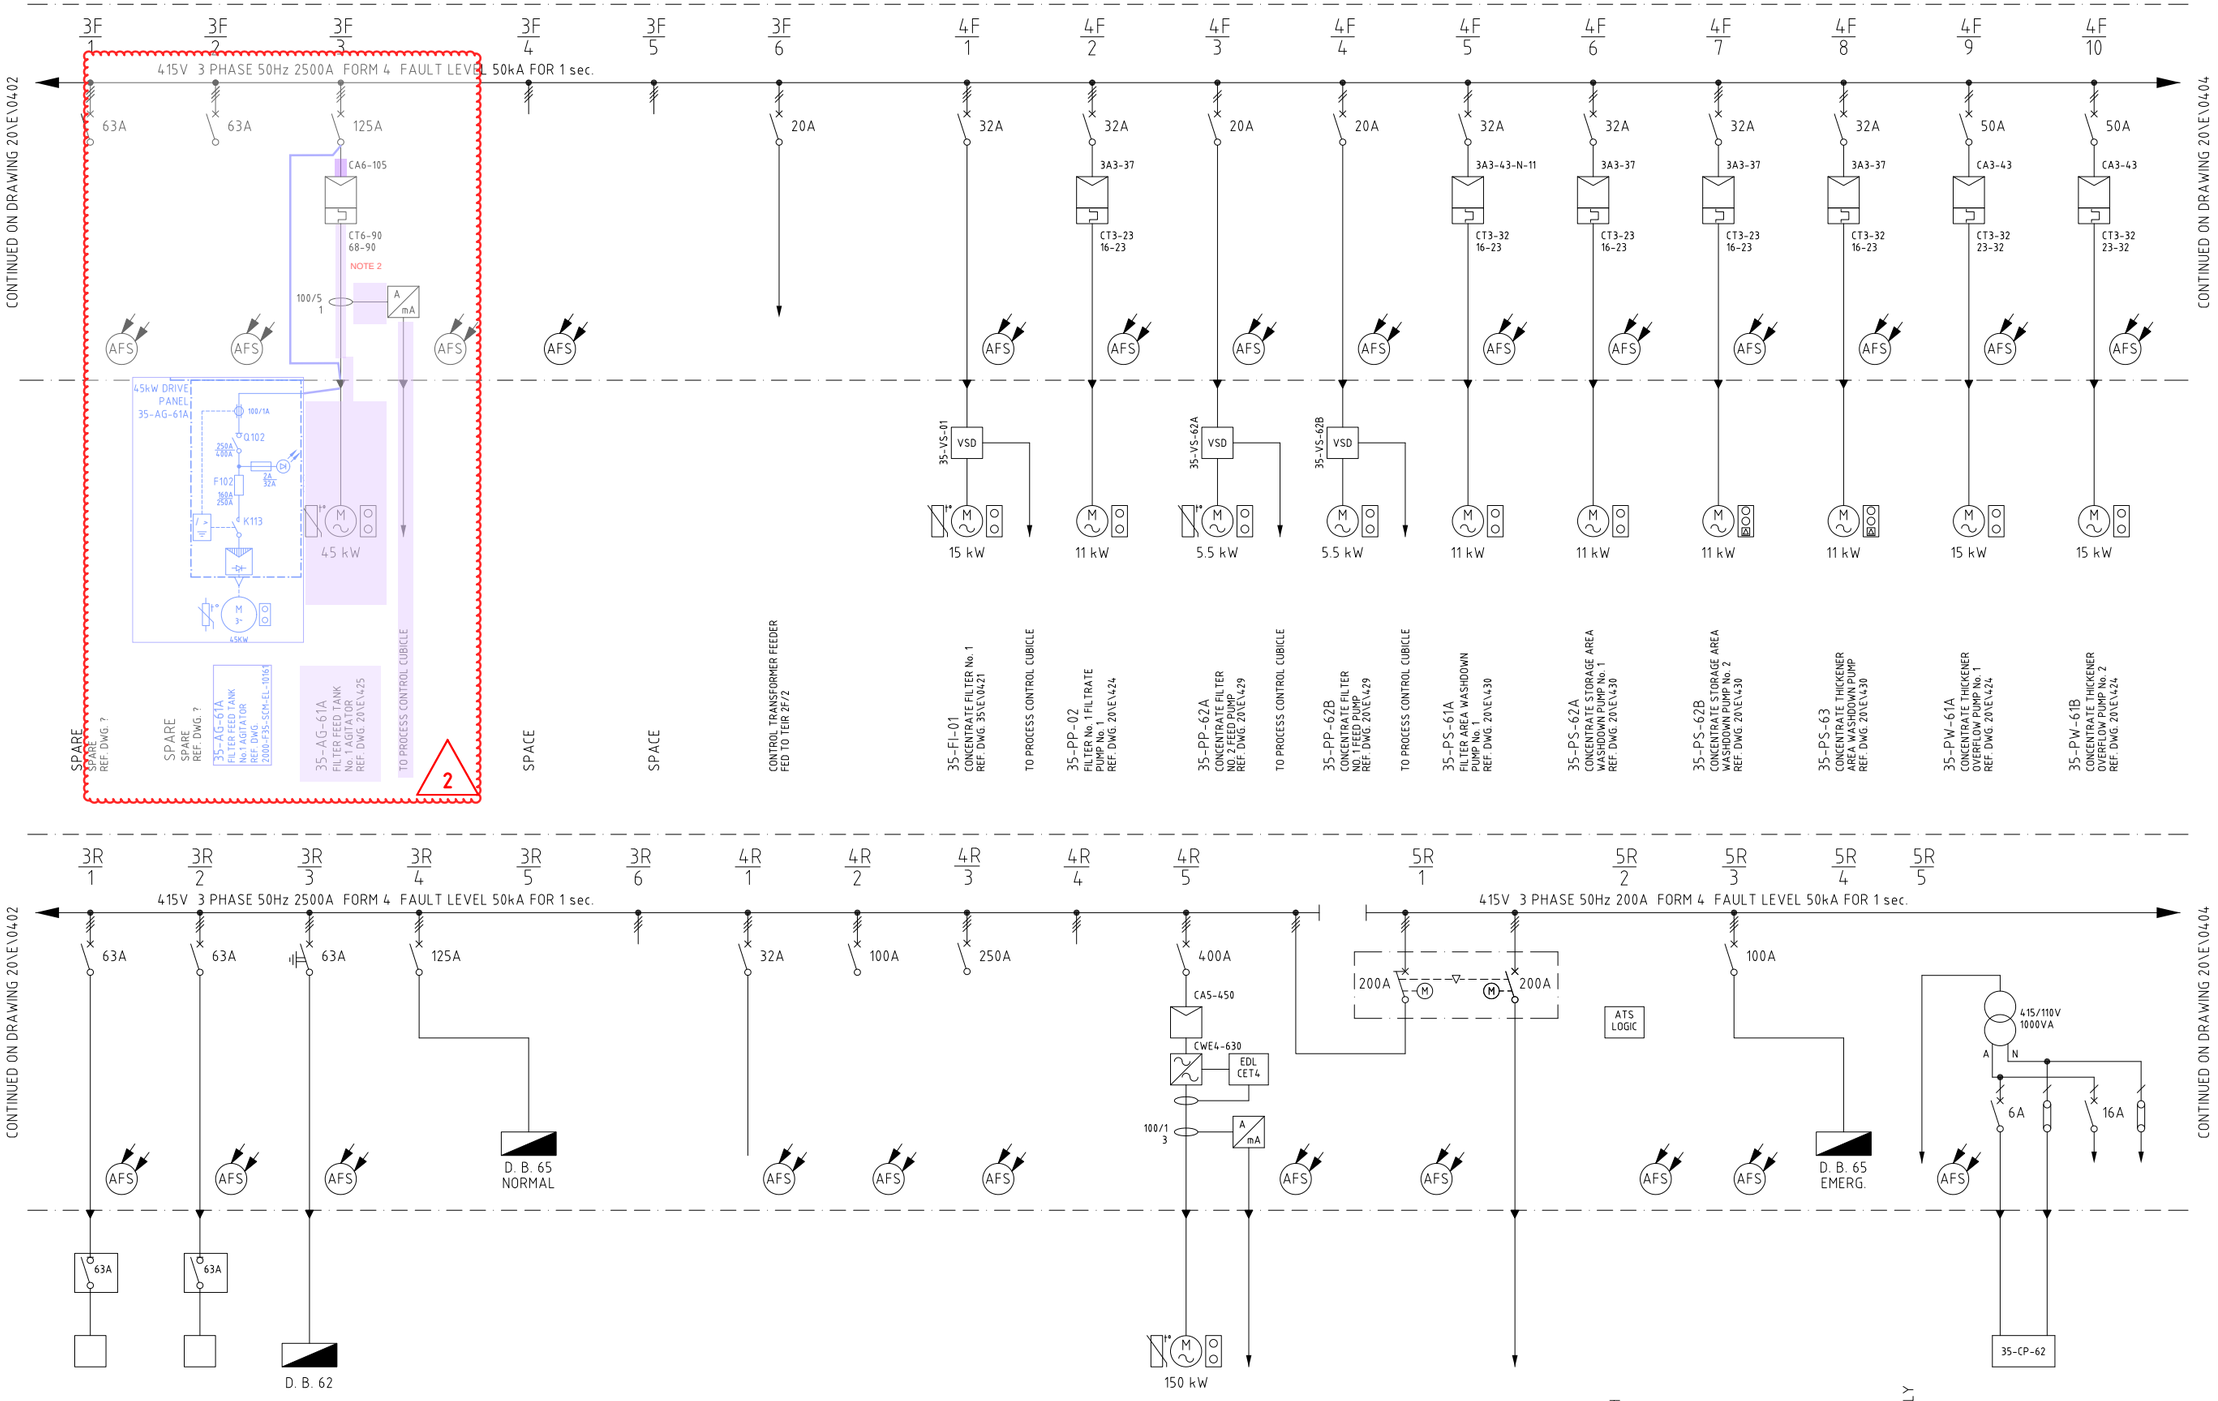


LEGEND


Approved ☒
Approved as Noted ☐
Not Approved ☐
For Information Only ☐

Signed A. Vuckovic Date 30/09/26

ACCEPTANCE DOES NOT RELIEVE THE SUPPLIER / CONTRACTOR OF ITS RESPONSIBILITY OR LIABILITIES UNDER THE PURCHASE ORDER / CONTRACT

LOCATION

SUB STATION 35
20-SW-62

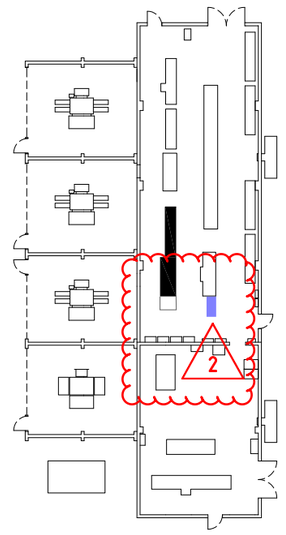

NOTES

1. ALL AFS (ARC FLASH SENSORS) ARE CONNECTED TO THE ARC FLASH RELAY VIA I/O UNITS
2. EXISTING CONTACTOR, OVERLOAD, CT, AMMETER CIRCUIT, AND ASSOCIATED CONTROL WIRING TO BE DISCONNECTED AND RETAINED IN BUCKET.

LEGEND
- EXISTING
- NON-EXISTENT
- STAGE 1 - NEW
- STAGE 1 - REMOVE
- STAGE 1 - DECOMMISSIONED (OTHERS)
- STAGE 2 - NEW
- STAGE 2 - REMOVE
- STAGE 2 - DECOMMISSIONED (OTHERS)

KCGM GROWTH PROJECT

DRAWING NO.
2000-F35-SLD-EL-10101

REV	DATE	DESCRIPTION	CHECK	APP
2	09/09/26	LAYOUT REVISED	GD	MB DM
1	24/08/26	VSD RELOCATED NOTE 2 REVISED		
0	31/07/26	APPROVED FOR CONSTRUCTON		
B	23/07/26	ISSUED FOR CLIENT REVIEW		
A	25/03/26	ISSUED FOR INTERNAL REVIEW		

MK	DATE	REVISION	BY	CKD	APP
12	14/11/17	ARC FLASH SENSORS INSTALLED	RH	JMR	JMR
11	31/03/16	35FI01 INFO UPDATED	[redacted]	WL	[redacted]
10	22/02/07	35PP62B VSD REPLACEMENT, AS BUILT FEB 2007	[redacted]		
9	14/04/05	GENERAL REVISION	[redacted]		
8	10/12/98	AS BUILT & REDRAWN TO KCGM STANDARDS	CV		
7	8/97	CONSOLDATION PROJECT	[redacted]	FW	[redacted]
6	3/95	REVISED AS NOTED	AH		
5	11/94	REVISED AS NOTED	[redacted]	JAM	[redacted]
4	10/94	REVISED AS NOTED	[redacted]	JAM	
3	9/94	20-PP-61A,B ADDED	[redacted]	JAM	[redacted]
13	19/06/19	2019 S.L.D. UPDATE PROJECT "AS BUILT"	[redacted]	RH	
14	16/08/19	2019 S.L.D UPDATE PROJECT " AS BUILT "	[redacted]	RH	[redacted]

REFERENCE DRAWINGS
DWG NO.
PROJ. FILE #.

SCALE	NTS	
DRAWN	[redacted]	1994
DESIGNED		1994
CHECKED		1994
APPROVED	MRD/JM	03/07/14
PROJ.APP	MINPROC	1994

FIMISTON PLANT
FIMISTON RECYCLE CRUSHING
SUBSTATION No.35 415V MCC 20-SW-62
SINGLE LINE DIAGRAM SHEET 2

SIZE	DRAWING NUMBER	REV
A1	20\E\0403	14

KALGOORLIE CONSOLIDATED GOLD MINES PTY. LTD. ABN 009 377 619 003