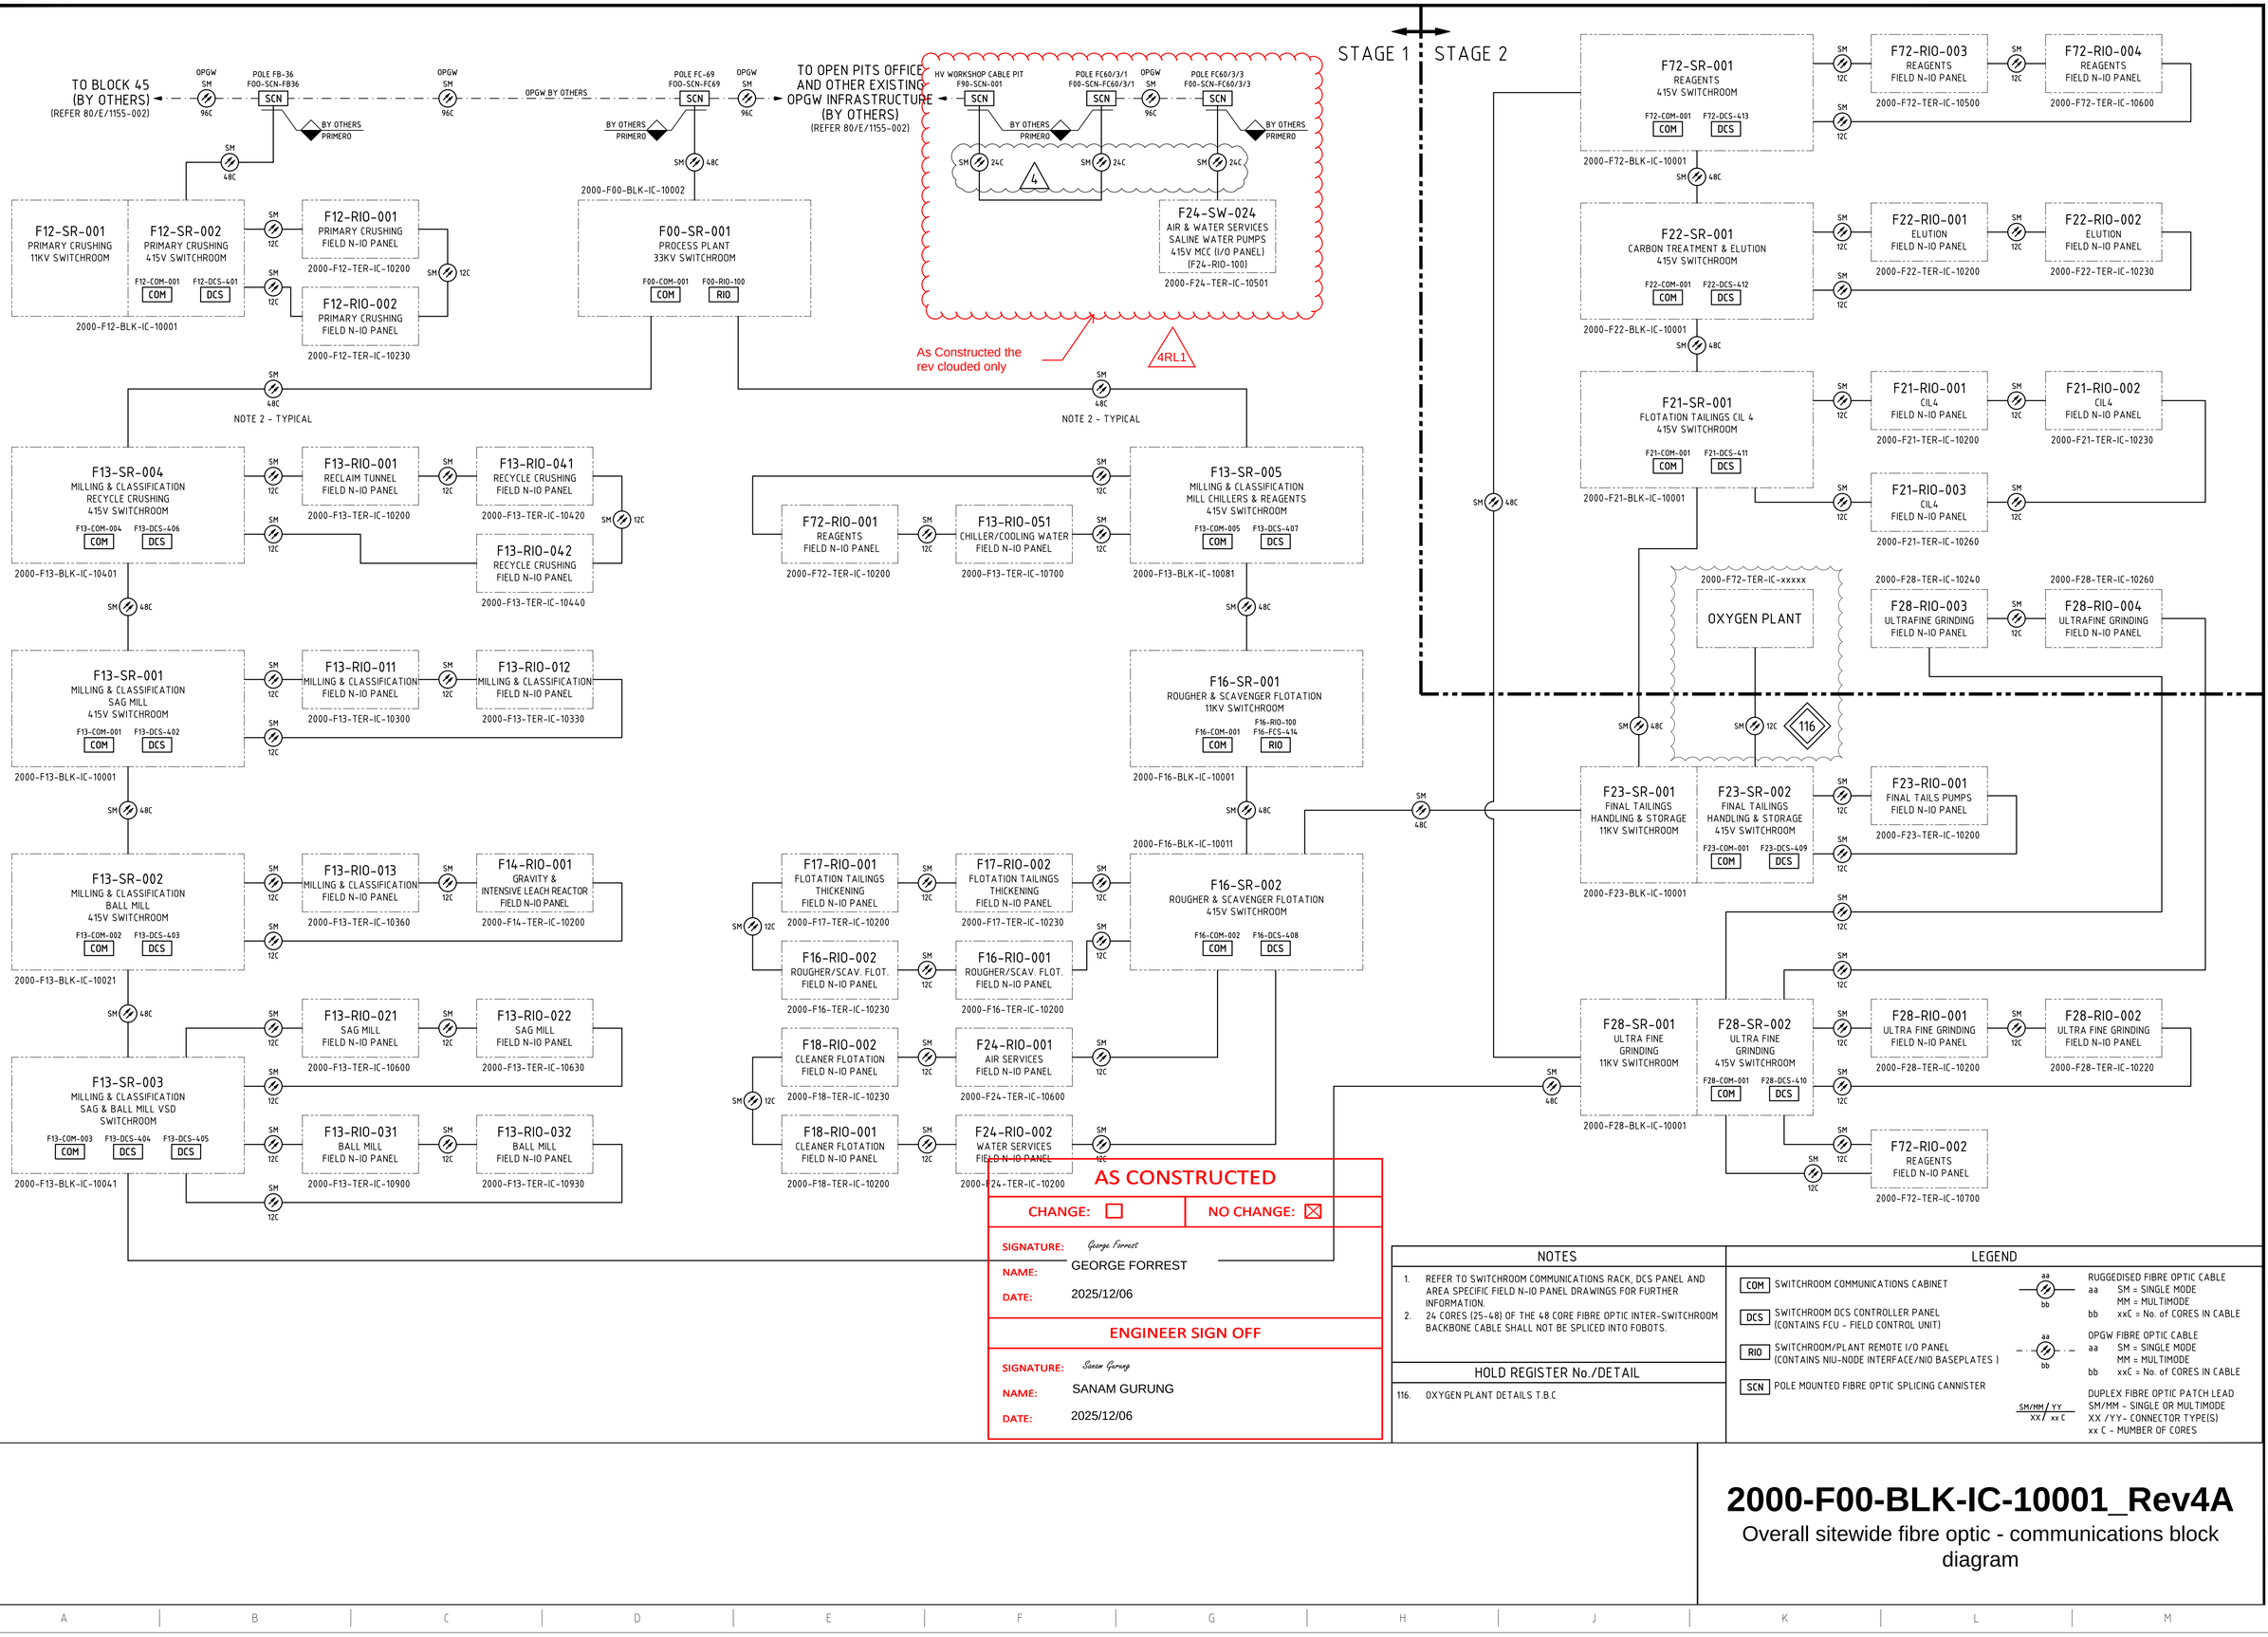



AS CONSTRUCTED

| CHANGE: ☐ | NO CHANGE: ☒ |
|---|---|

SIGNATURE: George Forrest
NAME: GEORGE FORREST
DATE: 2025/12/06

ENGINEER SIGN OFF

SIGNATURE: Sanam Gurung
NAME: SANAM GURUNG
DATE: 2025/12/06

## NOTES

1. REFER TO SWITCHROOM COMMUNICATIONS RACK, DCS PANEL AND AREA SPECIFIC FIELD N-IO PANEL DRAWINGS FOR FURTHER INFORMATION.
2. 24 CORES (25-48) OF THE 48 CORE FIBRE OPTIC INTER-SWITCHROOM BACKBONE CABLE SHALL NOT BE SPLICED INTO FOBOTS.

## HOLD REGISTER No./DETAIL

116. OXYGEN PLANT DETAILS T.B.C

## LEGEND

- COM — SWITCHROOM COMMUNICATIONS CABINET
- DCS — SWITCHROOM DCS CONTROLLER PANEL (CONTAINS FCU - FIELD CONTROL UNIT)
- RIO — SWITCHROOM/PLANT REMOTE I/O PANEL (CONTAINS NIU-NODE INTERFACE/NIO BASEPLATES )
- SCN — POLE MOUNTED FIBRE OPTIC SPLICING CANNISTER

RUGGEDISED FIBRE OPTIC CABLE
aa SM = SINGLE MODE
MM = MULTIMODE
bb xxC = No. of CORES IN CABLE

OPGW FIBRE OPTIC CABLE
aa SM = SINGLE MODE
MM = MULTIMODE
bb xxC = No. of CORES IN CABLE

DUPLEX FIBRE OPTIC PATCH LEAD
SM/MM - SINGLE OR MULTIMODE
XX /YY- CONNECTOR TYPE(S)
xx C - MUMBER OF CORES

# 2000-F00-BLK-IC-10001_Rev4A

Overall sitewide fibre optic - communications block diagram

O:\CAD PROJECTS\235 NORTHERN STAR RESOURCES LTD\235157 KCGM GROWTH PROJECT\03 DELIVERABLES\C\F00 - GENERAL FIMISTON SITE\2000-F00-BLK-IC-10001.DWG 210CT25 9:43AM HOTSEAT04