
F23-SR-002
415V FINAL TAILS PUMPS SWITCHROOM

F23-SW-023
FINAL TAILS PUMPS 415V MOTOR CONTROL CENTRE

CONTINUED ON SHT 1
2000-F23-SLD-EL-10201

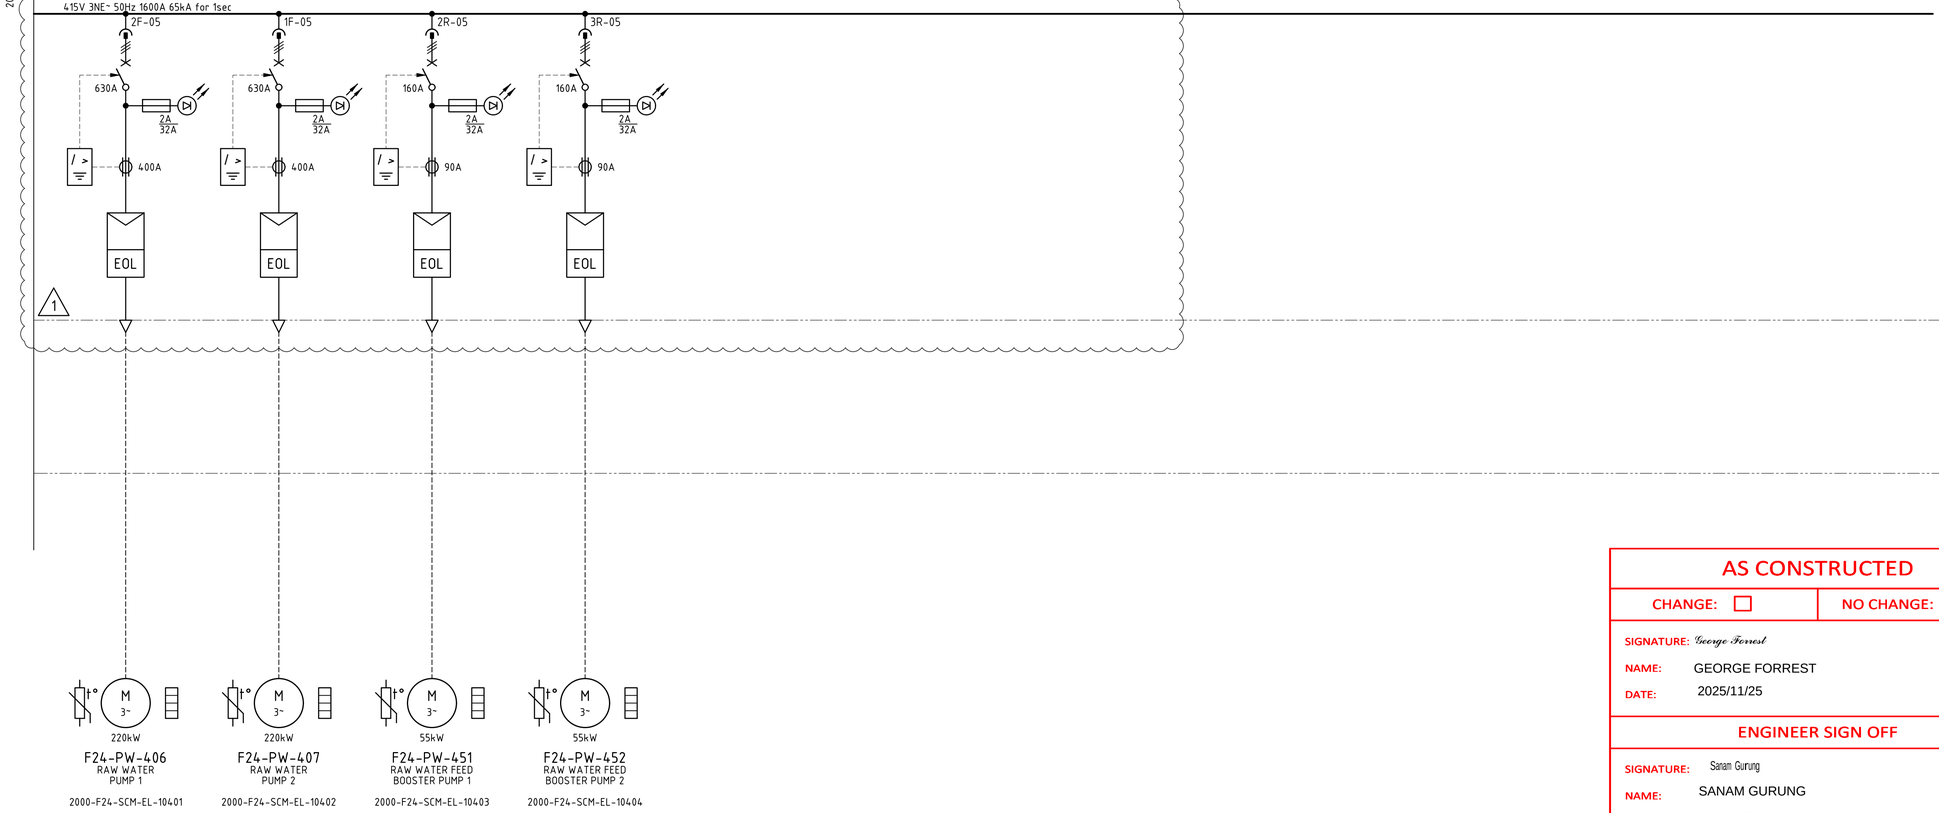

NOTES

1. REFER TO SHEET 1.

LEGEND

1. REFER TO SHEET 1.

AS CONSTRUCTED

CHANGE: ☐ NO CHANGE: ☒

SIGNATURE: George Forrest
NAME: GEORGE FORREST
DATE: 2025/11/25

ENGINEER SIGN OFF

SIGNATURE: Sanam Gurung
NAME: SANAM GURUNG
DATE: 2025/11/25

2000-F23-SLD-EL-10202_Rev1A

Final tailings handling & storage F23-SW-023 415V MCC single line diagram sheet 2

O:\CAD PROJECTS\235 NORTHERN STAR RESOURCES LTD\23517 KCGM GROWTH PROJECT\03 DELIVERABLES\ELF23 - FINAL TAILINGS HANDLING & STORAGE\2000-F23-SLD-EL-10202.DWG 020CT25 9:04AM HOTSEAT04