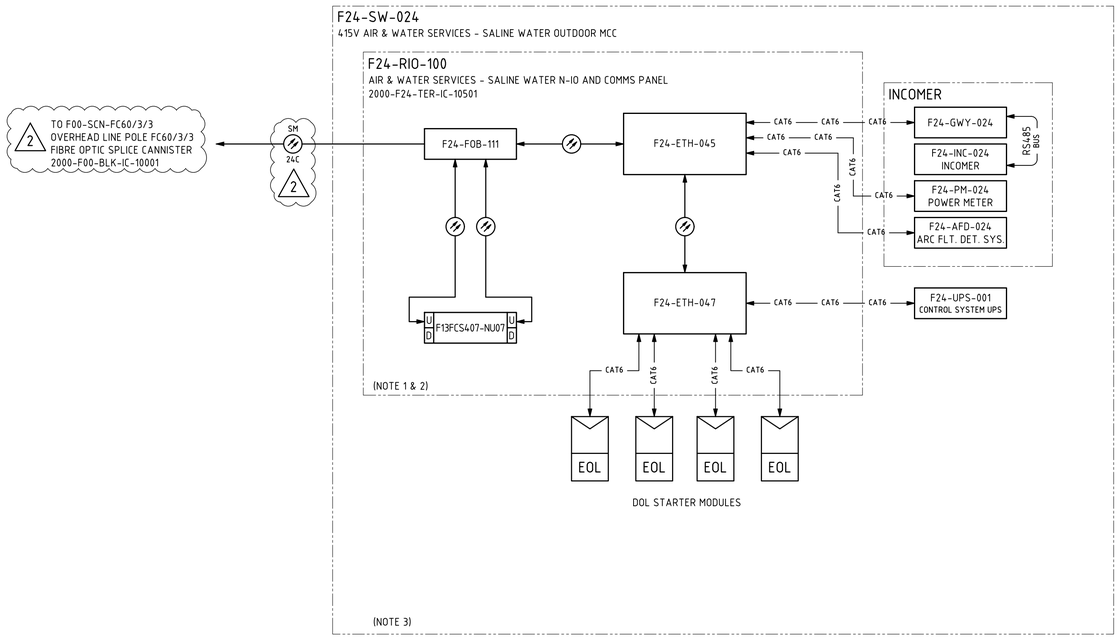



## NOTES

1. FOR INTERNAL FIBRE OPTIC, CAT6 PATCH LEAD EQUIPMENT CONNECTION DETAILS REFER TO SPECIFIC TERMINATION DIAGRAMS.
2. REFER TO SPECIFIC COMMUNICATIONS TERMINATION DRAWINGS FOR EXTERNAL EQUIPMENT CONNECTION DETAIL.
3. RIO PANEL, MCC & SWITCHBOARD HARDWARE/INTERCONNECTIONS (E.G. NIO NODE) & INTER-FOBOT PATCHING NOT SHOWN FOR CLARITY. REFER TO SPECIFIC COMMUNICATIONS TERMINATION DRGS FOR DETAIL.

## LEGEND

| | |
|---|---|
| FOB | FIBRE OPTIC BREAK OUT TRAY |
| ETH | ETHERNET SWITCH<br>HIRSCHMANN = DCS NETWORKS<br>CISCO = ALL OTHER NETWORKS |
| FCS | YOKOGAWA<br>FIELD CONTROL UNIT |
| xxxFCS4xx-NUxx U D | YOKOGAWA NODE INTERFACE UNIT<br>(DUAL OPTICAL ESB PORTS:<br>U = UPLINK, D = DOWNLINK)<br>TAG RELATED TO PARENT FCS |
| GWY | COMMUNICATIONS GATEWAY |
| MC | FIBRE TO CAT6<br>MEDIA CONVERTER |
| xxx | EQUIPMENT OR VENDOR PACKAGE<br>PANELS AS NOTED WITHIN BLOCK. |
| EOL | MCC MODULE<br>DOL INTELLIGENT ELECTRONIC<br>DEVICE/OVERLOAD |
| UPS | UNINTERRUPTIBLE POWER SUPPLY |
| | VSD - VARIABLE SPEED DRIVE<br>(WALL MOUNTED) |
| | MULTI CORE FIBRE OPTIC CABLE<br>OR DUPLEX PATCH LEAD |
| CAT6 | CAT6 ETHERNET CABLE CONNECTION |

**AS CONSTRUCTED**

| CHANGE: ☐ | NO CHANGE: ☒ |
|---|---|

SIGNATURE: George Forrest
NAME: GEORGE FORREST
DATE: 2025/12/06

**ENGINEER SIGN OFF**

SIGNATURE: Sanam Gurung
NAME: SANAM GURUNG
DATE: 2025/12/06

# 2000-F24-BLK-IC-10501_Rev2A

Saline water F24-SW-024 and remote IO communications block diagram

O:\CAD PROJECTS\235 NORTHERN STAR RESOURCES LTD\23517 KCGM GROWTH PROJECT\03 DELIVERABLES\IC\F24 - AIR & WATER SERVICES\2000-F24-BLK-IC-10501.DWG 16SEP25 4:04PM HOTSEAT04