CONTINUED ON DRAWING 30\E\1058-002

02F 1 | 03F 1 | 04F 1 | 05F 1 | 06F 1 | 06F 2 | 06F 3 | 06F 4 | 06F 5 | 06F 6 | 06F 7 | 07F 1 | 07F 2 | 07F 3 | 07F 4 | 07F 5

415V 3 PHASE 50Hz 2500A FORM 4 FAULT LEVEL 50kA FOR 1 sec.

415V 3 PHASE 50Hz 200A FORM 4 FAULT LEVEL 50kA FOR 1 sec.

630A | 630A | 800A | 800A NOTE 2. | 250A | 250A | ATS CONTROL CIRCUIT | 100A | 20A | 63A | 16A | 63A | 100A

INTEGRAL CIRCUIT BREAKER

415/110V 1000VA

CA3-43 | CT3-52

DB68 EMERGENCY

AFS

30-VS-62B | 30-VS-62C | NOTE 3.

VSD | OUTPUT REACTOR | 400 kW | 400 kW | RTD | 250 kW

BYPASS SWITCH & TRANSFORMER

30-SW-64 | 65-SW-61 | 30-PC-62 | 30-TH-61 | 22 kW

30-SW-64	415V 3 PHASE SUPPLY TO C.I.L. 3 MCC 30-SW-64 REF. DWG. 30\E\1061-001
65-SW-61	415V 3 PHASE SUPPLY TO ELUTION MCC 65-SW-61 REF. DWG. 65\E\
30-PP-62B	TAILINGS DISPOSAL PUMP No.2 REF. DWG. 30\E\0419 — TO PROCESS CONTROL CUBICLE
30-PP-62C	TAILINGS DISPOSAL PUMP No.3 REF. DWG. 30\E\0417 — REF DWG: 2000-F30-SCM-EL-10009 — TO PROCESS CONTROL CUBICLE
F30TK32B-PP01	CIL2 OXYGEN INJECTION PUMP 2 REF DWG. 2000-F30-SCH-EL-10009
AUTO TRANSFER SWITCH	
415V EMERGENCY SUPPLY	FROM SUBSTATION No.38DB80-SW-01 CB 30-SW-62 GENSET 80-GE-31 REF. DWG. 80\E\0302
AUTO TRANSFER SWITCH	LOGIC PANEL
SUB 78	EMERGENCY BUS FEEDER REF. DWG. 30\E\
30-PC-62	CIL3 PROCESS CONTROL CUBICLE FAN REF. DWG. 30\E\0414
30-XE-61	SUBSTATION No.68 240V UN INTERRUPTABLE POWER SUPPLY REF. DWG. 30\E\0414
30-DB-61	110V AC INSTRUMENT DISTRIBUTION BOARD REF. DWG. 30\E\1045-001
30-DB-62	240V AC INSTRUMENT DISTRIBUTION BOARD REF. DWG. 30\E\1045-002 REF. DWG. 2000-F30-TLD-EL-10001
CONTROL TRANSFORMER	FEEDER EMERGENCY
TIER 110V SUPPLY	REF. DWG. 30\E\
30-TH-61	FLOATATION TAILS CONCENTRATE THICKENER THICKENER No.3 CONTROL PANEL REF. DWG. 30\E\1045 REF DWG. 2000-F30-SCH-EL-10065
30-TH-61	FLOATATION TAILS CONCENTRATE THICKENER THICKENER No.3 REF. DWG. 30\E\1045 REF DWG. 2000-F30-SCH-EL-10065
SPACE	
DISTRIBUTION BOARD	EMERGENCY FEEDER FEED TO TIER 07F/4
DISTRIBUTION BOARD No.68	EMERGENCY FEEDER REF. DWG. 30\E\1045-004
CABLES FROM ATS	

CONTINUED ON DRAWING 30\E\1058-002

02R 1 | 03R 1 | 04R 1 | 05R 1 | 06R 1 | 06R 2 | 06R 3 | 06R 4 | 06R 5 | 06R 6 | 06R 7 | 7R 1 | 7R 2 | 07R 3 | 07R 4 | 07R 5

415V 3 PHASE 50Hz 2500A FORM 4 FAULT LEVEL 50kA FOR 1 sec.

250A | 100A | 100A | 250A | 20A | 20A | 32A | 32A | 250A

CA9-265 | EOL CEP7 | TORROID 200/5 1 | A/mA

415/110V 2000VA

16A L7 | N7 | 20A L3 | N3

30-PC-62

DB 68A

DB68 NORMAL

110 kW

AFS

OUTGOING CABLES	
OUTGOING CABLES	
OUTGOING CABLES	
OUTGOING CABLES	
F340D-F30TK62A-PP01	TANK TK62A OXYGEN INJECTION PUMP
TO PROCESS CONTROL CUBICLE	
SPARE	
SPARE	
DB 68A	DISTRIBUTION BOARD REF DWG. 2000-F30-TLD-EL-10003
SPARE	
MCC 110V AC BUS	REF. DWG. 30\E\0414
TIER 110V SUPPLY	REF. DWG. 30\E\0414
PROCESS CONTROL CUBICLE	30-PC-62 CIL 3 REF. DWG. 30\E\0414
SPACE	
F30-WO-64	NORTH SIDE CARBON IN LEACH AREA
F30-WO-63	SOUTH SIDE CARBON IN LEACH AREA
FEED TO TIER 07R/3	
DISTRIBUTION BOARD No.68	NORMAL FEEDER REF. DWG. 30\E\1045-003

NORTHERN STAR RESOURCES LIMITED

Approved	X
Approved as Noted	
Not Approved	
For Information Only	

Signed: C Laird — Date: 21/07/2025


ACCEPTANCE DOES NOT RELIEVE THE SUPPLIER / CONTRACTOR OF ITS RESPONSIBILITY OR LIABILITIES UNDER THE PURCHASE ORDER / CONTRACT

LEGEND

LOCATION

SUB STATION 68

30-SW-62

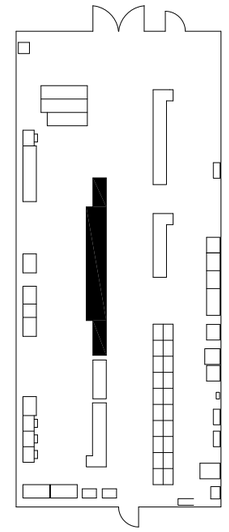

NOTES

1. ALL AFS (ARC FLASH SENSORS) ARE CONNECTED TO THE ARC FLASH RELAY VIA I/O UNITS
2. MCC FEEDER RE-PURPOSED AS PART OF THE KCGM GROWTH PROJECT.
3. VSD RE-PURPOSED AS PART OF THE KCGM GROWTH PROJECT.

LEGEND

- STAGE 1 - NEW
- STAGE 1 - REMOVE
- STAGE 1 - DECOMMISSIONED (OTHERS)
- STAGE 2 - NEW
- STAGE 2 - REMOVE
- STAGE 2 - DECOMMISSIONED (OTHERS)

KCGM GROWTH PROJECT

DRAWING NO. 2000-F30-SLD-EL-10102

REV	DATE	DESCRIPTION	CHECK	TECH APP
0	14/07/25	APPROVED FOR CONSTRUCTION		M

2000-F30-SLD-EL-10102_Rev0

Carbon in leach (CIL3) substation no. 68 MCC 30-SW-62 single line diagram sheet 3