
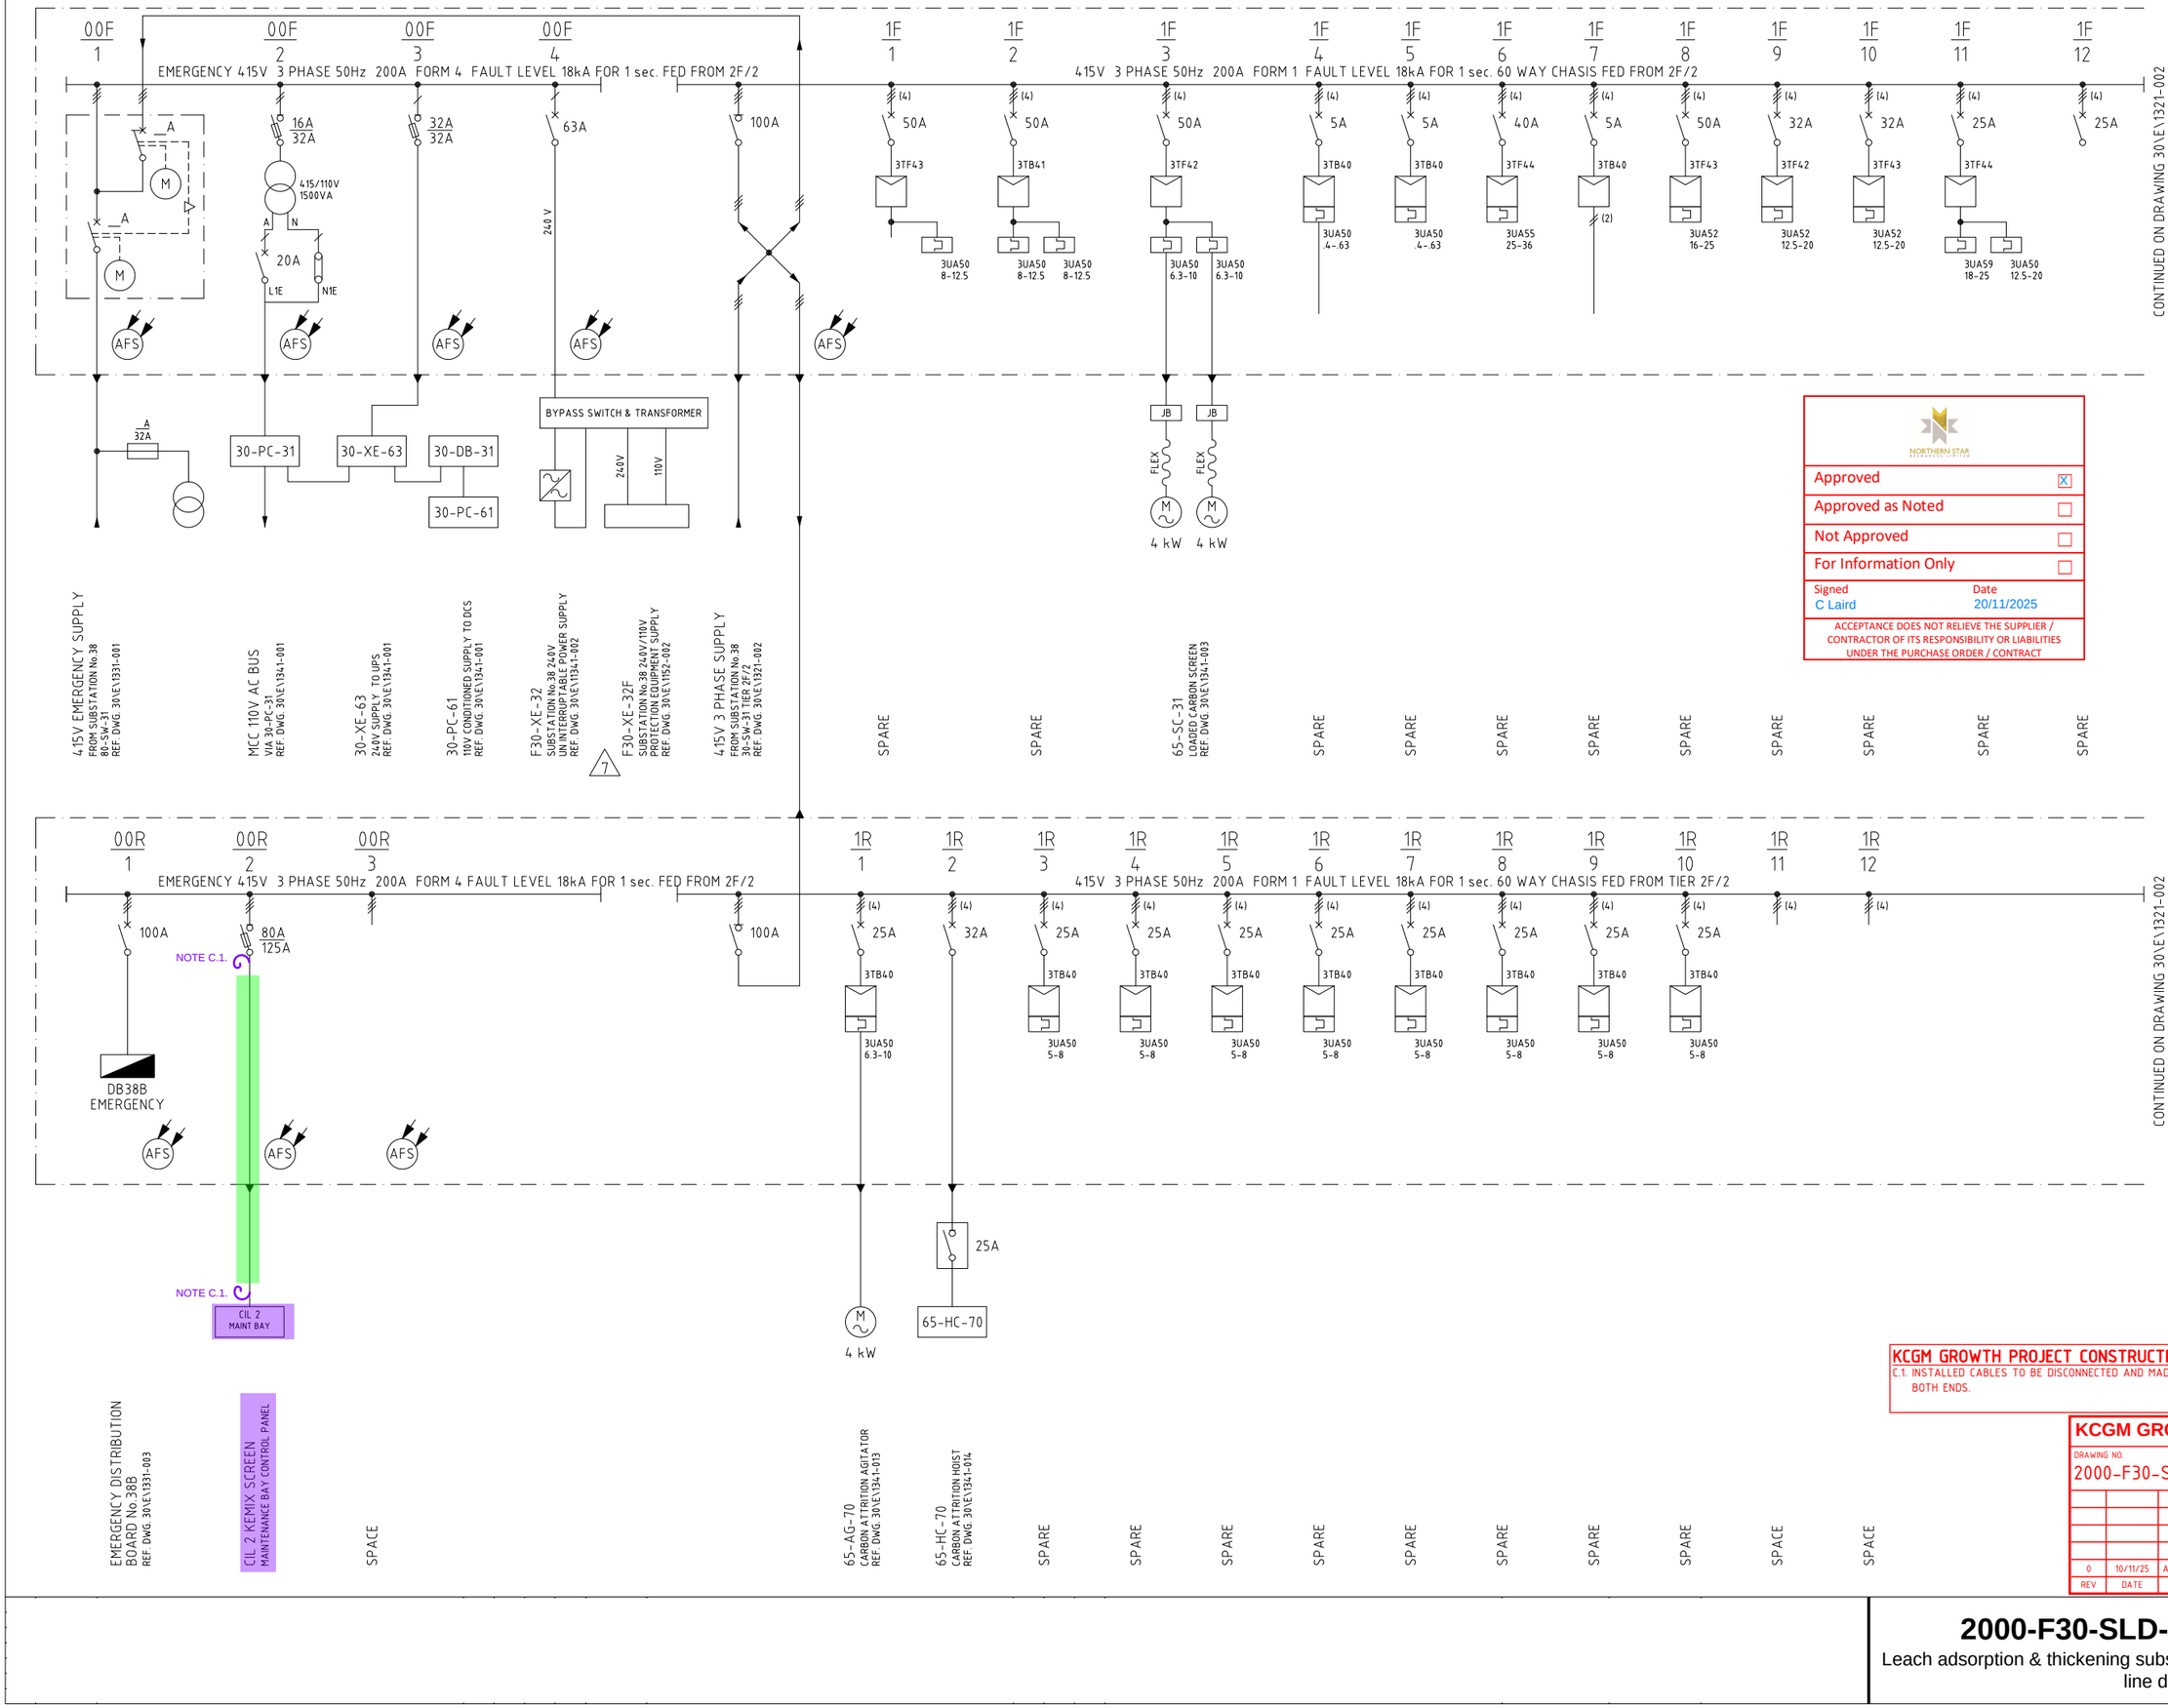


LEGEND

LOCATION

SUB STATION 38
30-SW-31

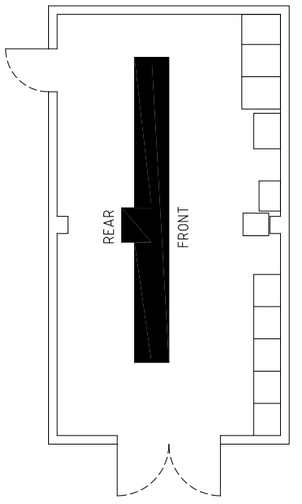

NOTES

1. WHERE DRIVES & FEEDERS REQUIRE 2 OFF CIRCUIT BREAKER AUXILLARIES THEN AN ADDITIONAL POLE SPACE IS REQUIRED.
   No. OF POLES USED SHOWN IN BRACKETS.
2. ALL AFS (ARC FLASH SENSORS) ARE CONNECTED TO THE ARC FLASH RELAY VIA I/O UNITS

Approved	X
Approved as Noted	
Not Approved	
For Information Only	

Signed: C Laird
Date: 20/11/2025

ACCEPTANCE DOES NOT RELIEVE THE SUPPLIER / CONTRACTOR OF ITS RESPONSIBILITY OR LIABILITIES UNDER THE PURCHASE ORDER / CONTRACT

KCGM GROWTH PROJECT CONSTRUCTION NOTES

C.1. INSTALLED CABLES TO BE DISCONNECTED AND MADE SAFE AT BOTH ENDS.

LEGEND
- EXISTING
- NON-EXISTENT
- STAGE 1 - NEW
- STAGE 1 - REMOVE
- STAGE 1 - DECOMMISSIONED (OTHERS)
- STAGE 2 - NEW
- STAGE 2 - REMOVE
- STAGE 2 - DECOMMISSIONED (OTHERS)

KCGM GROWTH PROJECT

DRAWING NO.
2000-F30-SLD-EL-10202

REV	DATE	DESCRIPTION	CHECK	TECH APP
0	10/11/25	APPROVED FOR CONSTRUCTION		DM

2000-F30-SLD-EL-10202_Rev0

Leach adsorption & thickening substation no. 38 MCC 30-SW-31 single line diagram