
CONTINUED FROM DWG. 34\E\0041-009

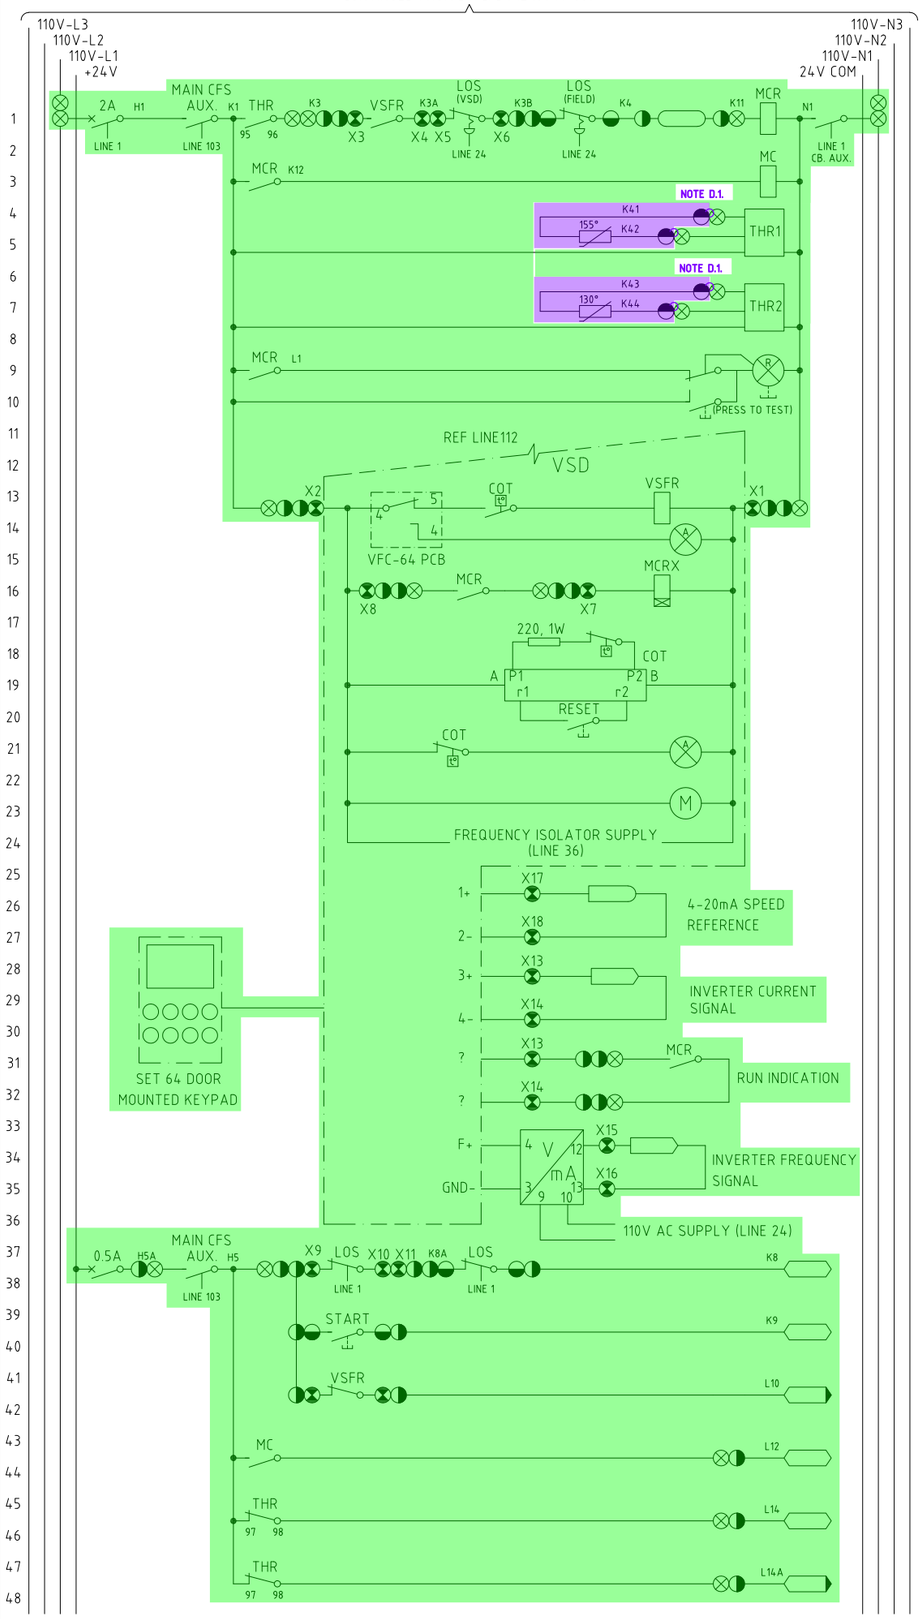

MAIN CONTACTOR RELAY
3, 5, 10, 46, 48

MAIN CONTACTOR
30, 100, 101, 102

THERMISTOR RELAY 1
THERMISTOR RELAY 2
NOTE: NOT FITTED TO ALL DRIVES

RUN INDICATION

VSD FAULT RELAY

CONTROLLER FAULT

START TIME DELAY RELAY

CUBICLE OVER TEMPERATURE ALARM RELAY

CUBICLE OVER TEMPERATURE

CUBICLE FANS

STOP INPUT

START INPUT

FAULT INPUT


RUN INPUT

THERMISTOR FAULT INPUT


NOTE: NOT FITTED TO ALL DRIVES

THERMISTOR ALARM INPUT

POWER LAYOUT

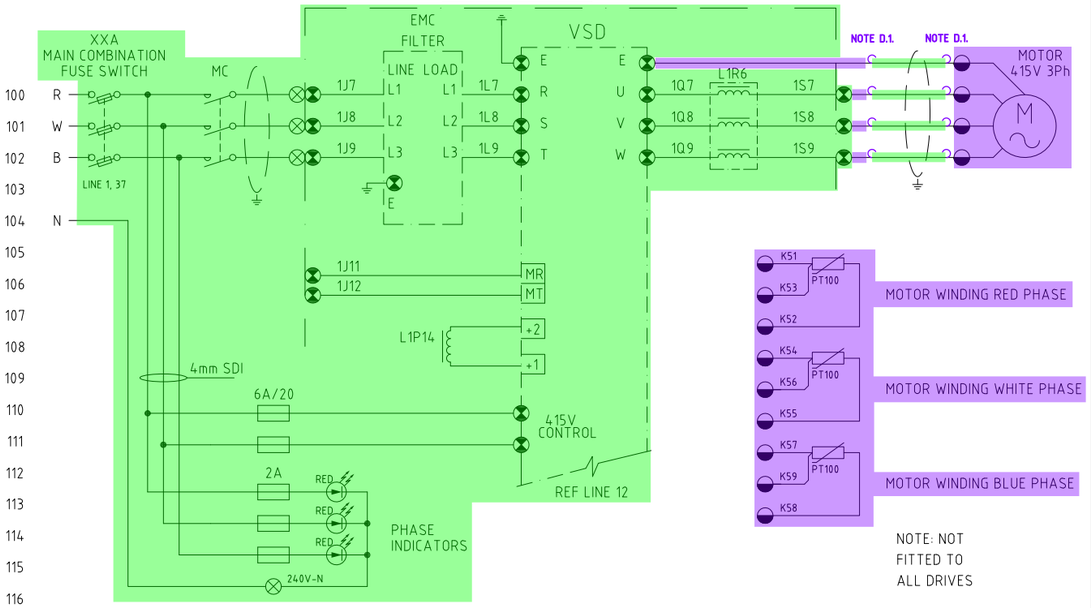

NOTE: NOT FITTED TO ALL DRIVES

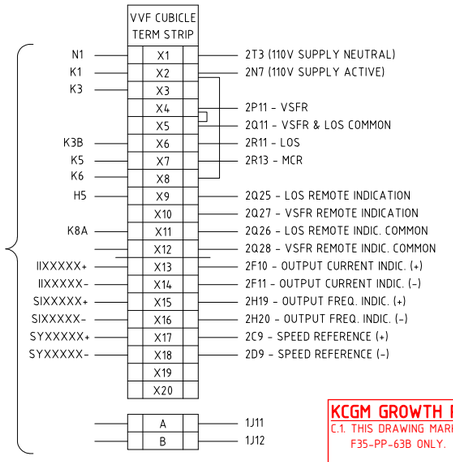

LEGEND

- EXISTING
- NON-EXISTENT
- STAGE 1 - NEW
- STAGE 1 - REMOVE
- STAGE 1 - DECOMMISSIONED (OTHERS)
- STAGE 2 - NEW
- STAGE 2 - REMOVE
- STAGE 2 - DECOMMISSIONED (OTHERS)

KCGM GROWTH PROJECT

DRAWING NO.
2000-F34-SCM-EL-10005

REV	DATE	DESCRIPTION	CHECK	TECH APP
0	25/07/25	APPROVED FOR CONSTRUCTION	RF	MB/DM

EQUIPMENT NUMBER	DESCRIPTION	MODULE NUMBER	FERRULE PREFIX	24V C.B No.	START OUTPUT	STOP INPUT	RUN INPUT	START INPUT
F34-PP-01	UFG MILL FEED PUMP	3F/4	PP01	R3/3	%Z013202	%Z013106	%Z013107	%Z013105
F34-PP-02	UFG CLASSIFICATION CYCLONE FEED PUMP	1F/5	PP02	R3/2	%Z013206	%Z013115	%Z013116	%Z013114
F35-PP-61A	CONCENTRATE THICKENER UNDERFLOW PUMP A	2F/4	PP61A	R7/3	%Z033211	%Z033302	%Z033303	%Z033301
F35-PP-63A	DESLIME CYCLONE FEED PUMP A	2F/5	PP63A	R7/5	%Z033215	%Z033315	%Z033316	%Z033314
F35-PP-63B	DESLIME CYCLONE FEED PUMP B	3F/5	PP63B	R7/6	%Z043202	%Z043106	%Z043107	%Z043105
F35-PP-65	UFG PLANT FEED PUMP	1F/4	PP62	R7/2	%Z033205	%Z033307	%Z033308	%Z033306

EQUIPMENT NUMBER	FAULT INPUT	THERMISTOR FAULT INPUT	THERMISTOR ALARM INPUT	REMOTE SPEED INPUT	SPEED INPUT LOOP No.	REMOTE CURRENT INPUT	CURRENT INPUT LOOP No.	REMOTE SPEED OUTPUT	SPEED OUTPUT LOOP No.	
F34-PP-01	%Z013108	%Z013109		%Z011107	SI34107	%Z011108	IT34106	%Z01110	SY34107	
F34-PP-02	%013117	%Z013118	%Z013119	%Z012103	SI34157	%Z012104	IT34156	%Z012102	SY34157	
F35-PP-61A	%Z033304	%Z033305		%Z032110	SI35307A	%Z032111	IT35310	%Z032109	SY35307A	
F35-PP-63A	%033317	%Z033318	%Z033319	%Z035102	SI35767	%Z035103	IT35678	%Z035101	SY35767	
F35-PP-63B	%Z043108	%Z043109	%Z043110	%Z041102	SI35787	%Z041103	IT35788	%Z041101	SY35787	
F35-PP-65	%Z033309			%Z032104	SI35737	%Z032105	IT35736	%Z032103	SY35737	

LEGEND

TERMINALS

- MOTOR CONTROL CENTRE (MCC)
- FIELD
- PROCESS CONTROL CUBICLE
- LINE CONDITIONER
- SOFT STARTER TERMINAL
- VARIABLE SPEED DRIVE
- DISTRIBUTION BOARD
- HV MOTOR CONTROL CENTRE
- MISC. ELECTRICAL DEVICE REFER NOTES FOR SPECIFIC DESC.

DIGITAL FUNCTIONS

- DCS INPUT
- DCS INPUT WITH ALARM FUNCTION
- DCS OUTPUT

ANALOGUE FUNCTION

- 4-20mA INPUT
- 4-20mA OUTPUT

ANCILLARY EQUIPMENT

- CIRCUIT BREAKER
- COMBINATION FUSE SWITCH
- ISOLATOR
- PUSH BUTTON
- LOS (LOCK OFF STOP)
- PULL WIRE SWITCH
- NORMALLY CLOSED CONTACT
- LIMIT SWITCH
- CONTACTOR CONTACT
- NORMALLY OPEN CONTACT
- TIMER CONTACT
- FUNCTION CONTACT
  - P - PRESSURE
  - T - TEMPERATURE
  - F - FLOW
  - L - FLOAT
- SIREN
- HORN
- RELAY
- LINK
- THERMISTOR
- INDICATION LAMP R - RED, G - GREEN, A - AMBER

VOLTAGES ON CONTROL BUS

- +24V - 24V DC DCS SUPPLY BUS
- 110V-L1 - 110V AC MCC CONTROL BUS
- 110V-L2 - 110V AC CONDITIONED BUS
- 110V-L3 - 110V AC NON CONDITIONED BUS

NOTES

KCGM GROWTH PROJECT CONSTRUCTION NOTES

C.1. THIS DRAWING MARKUP IS APPLICABLE TO F35-PP-63A AND F35-PP-63B ONLY.

KCGM GROWTH PROJECT DEMOLITION NOTES

D.1. VSD OUTGOING FIELD CABLES TO BE DISCONNECTED AND MADE SAFE AT BOTH ENDS.

2000-F34-SCM-EL-10005_Rev0

Ultrafine grinding substation no. 10 415V MCC 34-SW-02 control schematic diagram