
F13-SR-004
415V RECYCLE CRUSHING SWITCHROOM

F13-SW-014
RECYCLE CRUSHING 415V MOTOR CONTROL CENTRE

CONTINUED ON SHT 3
2000-F13-SLD-EL-10403

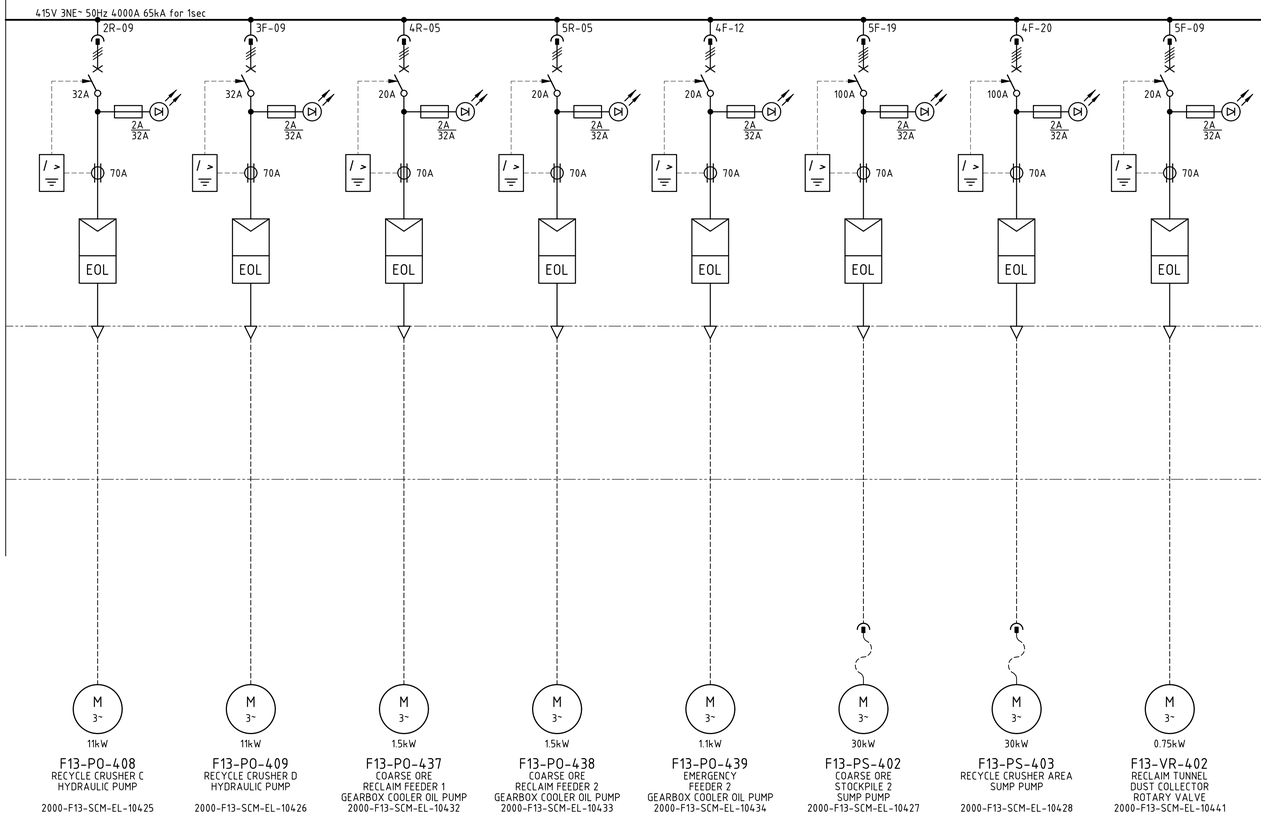

NOTES

1. REFER TO SHEET 1.

LEGEND

1. REFER TO SHEET 1.

DRG No.	REFERENCES	REV	DATE	DESCRIPTION	DRAW	CHECK	DESIGN	TECH APP	PROJ APP
2000-F13-SCM-EL-10403	F13-SW-014 415V MCC ARC FLASH SYSTEM SCHEMATIC DIAGRAM								
2000-F13-SCM-EL-10402	F13-SW-014 415V MCC 24VDC DISTRIBUTION SCHEMATIC DIAGRAM								
2000-F13-SCM-EL-10401	F13-SW-014 415V MCC INCOMER SCHEMATIC DIAGRAM								
2000-F13-DRG-EL-10106	F13-SR-004 415V SWITCHROOM ELECTRICAL EQUIPMENT LAYOUT								
2000-F13-BLK-IC-10401	F13-SR-004 415V SWITCHROOM AND REMOTE I/O COMMUNICATIONS BLOCK DIAGRAM								
2000-F13-SLD-EL-10401	F13-SW-014 415V MCC SINGLE LINE DIAGRAM SHEET 1	2	07SEP26	KCGM GROWTH PROJECT - SP1 AS-BUILT					
2000-F00-SLD-EL-10002	F00-SW-010 33kV SWITCHBOARD SINGLE LINE DIAGRAM SHEET 1 OF 5	1	09JUL25	FAT REDLINES INCORPORATED					
2000-F00-STD-EL-10001	GENERAL NOTES AND STANDARD DRAWINGS INDEX	0	11JUN24	APPROVED FOR CONSTRUCTION					

NORTHERN STAR RESOURCES LIMITED

PRIMERO
primero.com.au | DESIGN | CONSTRUCT | OPERATE

PRIMERO PROJECT NUMBER: 23517

INFORMATION AND REPRESENTATIONS ON THIS DRAWING ARE THE INTELLECTUAL PROPERTY OF PRIMERO UNLESS SPECIFICALLY IDENTIFIED OTHERWISE. ALL RIGHTS INCLUDING USE RESERVED

PROJECT: NORTHERN STAR RESOURCES LTD
KCGM GROWTH PROJECT

TITLE: MILLING & CLASSIFICATION - RECYCLE CRUSHING
F13-SW-014 415V MCC
SINGLE LINE DIAGRAM SHEET 4

SHEET	SCALE	DRG No.	REVISION
A1	NONE	2000-F13-SLD-EL-10404	2

O:\CAD PROJECTS\235 NORTHERN STAR RESOURCES LTD\23517 KCGM GROWTH PROJECT\03 DELIVERABLES\ELV\F13 - MILLING & CLASSIFICATION\2000-F13-SLD-EL-10404.DWG 04SEP26 9:56AM GRENVILLE.DEASY