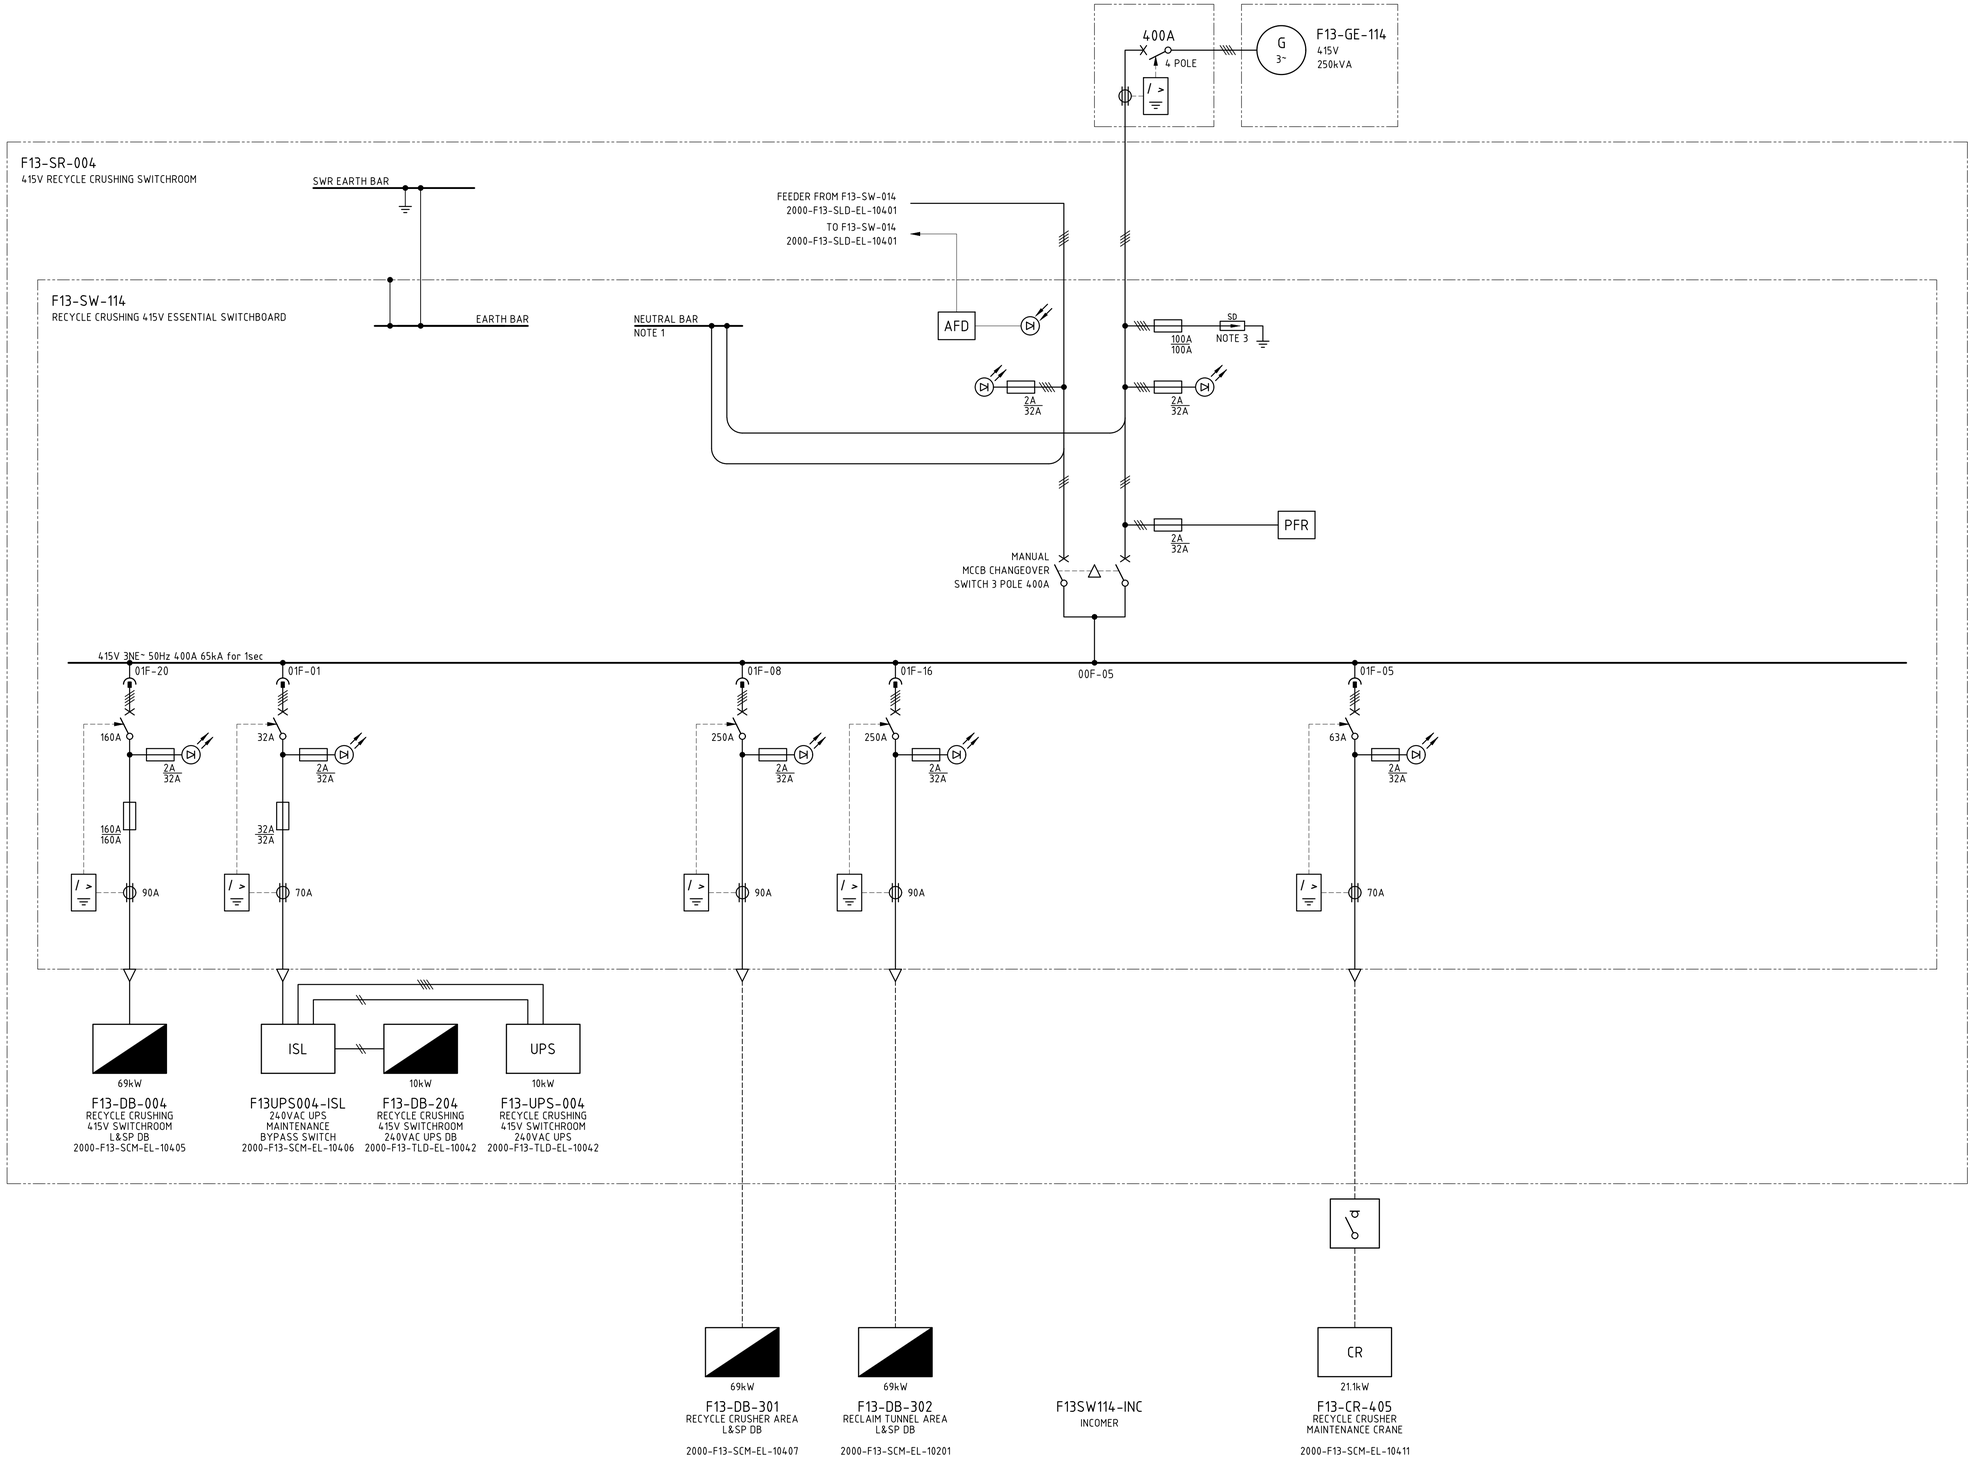


NOTES

1. EARTH-NEUTRAL LINK INSTALLED IN UPSTREAM F13-SW-014 INCOMER TIER. SIGNAGE SHALL BE PLACED ON F13-SW-114 SWITCHBOARD AND ON GENERATOR READING "M.E.N. LINK LOCATED IN F13-SW-014 INCOMER TIER"
2. SWITCHBOARD SHALL BE EXTENSIBLE AND BE PROVIDED WITH THE FACILITY TO EXTEND THE MAIN BUSBAR AND APPEND ADDITIONAL TIERS AT ONE END WITHOUT MAJOR STRUCTURAL DISASSEMBLY.
3. SURGE DIVERTERS SHALL PROVIDE FEEDBACK TO DCS VIA VOLT-FREE CONTACTS. SURGE DIVERTER FUSES SHALL BE SIZED BY VENDOR TO SUIT DUTY.
4. MINIATURE CIRCUIT BREAKERS SHALL BE SIZED AND RATED TO SUIT ACB AND INCOMER REQUIREMENTS.
5. CIRCUIT BREAKER TO BE SUBSTITUTED FOR FUSED-SWITCH WHERE REQUIRED BY EQUIPMENT MANUFACTURERS GUIDELINES.

LEGEND

PFR	PHASE FAILURE RELAY
/ >	EARTH LEAKAGE RELAY
xxxA / xxxA	ST TRIP SET POINT / CB SIZE
AFD	ARC FLASH DETECTION
ECR	EARTH CONTINUITY RELAY

DRG No.	REFERENCES
2000-F13-SCM-EL-10404	F13-SW-014 415V MCC ARC FLASH SYSTEM SCHEMATIC DIAGRAM
2000-F13-SCM-EL-10403	F13-SW-014 415V MCC 24VDC DISTRIBUTION SCHEMATIC DIAGRAM
2000-F13-SCM-EL-10443	F13-SW-114 415V ESSENTIAL SWITCHBOARD INCOMER SCHEMATIC DIAGRAM
2000-F13-DRG-EL-10106	F13-SR-004 415V SWITCHROOM ELECTRICAL EQUIPMENT LAYOUT
2000-F13-BLK-IC-10401	F13-SR-004 415V SWITCHROOM AND REMOTE I/O COMMUNICATIONS BLOCK DIAGRAM
2000-F13-SLD-EL-10401	F13-SW-014 415V MCC SINGLE LINE DIAGRAM SHEET 1
2000-F00-SLD-EL-10002	F00-SW-010 33kV SWITCHBOARD SINGLE LINE DIAGRAM SHEET 1 OF 5
2000-F00-STD-EL-10001	GENERAL NOTES AND STANDARD DRAWINGS INDEX

REV	DATE	DESCRIPTION	DRAW	CHECK	DESIGN	TECH APP	PROJ APP
2	07SEP26	KCGM GROWTH PROJECT - SP1 AS-BUILT					
1	09JUL25	FAT REDLINES INCORPORATED					
0	29AUG24	APPROVED FOR CONSTRUCTION					

NORTHERN STAR RESOURCES LIMITED

PRIMERO
primero.com.au | DESIGN | CONSTRUCT | OPERATE

PRIMERO PROJECT NUMBER: 23517

INFORMATION AND REPRESENTATIONS ON THIS DRAWING ARE THE INTELLECTUAL PROPERTY OF PRIMERO UNLESS SPECIFICALLY IDENTIFIED OTHERWISE. ALL RIGHTS INCLUDING USE RESERVED

PROJECT: NORTHERN STAR RESOURCES LTD
KCGM GROWTH PROJECT

TITLE: MILLING & CLASSIFICATION - RECYCLE CRUSHING
F13-SW-114 415V ESSENTIAL SWITCHBOARD
SINGLE LINE DIAGRAM

SHEET	SCALE	DRG No.	REVISION
A1	NONE	2000-F13-SLD-EL-10411	2

O:\CAD PROJECTS\235 NORTHERN STAR RESOURCES LTD\235117 KCGM GROWTH PROJECT\03 DELIVERABLES\ELV\F13 - MILLING & CLASSIFICATION\2000-F13-SLD-EL-10411DWG 04:SEP26 9:57AM GRENVILLE.DEASY