
CONTINUED ON SHT 2
2000-F13-SLD-EL-10702

F13-SR-005
415V MILL CHILLERS & REAGENTS SWITCHROOM

F13-SW-020
MILL CHILLERS & REAGENTS 415V MOTOR CONTROL CENTRE

CONTINUED ON SHT 4
2000-F13-SLD-EL-10704

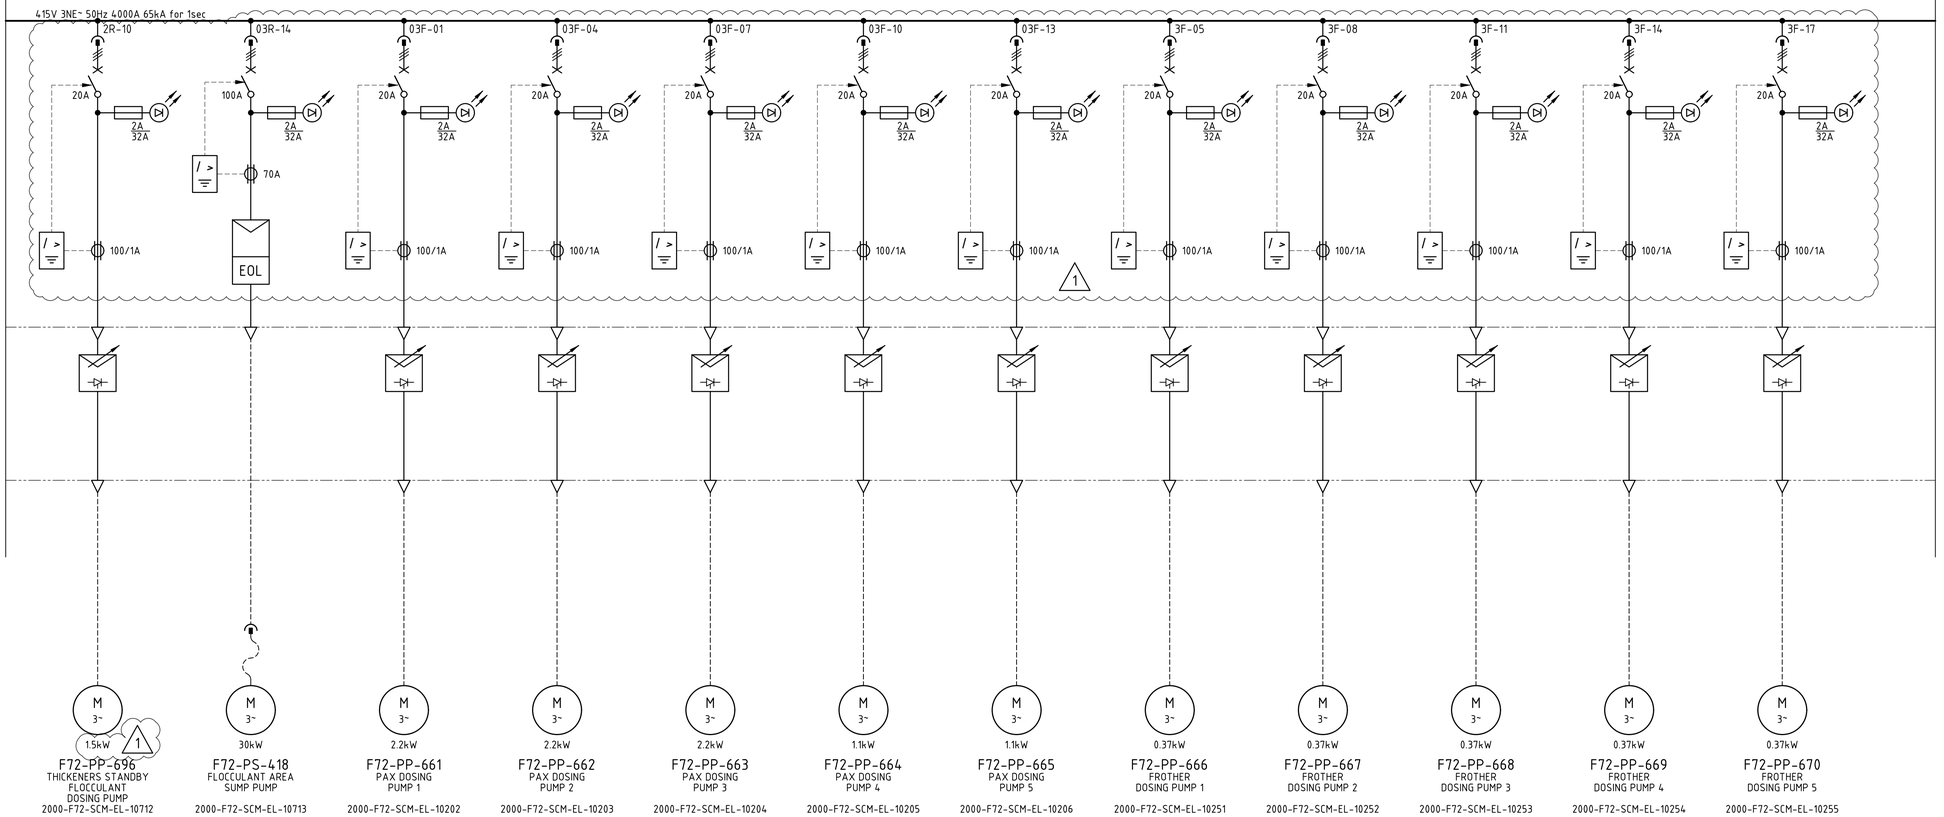

NOTES

1. REFER TO SHEET 1.

LEGEND

1. REFER TO SHEET 1.

2000-F13-SCM-EL-10703	F13-SW-020 415V MCC ARC FLASH SYSTEM SCHEMATIC DIAGRAM								
2000-F13-SCM-EL-10702	F13-SW-020 415V MCC 24VDC DISTRIBUTION SCHEMATIC DIAGRAM								
2000-F13-SCM-EL-10701	F13-SW-020 415V MCC INCOMER SCHEMATIC DIAGRAM								
2000-F13-DRG-EL-10121	F13-SR-005 415V SWITCHROOM ELECTRICAL EQUIPMENT LAYOUT								
2000-F13-BLK-EL-10341	F13-SR-005 415V SWITCHROOM AND REMOTE I/O COMMUNICATIONS BLOCK DIAGRAM								
2000-F13-SLD-EL-10701	F13-SW-020 415V MCC SINGLE LINE DIAGRAM SHEET 1								
2000-F00-SLD-EL-10002	F00-SW-010 33kV SWITCHBOARD SINGLE LINE DIAGRAM SHEET 1 OF 5	1	29MAY25	FAT REDLINES INCORPORATED	[redacted]				
2000-F00-STD-EL-10001	GENERAL NOTES AND STANDARD DRAWINGS INDEX	0	25MAR24	APPROVED FOR CONSTRUCTION					
DRG No.	REFERENCES	REV	DATE	DESCRIPTION	DRAW	CHECK	DESIGN	TECH APP	PROJ APP

NORTHERN STAR RESOURCES LIMITED

INFORMATION AND REPRESENTATIONS ON THIS DRAWING ARE THE INTELLECTUAL PROPERTY OF PRIMERO UNLESS SPECIFICALLY IDENTIFIED OTHERWISE. ALL RIGHTS INCLUDING USE RESERVED

PRIMERO
primero.com.au | DESIGN | CONSTRUCT | OPERATE

PRIMERO PROJECT NUMBER: 23517

Approved	X
Approved as Noted	
Not Approved	
For Information Only	

Signed [redacted] Date 24.06.2025

ACCEPTANCE DOES NOT RELIEVE THE SUPPLIER / CONTRACTOR OF ITS RESPONSIBILITY OR LIABILITIES UNDER THE PURCHASE ORDER / CONTRACT

PROJECT: NORTHERN STAR RESOURCES LTD
KCGM GROWTH PROJECT

TITLE: MILLING & CLASSIFICATION
F13-SW-020 415V MCC
SINGLE LINE DIAGRAM SHEET 3

SHEET	SCALE	DRG No.	REVISION
A1	NONE	2000-F13-SLD-EL-10703	1

O:\CAD PROJECTS\235 NORTHERN STAR RESOURCES LTD\23517 KCGM GROWTH PROJECT\03 DELIVERABLES\EL\F13 - MILLING & CLASSIFICATION\2000-F13-SLD-EL-10703.DWG 30MAY25 8:08AM SANDRA CULL