
CONTINUED ON SHT 3
2000-F13-SLD-EL-10903

CONTINUED ON SHT 5
2000-F13-SLD-EL-10905

F13-SR-002
415V BALL MILL SWITCHROOM

F13-SW-003
BALL MILL 415V MOTOR CONTROL CENTRE

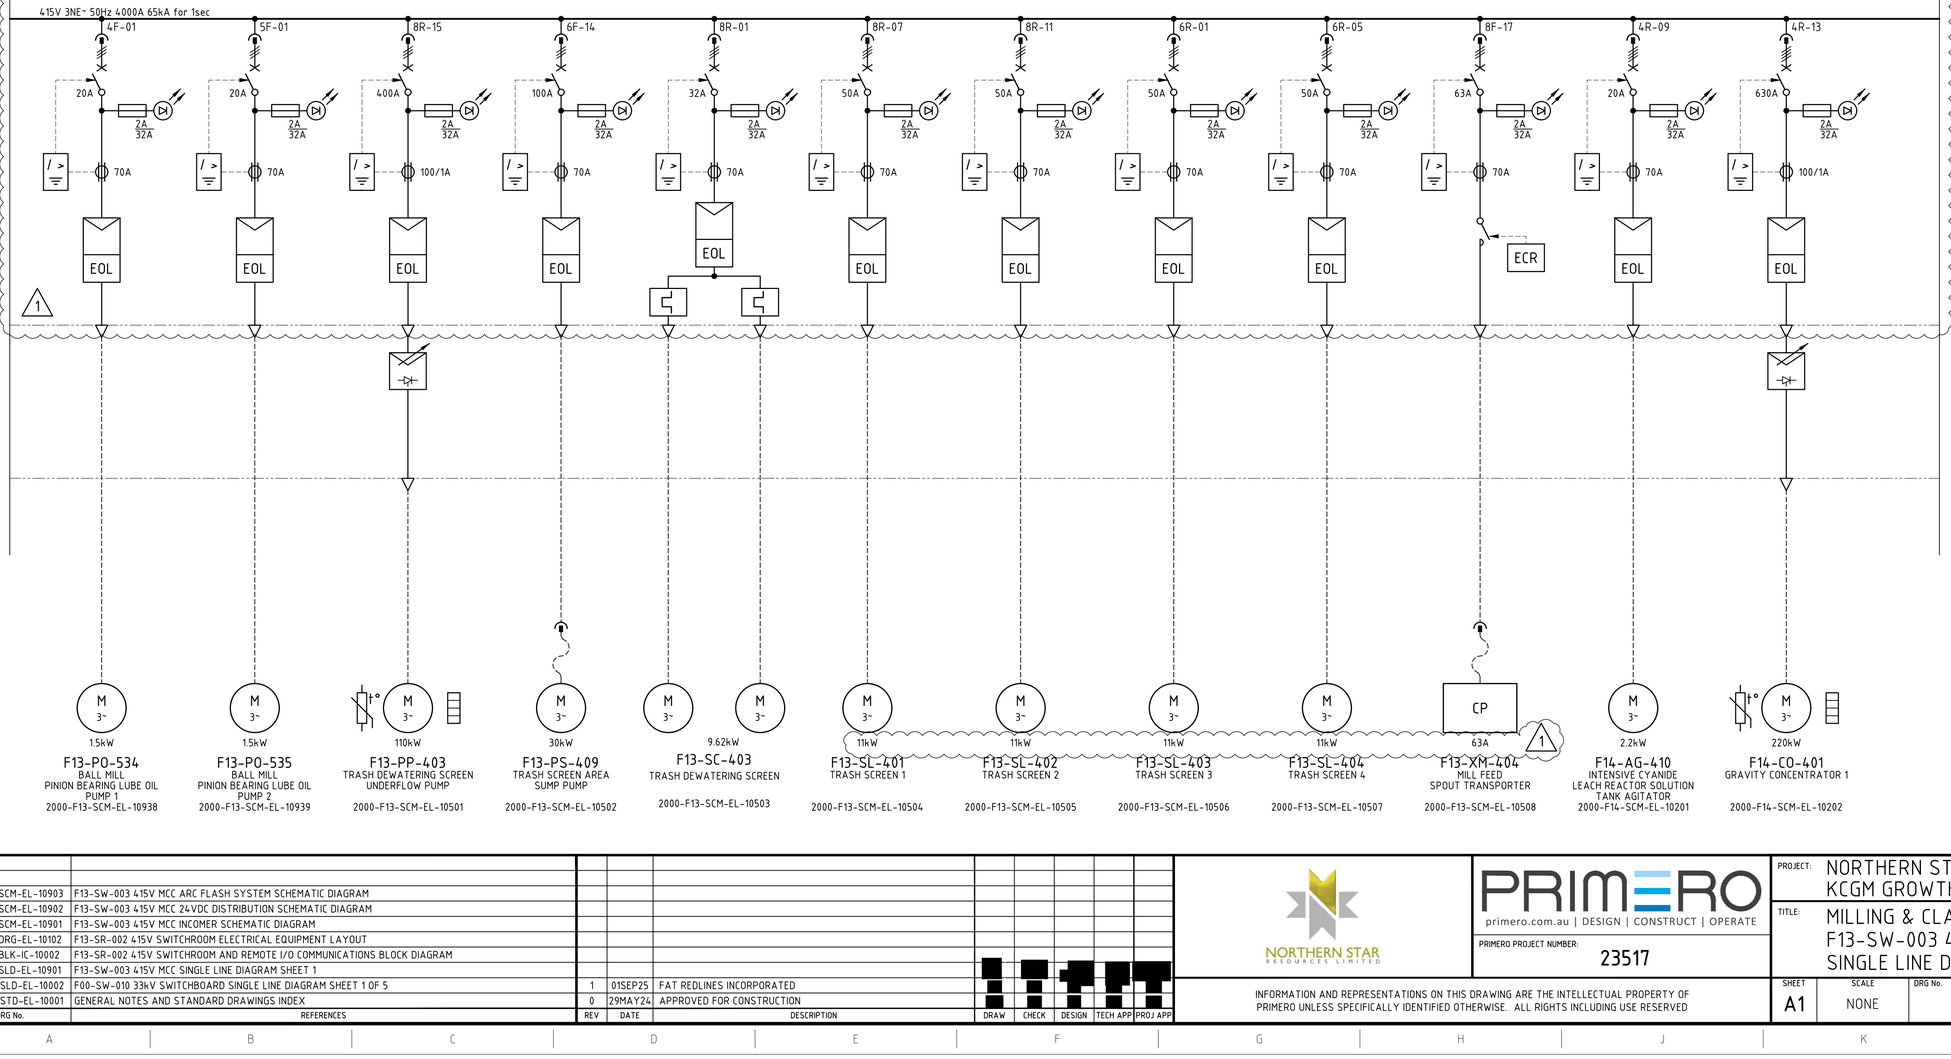

NOTES

1. REFER TO SHEET 1.

LEGEND

1. REFER TO SHEET 1.

2000-F13-SCM-EL-10903	F13-SW-003 415V MCC ARC FLASH SYSTEM SCHEMATIC DIAGRAM									
2000-F13-SCM-EL-10902	F13-SW-003 415V MCC 24VDC DISTRIBUTION SCHEMATIC DIAGRAM									
2000-F13-SCM-EL-10901	F13-SW-003 415V MCC INCOMER SCHEMATIC DIAGRAM									
2000-F13-DRG-EL-10102	F13-SR-002 415V SWITCHROOM ELECTRICAL EQUIPMENT LAYOUT									
2000-F13-BLK-IC-10002	F13-SR-002 415V SWITCHROOM AND REMOTE I/O COMMUNICATIONS BLOCK DIAGRAM									
2000-F13-SLD-EL-10901	F13-SW-003 415V MCC SINGLE LINE DIAGRAM SHEET 1									
2000-F00-SLD-EL-10002	F00-SW-010 33kV SWITCHBOARD SINGLE LINE DIAGRAM SHEET 1 OF 5	1	01SEP25	FAT REDLINES INCORPORATED						
2000-F00-STD-EL-10001	GENERAL NOTES AND STANDARD DRAWINGS INDEX	0	29MAY24	APPROVED FOR CONSTRUCTION						
DRG No.	REFERENCES	REV	DATE	DESCRIPTION	DRAW	CHECK	DESIGN	TECH APP	PROJ APP	

NORTHERN STAR RESOURCES LIMITED

INFORMATION AND REPRESENTATIONS ON THIS DRAWING ARE THE INTELLECTUAL PROPERTY OF PRIMERO UNLESS SPECIFICALLY IDENTIFIED OTHERWISE. ALL RIGHTS INCLUDING USE RESERVED

PRIMERO
primero.com.au | DESIGN | CONSTRUCT | OPERATE

PRIMERO PROJECT NUMBER: 23517

NORTHERN STAR RESOURCES LIMITED

Approved	X
Approved as Noted	
Not Approved	
For Information Only	

Signed [redacted] Date 09/10/2025

ACCEPTANCE DOES NOT RELIEVE THE SUPPLIER / CONTRACTOR OF ITS RESPONSIBILITY OR LIABILITIES UNDER THE PURCHASE ORDER / CONTRACT

PROJECT: NORTHERN STAR RESOURCES LTD
KCGM GROWTH PROJECT

TITLE: MILLING & CLASSIFICATION - BALL MILL
F13-SW-003 415V MCC
SINGLE LINE DIAGRAM SHEET 4

SHEET	SCALE	DRG No.	REVISION
A1	NONE	2000-F13-SLD-EL-10904	1

O:\CAD PROJECTS\235 NORTHERN STAR RESOURCES LTD\23517 KCGM GROWTH PROJECT\03 DELIVERABLES\ELV\F13 - MILLING & CLASSIFICATION\2000-F13-SLD-EL-10904.DWG 25SEP25 12:52PM HOTSEAT04