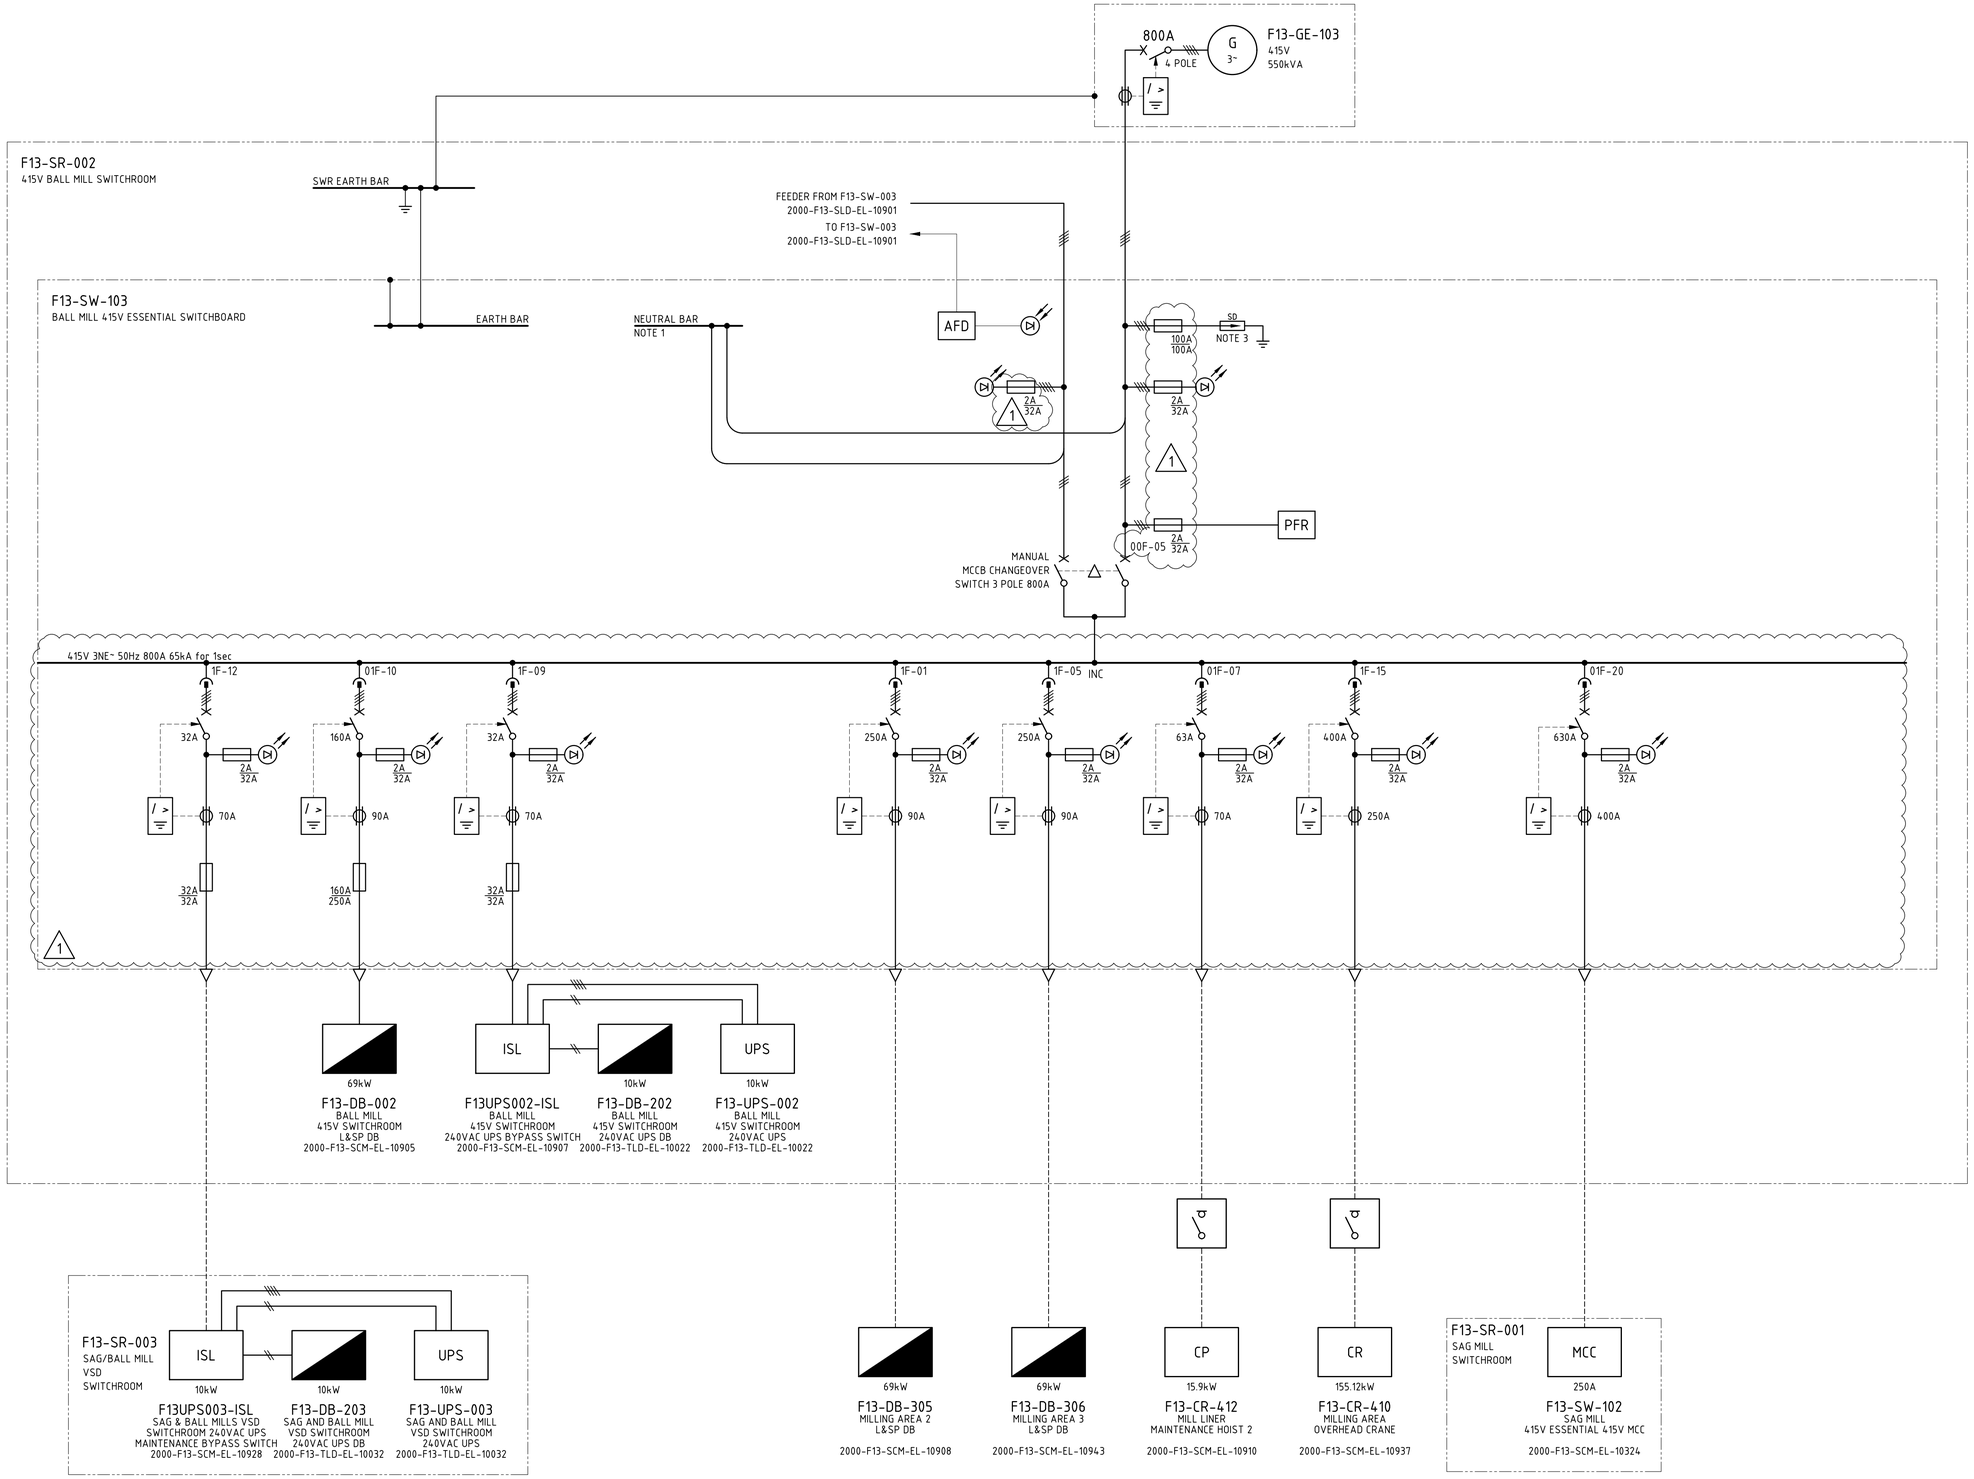



## NOTES

1. EARTH-NEUTRAL LINK INSTALLED IN UPSTREAM F13-SW-003 INCOMER TIER. SIGNAGE SHALL BE PLACED ON F13-SW-103 SWITCHBOARD AND ON GENERATOR READING "M.E.N. LINK LOCATED IN F13-SW-003 INCOMER TIER"
2. SWITCHBOARD SHALL BE EXTENSIBLE AND BE PROVIDED WITH THE FACILITY TO EXTEND THE MAIN BUSBAR AND APPEND ADDITIONAL TIERS AT ONE END WITHOUT MAJOR STRUCTURAL DISASSEMBLY.
3. SURGE DIVERTERS SHALL PROVIDE FEEDBACK TO DCS VIA VOLT-FREE CONTACTS. SURGE DIVERTER FUSES SHALL BE SIZED BY VENDOR TO SUIT DUTY.
4. MINIATURE CIRCUIT BREAKERS SHALL BE SIZED AND RATED TO SUIT ACB AND INCOMER REQUIREMENTS.
5. CIRCUIT BREAKER TO BE SUBSTITUTED FOR FUSED-SWITCH WHERE REQUIRED BY EQUIPMENT MANUFACTURERS GUIDELINES.

## LEGEND

| | |
|---|---|
| PFR | PHASE FAILURE RELAY |
| / > | EARTH LEAKAGE RELAY |
| xxxA / xxxA | ST TRIP SET POINT / CB SIZE |
| AFD | ARC FLASH DETECTION |
| ECR | EARTH CONTINUITY RELAY |

NORTHERN STAR RESOURCES LIMITED

| | |
|---|---|
| Approved | X |
| Approved as Noted | |
| Not Approved | |
| For Information Only | |

Signed [redacted] Date 09/10/2025

ACCEPTANCE DOES NOT RELIEVE THE SUPPLIER / CONTRACTOR OF ITS RESPONSIBILITY OR LIABILITIES UNDER THE PURCHASE ORDER / CONTRACT

| DRG No. | REFERENCES |
|---|---|
| 2000-F13-SCM-EL-10904 | F13-SW-003 415V MCC ARC FLASH SYSTEM SCHEMATIC DIAGRAM |
| 2000-F13-SCM-EL-10903 | F13-SW-003 415V MCC 24VDC DISTRIBUTION SCHEMATIC DIAGRAM |
| 2000-F13-SCM-EL-10953 | F13-SW-103 415V ESSENTIAL SWITCHBOARD INCOMER SCHEMATIC DIAGRAM |
| 2000-F13-DRG-EL-10102 | F13-SR-002 415V SWITCHROOM ELECTRICAL EQUIPMENT LAYOUT |
| 2000-F13-BLK-IC-10001 | F13-SR-002 415V SWITCHROOM AND REMOTE I/O COMMUNICATIONS BLOCK DIAGRAM |
| 2000-F13-SLD-EL-10901 | F13-SW-901 415V MCC SINGLE LINE DIAGRAM SHEET 1 |
| 2000-F00-SLD-EL-10002 | F00-SW-010 33kV SWITCHBOARD SINGLE LINE DIAGRAM SHEET 1 OF 5 |
| 2000-F00-STD-EL-10001 | GENERAL NOTES AND STANDARD DRAWINGS INDEX |

| REV | DATE | DESCRIPTION | DRAW | CHECK | DESIGN | TECH APP | PROJ APP |
|---|---|---|---|---|---|---|---|
| 1 | 02SEP25 | FAT REDLINES INCORPORATED | | | | | |
| 0 | 29AUG24 | APPROVED FOR CONSTRUCTION | | | | | |

NORTHERN STAR RESOURCES LIMITED

PRIMERO
primero.com.au | DESIGN | CONSTRUCT | OPERATE

PRIMERO PROJECT NUMBER: 23517

INFORMATION AND REPRESENTATIONS ON THIS DRAWING ARE THE INTELLECTUAL PROPERTY OF PRIMERO UNLESS SPECIFICALLY IDENTIFIED OTHERWISE. ALL RIGHTS INCLUDING USE RESERVED

PROJECT: NORTHERN STAR RESOURCES LTD
KCGM GROWTH PROJECT

TITLE: MILLING & CLASSIFICATION - BALL MILL
F13-SW-103 415V ESSENTIAL SWITCHBOARD
SINGLE LINE DIAGRAM

| SHEET | SCALE | DRG No. | REVISION |
|---|---|---|---|
| A1 | NONE | 2000-F13-SLD-EL-10911 | 1 |

O:\CAD PROJECTS\23517 NORTHERN STAR RESOURCES LTD\23517 KCGM GROWTH PROJECT\03 DELIVERABLES\ELF13 - MILLING & CLASSIFICATION\2000-F13-SLD-EL-10911.DWG 25SEP25 12:53PM HOTSEAT04