
F16-SR-002
415V FLOTATION SWITCHROOM

F16-SW-005
FLOTATION BLOWERS & COMPRESSORS 415V MOTOR CONTROL CENTRE

CONTINUED ON SHT 1
2000-F16-SLD-EL-10211

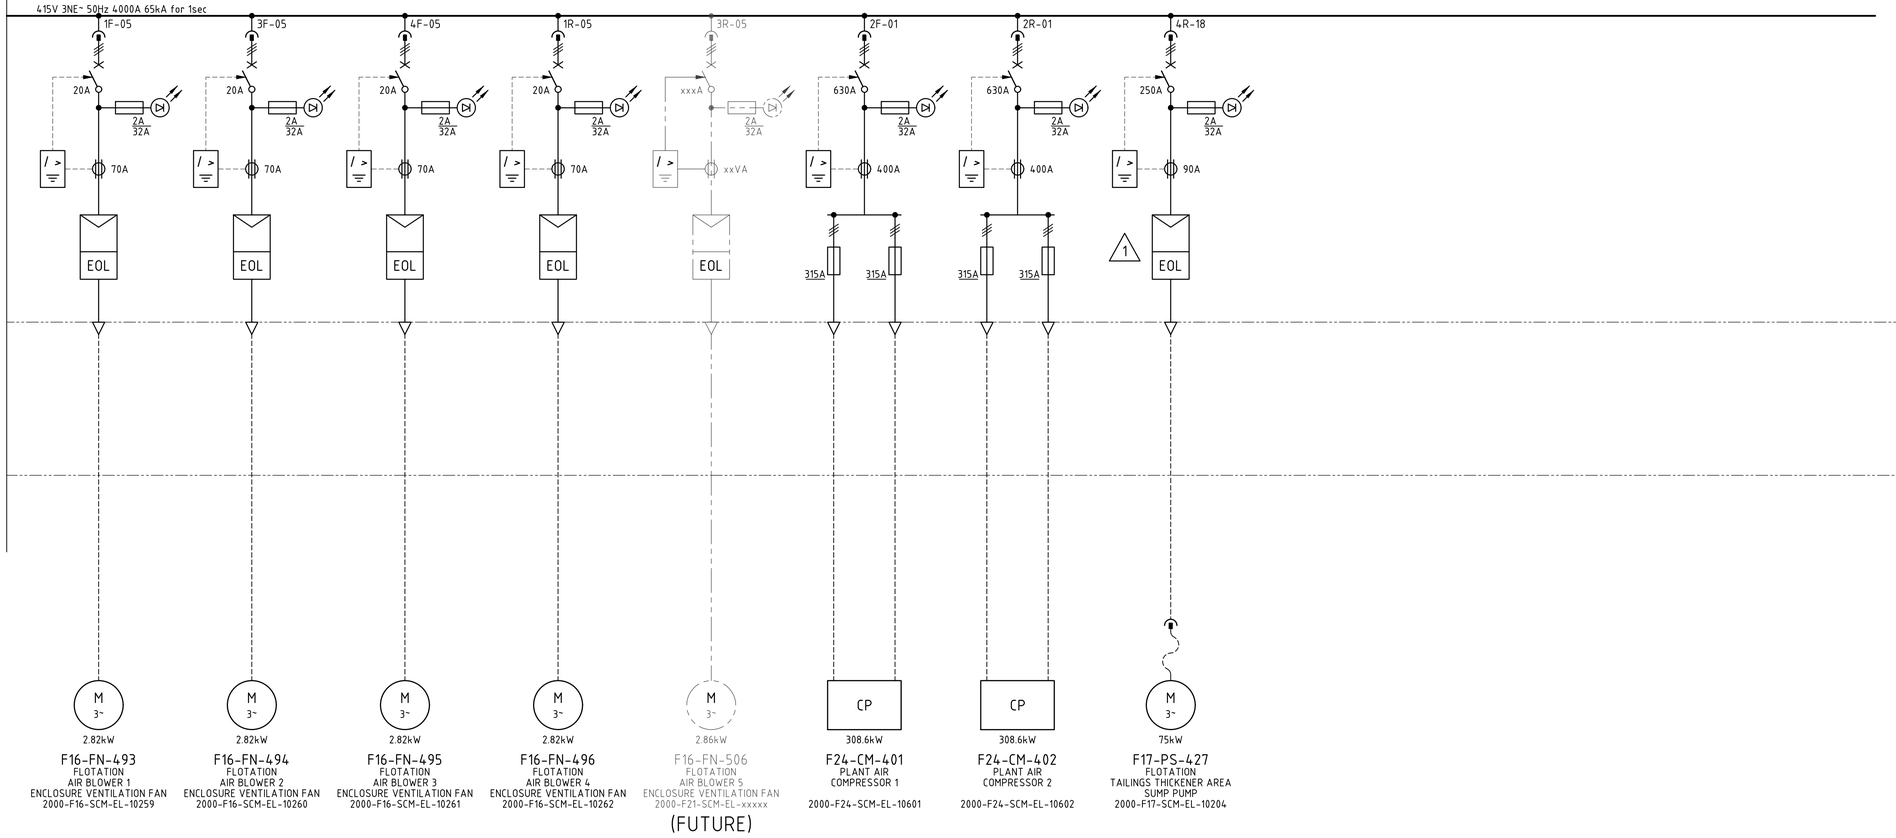

NOTES

1. REFER TO SHEET 1.

LEGEND

1. REFER TO SHEET 1.

DRG No.	REFERENCES	REV	DATE	DESCRIPTION	DRAW	CHECK	DESIGN	TECH APP	PROJ APP
2000-F16-SCM-EL-10223	F16-SW-005 415V MCC ARC FLASH SYSTEM SCHEMATIC DIAGRAM								
2000-F16-SCM-EL-10222	F16-SW-005 415V MCC 24VDC DISTRIBUTION SCHEMATIC DIAGRAM								
2000-F16-SCM-EL-10221	F16-SW-005 415V MCC INCOMER SCHEMATIC DIAGRAM								
2000-F16-DRG-EL-10101	F16-SR-002 415V SWITCHROOM ELECTRICAL EQUIPMENT LAYOUT								
2000-F16-BLK-IC-10001	F16-SR-002 415V SWITCHROOM AND REMOTE I/O COMMUNICATIONS BLOCK DIAGRAM								
2000-F16-SLD-EL-10211	F16-SW-005 415V MCC SINGLE LINE DIAGRAM SHEET 1	2	07SEP26	KCGM GROWTH PROJECT - SP1 AS-BUILT					
2000-F00-SLD-EL-10002	F00-SW-010 33kV SWITCHBOARD SINGLE LINE DIAGRAM SHEET 1 OF 5	1	26AUG25	FAT REDLINES INCORPORATED					
2000-F00-STD-EL-10001	GENERAL NOTES AND STANDARD DRAWINGS INDEX	0	11JUN24	APPROVED FOR CONSTRUCTION					

NORTHERN STAR RESOURCES LIMITED

PRIMERO
primero.com.au | DESIGN | CONSTRUCT | OPERATE

PRIMERO PROJECT NUMBER: 23517

INFORMATION AND REPRESENTATIONS ON THIS DRAWING ARE THE INTELLECTUAL PROPERTY OF PRIMERO UNLESS SPECIFICALLY IDENTIFIED OTHERWISE. ALL RIGHTS INCLUDING USE RESERVED

PROJECT: NORTHERN STAR RESOURCES LTD
KCGM GROWTH PROJECT

TITLE: ROUGHER AND SCAVENGER FLOTATION
F16-SW-005 415V MCC
SINGLE LINE DIAGRAM SHEET 2

SHEET	SCALE	DRG No.	REVISION
A1	NONE	2000-F16-SLD-EL-10212	2

O:\CAD PROJECTS\235 NORTHERN STAR RESOURCES LTD\23517 KCGM GROWTH PROJECT\03 DELIVERABLES\EL\F16 - ROUGHER & SCAVENGER FLOTATION\2000-F16-SLD-EL-10212.DWG 03SEP26 2:30PM ROBINLAW