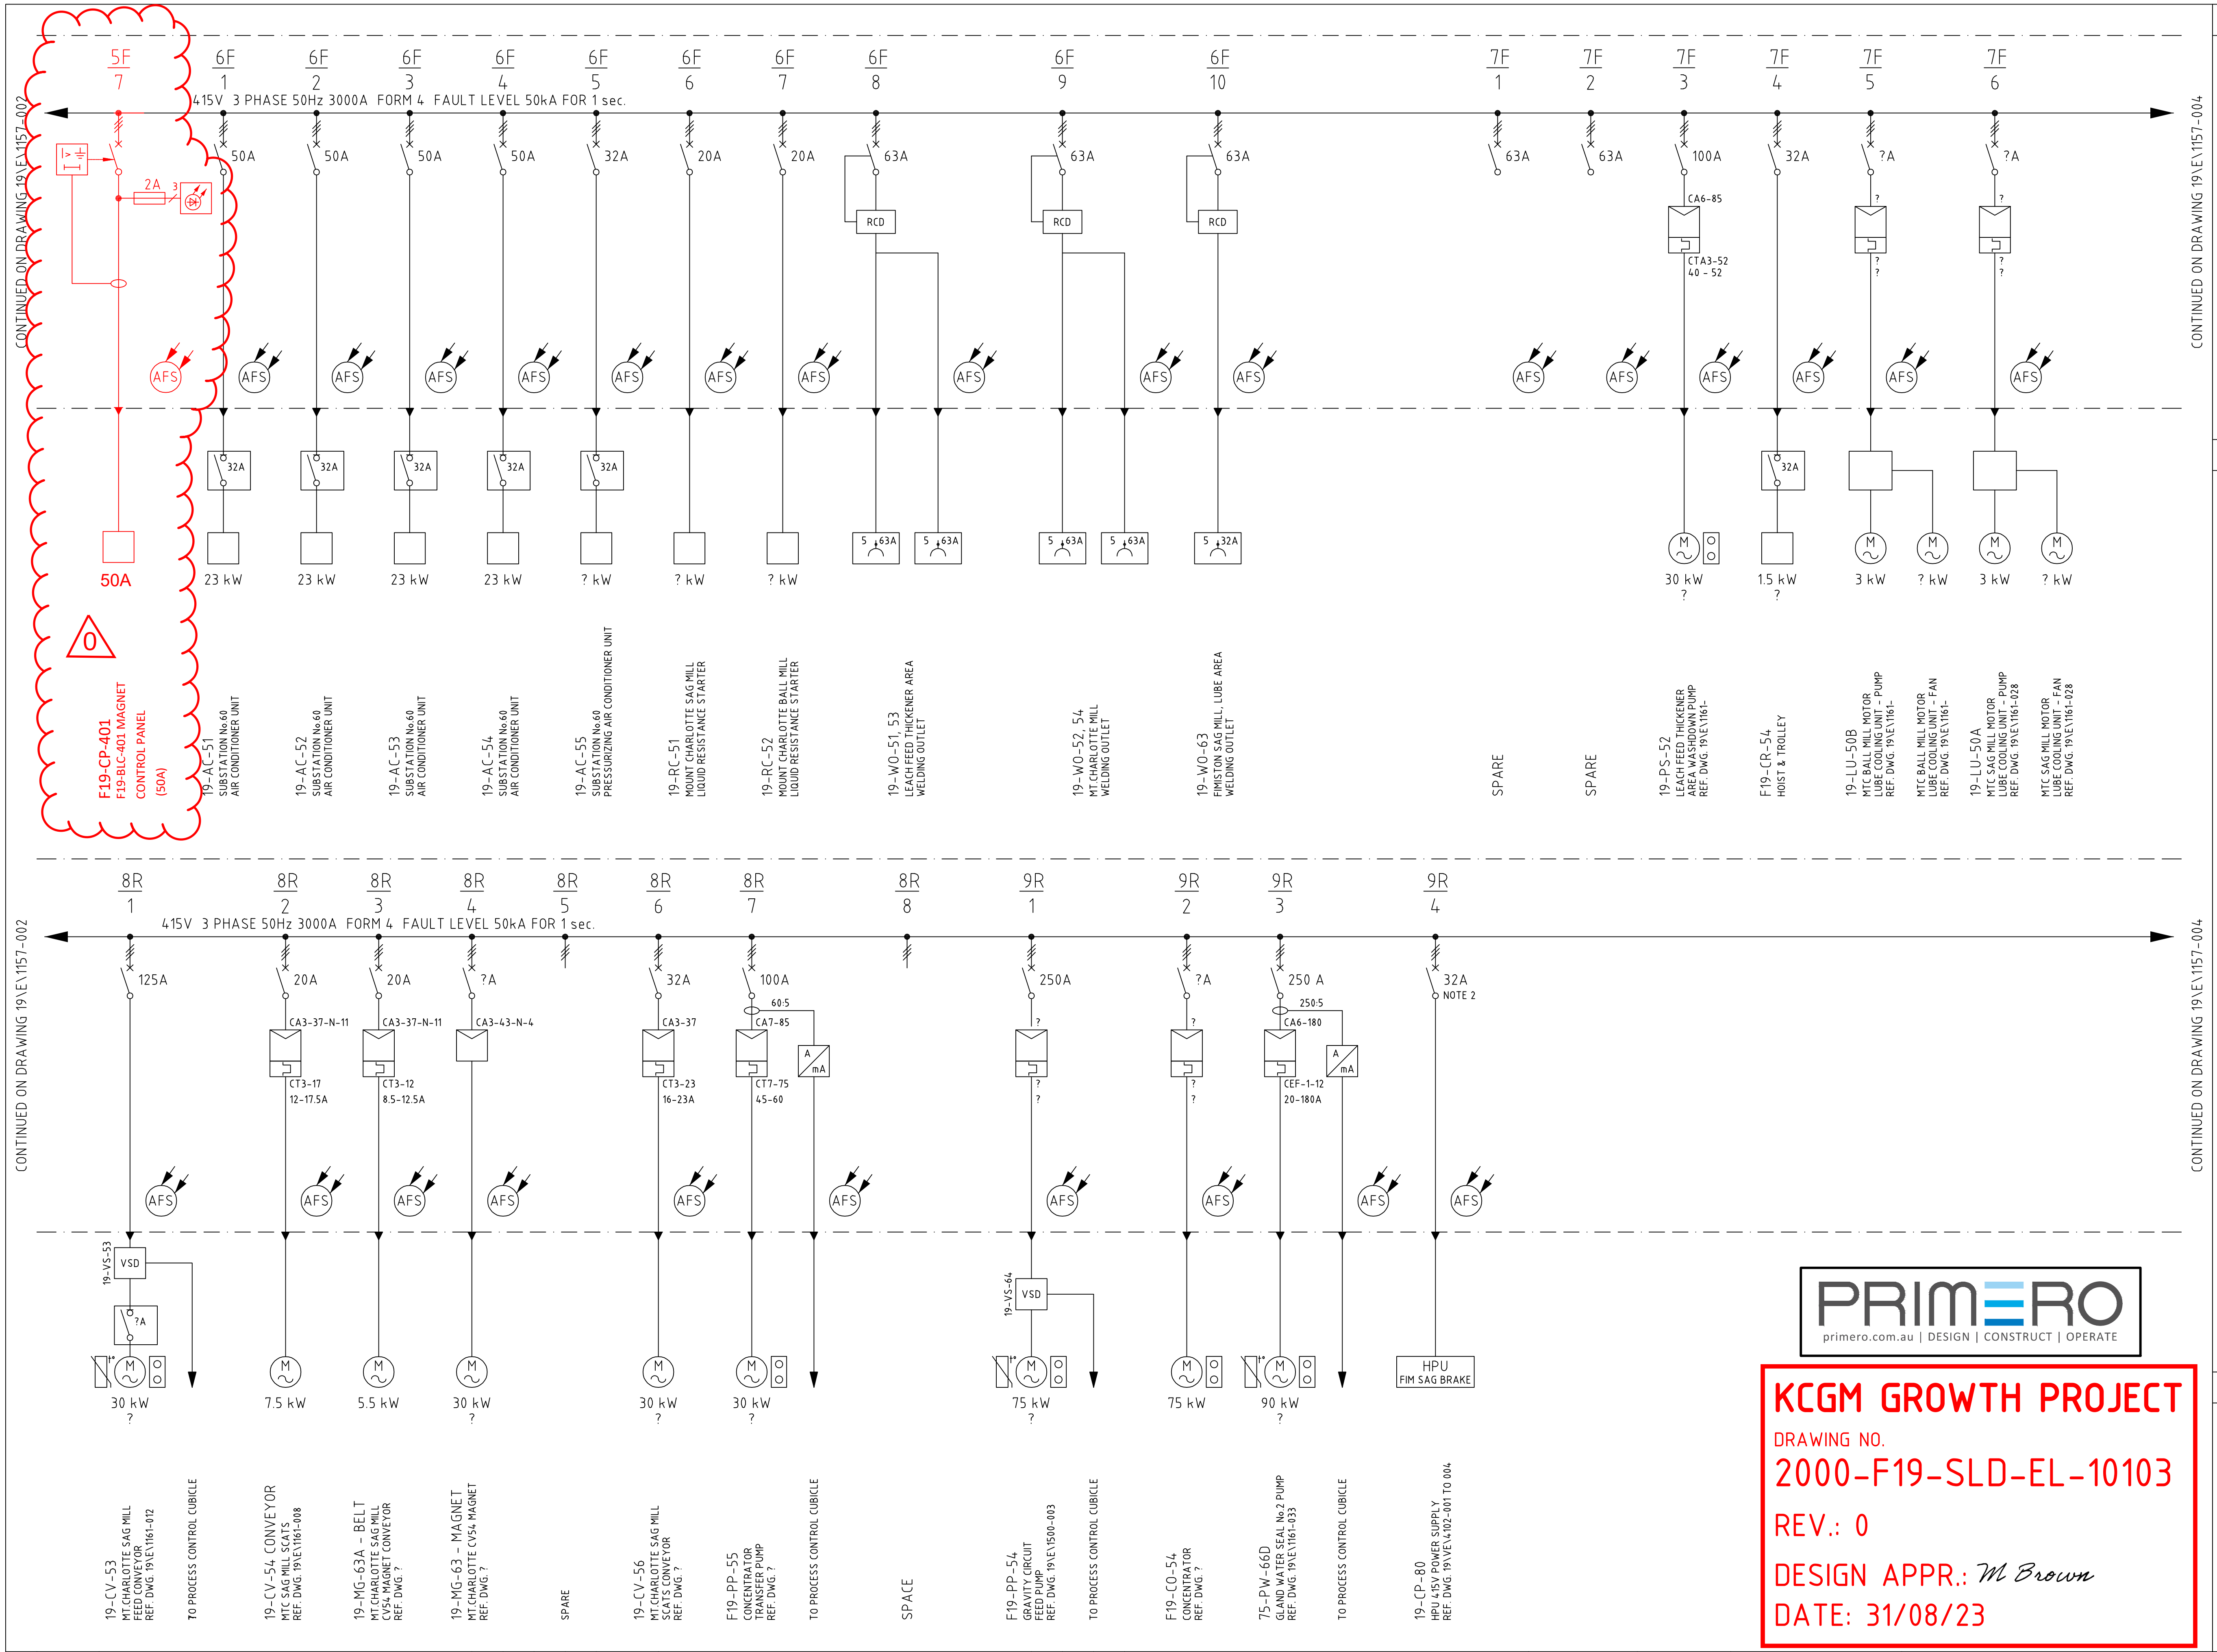
5F 7
6F 1
6F 2
6F 3
6F 4
6F 5
6F 6
6F 7
6F 8
6F 9
6F 10
7F 1
7F 2
7F 3
7F 4
7F 5
7F 6
415V 3 PHASE 50Hz 3000A FORM 4 FAULT LEVEL 50kA FOR 1 sec.
CONTINUED ON DRAWING 19\E\1157-002
CONTINUED ON DRAWING 19\E\1157-004
2A
50A
32A
20A
63A
100A
?A
RCD
CA6-85
CTA3-52
40 - 52
AFS
5 63A
5 32A
23 kW
? kW
30 kW
1.5 kW
3 kW
50A
0
F19-CP-401
F19-BLC-401 MAGNET
CONTROL PANEL
(50A)
19-AC-51 SUBSTATION No.60 AIR CONDITIONER UNIT
19-AC-52 SUBSTATION No.60 AIR CONDITIONER UNIT
19-AC-53 SUBSTATION No.60 AIR CONDITIONER UNIT
19-AC-54 SUBSTATION No.60 AIR CONDITIONER UNIT
19-AC-55 SUBSTATION No.60 PRESSURIZING AIR CONDITIONER UNIT
19-RC-51 MOUNT CHARLOTTE SAG MILL LIQUID RESISTANCE STARTER
19-RC-52 MOUNT CHARLOTTE BALL MILL LIQUID RESISTANCE STARTER
19-WO-51, 53 LEACH FEED THICKENER AREA WELDING OUTLET
19-WO-52, 54 MT.CHARLOTTE MILL WELDING OUTLET
19-WO-63 FIMISTON SAG MILL, LUBE AREA WELDING OUTLET
SPARE
SPARE
19-PS-52 LEACH FEED THICKENER AREA WASHDOWN PUMP REF. DWG. 19\E\1161-
F19-CR-54 HOIST & TROLLEY
19-LU-50B MTC BALL MILL MOTOR LUBE COOLING UNIT - PUMP REF. DWG. 19\E\1161-
MTC BALL MILL MOTOR LUBE COOLING UNIT - FAN REF. DWG. 19\E\1161-
19-LU-50A MTC SAG MILL MOTOR LUBE COOLING UNIT - PUMP REF. DWG. 19\E\1161-028
MTC SAG MILL MOTOR LUBE COOLING UNIT - FAN REF. DWG. 19\E\1161-028
8R 1
8R 2
8R 3
8R 4
8R 5
8R 6
8R 7
8R 8
9R 1
9R 2
9R 3
9R 4
415V 3 PHASE 50Hz 3000A FORM 4 FAULT LEVEL 50kA FOR 1 sec.
125A
20A
?A
32A
100A
250A
250 A
32A
NOTE 2
CA3-37-N-11
CA3-43-N-4
CA3-37
CA7-85
CA6-180
60:5
250:5
CT3-17
12-17.5A
CT3-12
8.5-12.5A
CT3-23
16-23A
CT7-75
45-60
CEF-1-12
20-180A
A
mA
19-VS-53
19-VS-64
VSD
HPU
FIM SAG BRAKE
30 kW
7.5 kW
5.5 kW
75 kW
90 kW
19-CV-53 MT.CHARLOTTE SAG MILL FEED CONVEYOR REF. DWG. 19\E\1161-012
TO PROCESS CONTROL CUBICLE
19-CV-54 CONVEYOR MTC SAG MILL SCATS REF. DWG. 19\E\1161-008
19-MG-63A - BELT MT.CHARLOTTE SAG MILL CV54 MAGNET CONVEYOR REF. DWG. ?
19-MG-63 - MAGNET MT.CHARLOTTE CV54 MAGNET REF. DWG. ?
SPARE
19-CV-56 MT.CHARLOTTE SAG MILL SCATS CONVEYOR REF. DWG. ?
F19-PP-55 CONCENTRATOR TRANSFER PUMP REF. DWG. ?
TO PROCESS CONTROL CUBICLE
SPACE
F19-PP-54 GRAVITY CIRCUIT FEED PUMP REF. DWG. 19\E\1500-003
TO PROCESS CONTROL CUBICLE
F19-CO-54 CONCENTRATOR REF. DWG. ?
75-PW-66D GLAND WATER SEAL No.2 PUMP REF. DWG. 19\E\1161-033
TO PROCESS CONTROL CUBICLE
19-CP-80 HPU 415V POWER SUPPLY REF. DWG. 19\VE\4102-001 TO 004

LEGEND

LOCATION

SUB STATION 60

19-SW-61

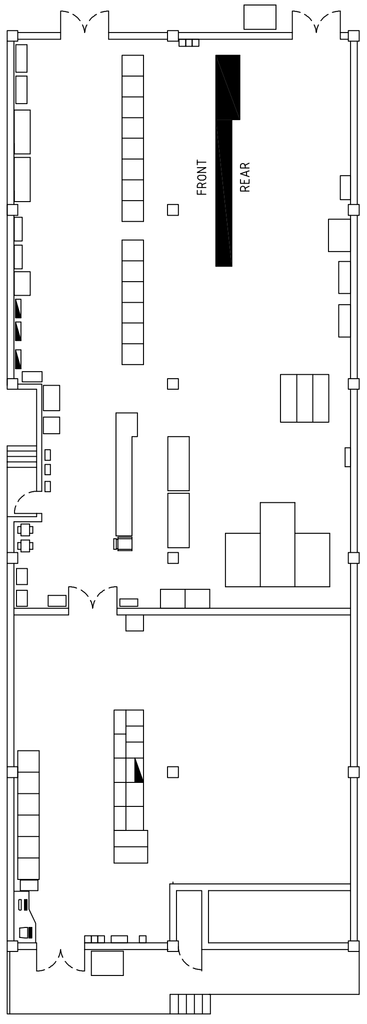

NOTES

1. EARTH LEAKAGE CIRCUIT BREAKER SHALL HAVE 300mA SENSITVITY FOR WELDING OUTLET.
2. EARTH CONTINUITY RELAY, SCIENTECHNIC TYPE PCA. WIRED BACK TO THE ARC FLASH RELAY
3. ALL AFS (ARC FLASH SENSORS) ARE CONNECTED TO THE ARC FLASH RELAY VIA I/O UNITS

PRIMERO
primero.com.au | DESIGN | CONSTRUCT | OPERATE

KCGM GROWTH PROJECT
DRAWING NO.
2000-F19-SLD-EL-10103
REV.: 0
DESIGN APPR.: M Brown
DATE: 31/08/23

MK	DATE	REVISION	BY	CKD	APP	MK	DATE	REVISION	BY	CKD	APP
12	12/08/14	19HU51 TIER 7F/6 REMOVED	RH	ETS	PH	16A	11/03/19	2019 S.L.D. UPDATE PROJECT 'AS BUILT' - FIELD REVIEW	RH	RH	EB
11	12/12/13	WELDING OUTLET INSTALLED	RH		PH	15	08/11/17	ARC FLASH SENSORS INSTALLED	RH	JMR	JMR
10	29/03/12	MTC SAG & BALL HUMIDIFIER AS BUILT MARCH 2012	RH	CJ	CJ	14	11/11/16	BRAKE INSTALLED AS BUILT	RH	CJ	
9	23/02/11	19-HU-51 MTC SAG & BALL SLIP RINGS HUMIDIFIER ADDED	RH	JC	JC	13C	02/02/16	MOVED 19CP80 FROM TIER 8R-5 TO 9R-4, ISSUED FOR ENGINEERING REVIEW	RH	CJ	AD
8	22/07/08	75-PW-66A MADE REDUNDANT & ADDED 75-PW-66D	TW	MS	MS	13B	21/01/16	MOVED 19CP80 FROM TIER 9R-4 TO 8R-5, ISSUED FOR ENGINEERING REVIEW	RH	CJ	AD
17	25/03/22	SUBSTATION LAYOUT UPDATED	RH	RH	RH	13A	22/12/15	TIER 9R-4 FIM SAG BRAKE PROJECT, ISSUED FOR ENGINEERING REVIEW	RH	AR	AR

REFERENCE DRAWINGS	DWG NO.
SUBSTATION No.60 DCS CUBICLE 19-PC-51 MARSHALLING TERMINATIONS	19\E\1167
SUBSTATION No.60 MCC 19-SW-61 CABLE ZONE TERMINATIONS	19\E\1163
SUBSTATION No.60 POWER SCHEMATICS	19\E\1160
SUBSTATION No.60 MCC 19-SW-61 DRIVE PANEL LAYOUT	19\E\1152
SUBSTATION No.60 MCC AND GENERAL EQUIPMENT LAYOUT	19\E\1050

SCALE	NTS	
DRAWN	G.SOFIELD	10/10/97
DESIGNED	G.SOFIELD	10/10/97
CHECKED	G.SOFIELD	10/10/97
APPROVED	A.BRADY	10/10/97
PROJ.APP	A.BRADY	10/10/97
PROJ. FILE #.		

FIMISTON PLANT
MT. CHARLOTTE CCT, MILLING AND CLASSIFICATION
SUBSTATION No.60 415V MCC 19-SW-61
SINGLE LINE DIAGRAM SHEET 3

SIZE	DRAWING NUMBER	REV
A1	19\E\1157-003	17

KALGOORLIE CONSOLIDATED GOLD MINES PTY. LTD. ABN 009 377 619 003