
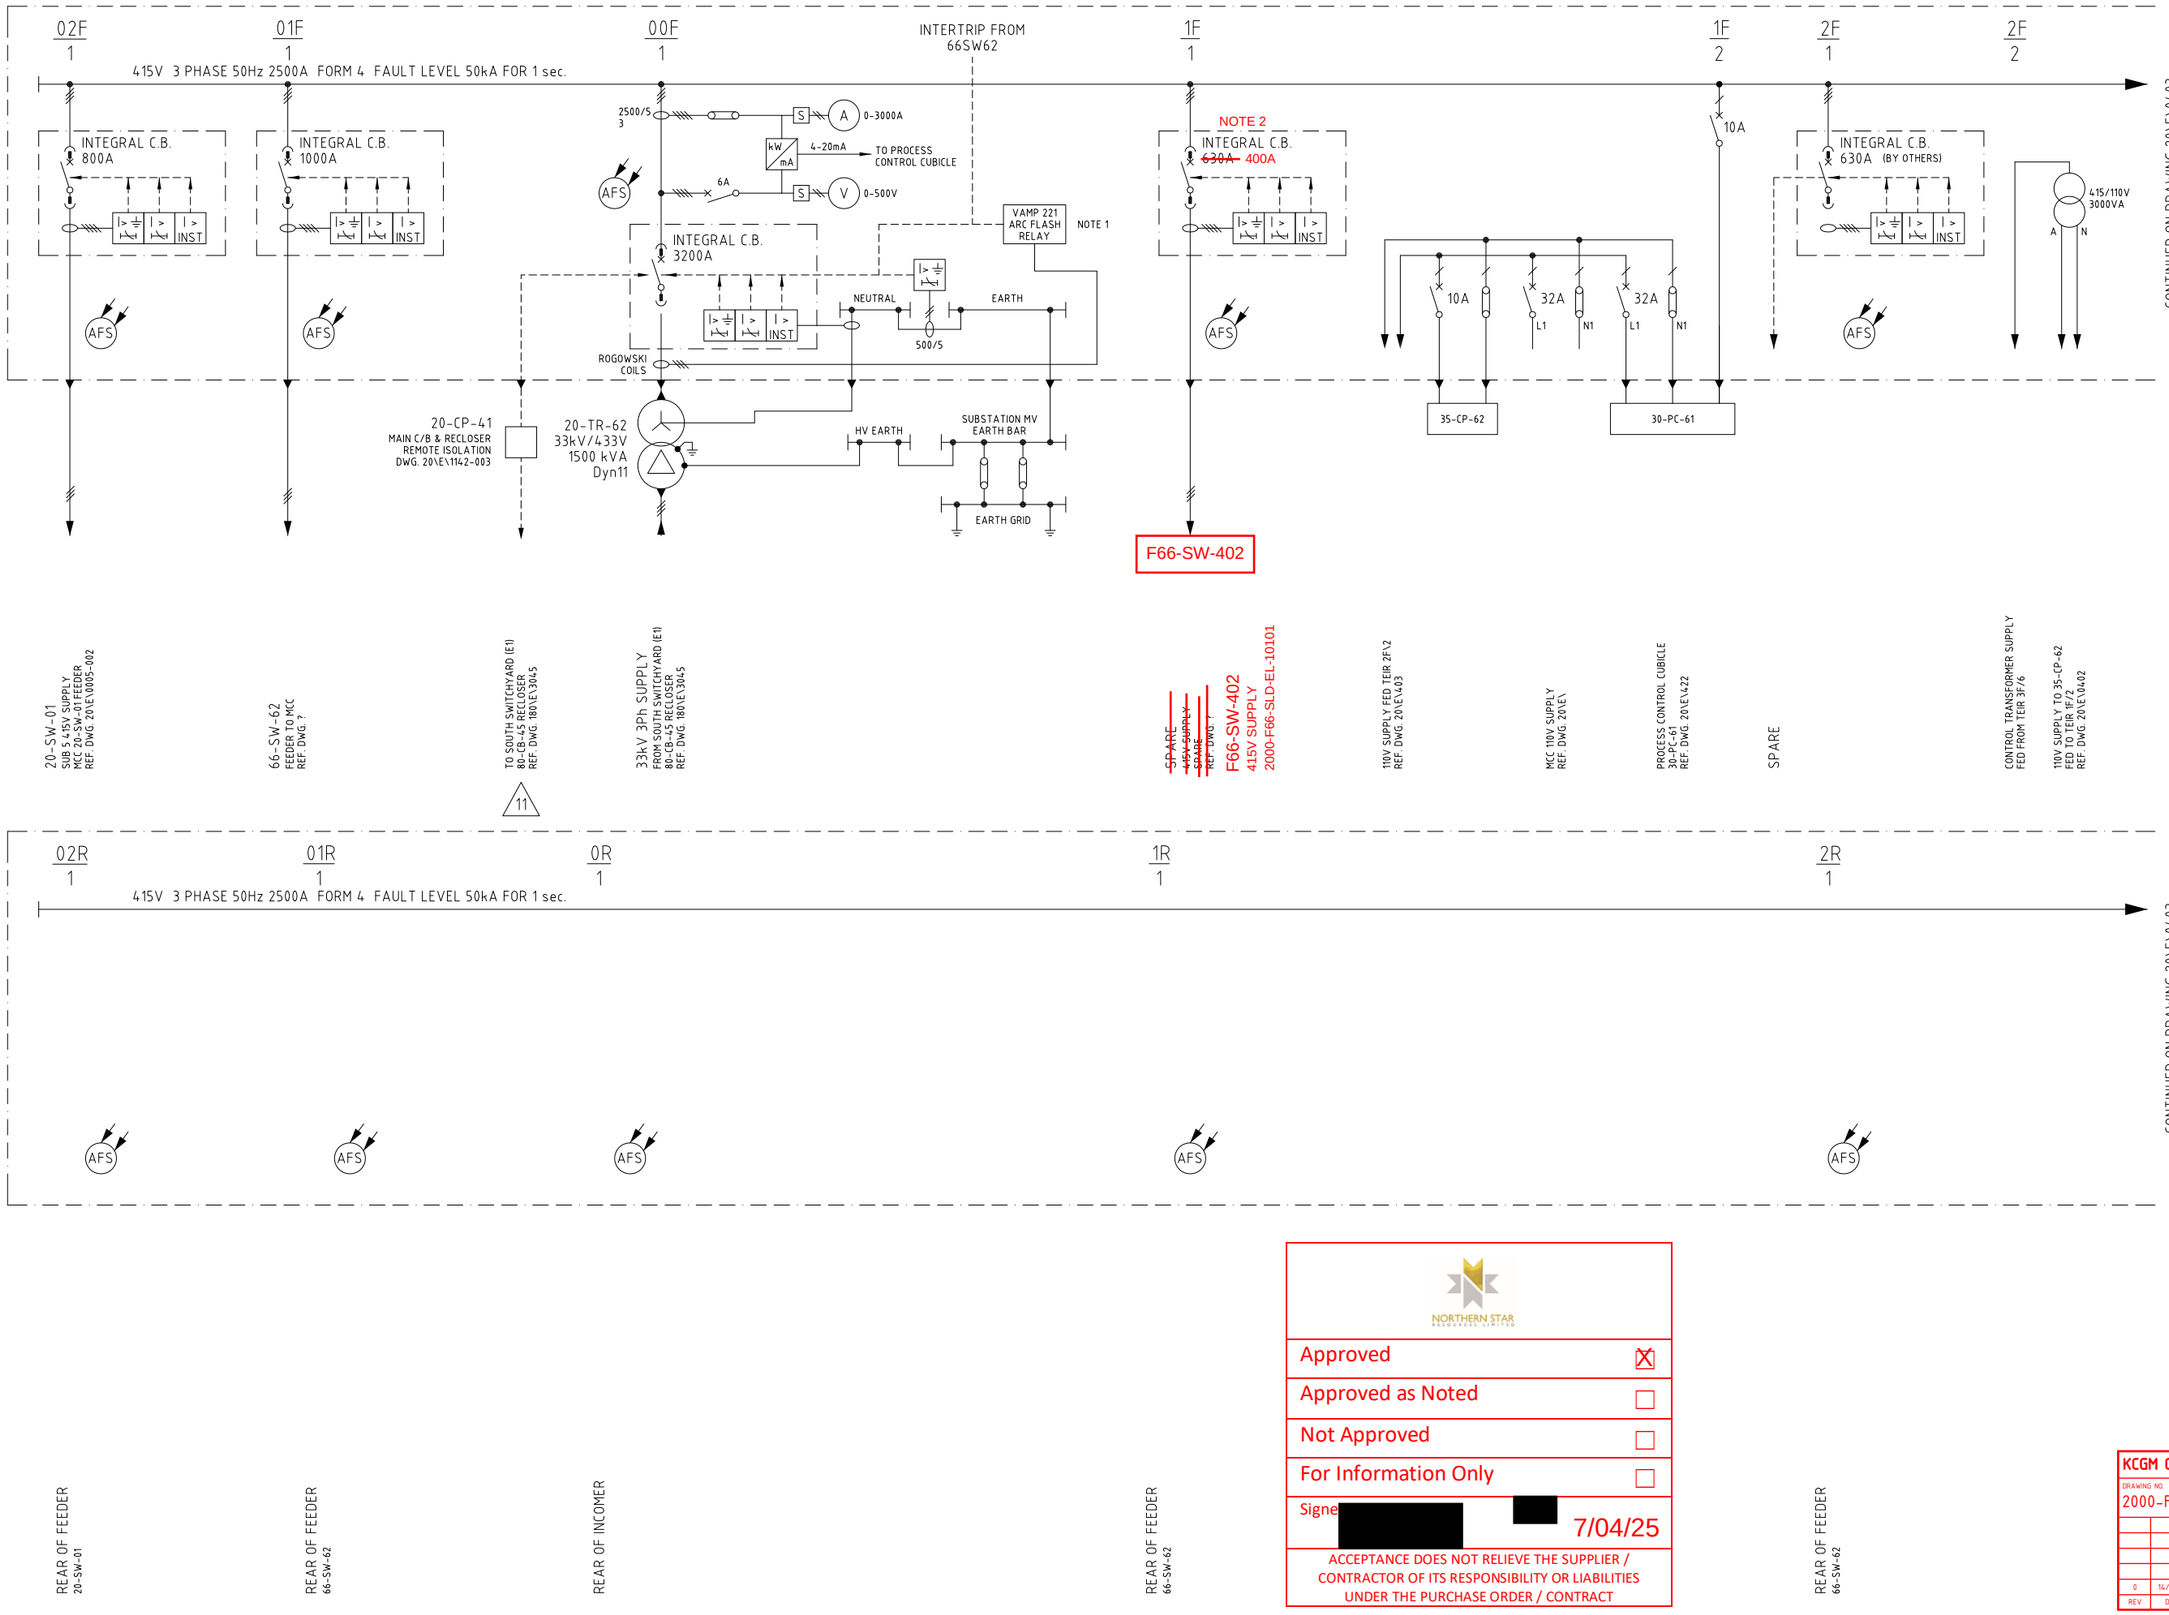


LEGEND

LOCATION

SUB STATION 35

20-SW-62

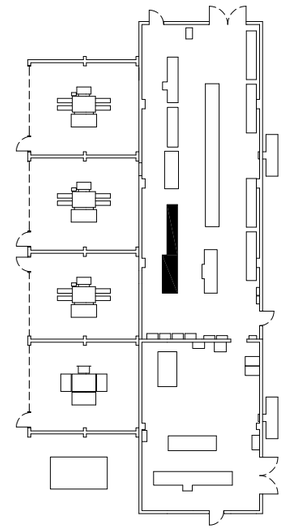

NOTES

1. ALL AFS (ARC FLASH SENSORS) ARE CONNECTED TO THE ARC FLASH RELAY VIA I/O UNITS
2. TIER 1F SPARE FEEDER RE-PURPOSED FOR KCGM GROWTH PROJECT. MCCB TRIP UNIT TO BE SET AT 400A.

NORTHERN STAR RESOURCES LIMITED

Approved	X
Approved as Noted	
Not Approved	
For Information Only	

Signe [redacted] 7/04/25

ACCEPTANCE DOES NOT RELIEVE THE SUPPLIER / CONTRACTOR OF ITS RESPONSIBILITY OR LIABILITIES UNDER THE PURCHASE ORDER / CONTRACT

LEGEND

- STAGE 1 - NEW
- STAGE 1 - REMOVE
- STAGE 1 - DECOMMISSIONED (OTHERS)
- STAGE 2 - NEW
- STAGE 2 - REMOVE
- STAGE 2 - DECOMMISSIONED (OTHERS)

KCGM GROWTH PROJECT

DRAWING NO. 2000-F20-SLD-EL-10102

REV	DATE	DESCRIPTION	CHECK	TECH APP
0	14/03/25	APPROVED FOR CONSTRUCTION	[redacted]	MB/DM

MK	DATE	REVISION	BY	CKD	APP
10	16/08/19	2019 S.L.D. UPDATE PROJECT "AS BUILT"	BH	RH	EB
9	19/06/19	2019 S.L.D UPDATE PROJECT " AS BUILT "	[redacted]	RH	[redacted]
8	13/11/17	ARC FLASH SENSOR INSTALLED		JMR	
7	08/10/15	GOLD ROOM RETORT INSTALLATION		JM	
6	21/07/14	APPROVED FOR CONSTRUCTION		HY	MD/JM
5A	17/06/14	TIER 2F-1 REVISED TO FEED 66-SW-62 INCOMER		SE	WJ/JM

MK	DATE	REVISION	BY	CKD	APP
5	10/12/98	AS BUILT & REDRAWN TO KCGM STANDARDS	CV		
4	4/95	20-SW-01, 66-SW-61 CB SWAP	[redacted]		
3	11/94	AS BUILT - PERTH		JAM	[redacted]
2	9/94	REVISED AS NOTED		JAM	[redacted]
11	26/10/21	RECLOSER PROJECT AS BUILT		RH	MM
0	7/94	APPROVED FOR TENDER		JAM	

REFERENCE DRAWINGS

DWG NO.

SCALE	NTS	
DRAWN	[redacted]	1994
DESIGNED		1994
CHECKED		1994
APPROVED	MRD/JM	03/07/14
PROJ.APP	MINPROC	1994
PROJ. FILE #.		

FIMISTON PLANT
FIMISTON RECYCLE CRUSHING
SUBSTATION No.35 415V MCC 20-SW-62
SINGLE LINE DIAGRAM SHEET 1

	DRAWING NUMBER	REV
A1	20\E\0402	11

KALGOORLIE CONSOLIDATED GOLD MINES PTY. LTD. ABN 009 377 619 003