
F22-SR-001
415V CARBON TREATMENT & ELUTION SWITCHROOM

F22-SW-030
CARBON TREATMENT & ELUTION 415V MOTOR CONTROL CENTRE No.1

CONTINUED ON SHT 1
2000-F22-SLD-EL-10201

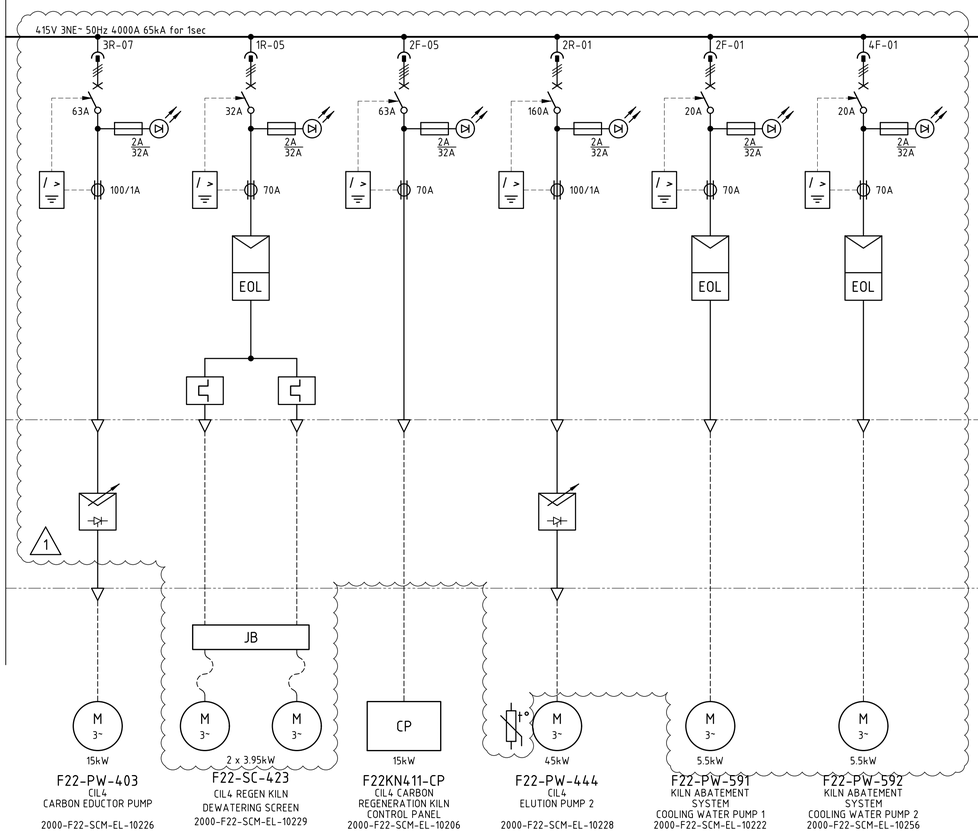

NOTES

1. REFER TO SHEET 1.

LEGEND

1. REFER TO SHEET 1.

Approved	X
Approved as Noted	
Not Approved	
For Information Only	

Signed [redacted] Date 06/01/2026

ACCEPTANCE DOES NOT RELIEVE THE SUPPLIER / CONTRACTOR OF ITS RESPONSIBILITY OR LIABILITIES UNDER THE PURCHASE ORDER / CONTRACT

DRG No.	REFERENCES	REV	DATE	DESCRIPTION	DRAW	CHECK	DESIGN	TECH APP	PROJ APP
2000-F22-SCM-EL-10204	F22-SW-030 415V MCC ARC FLASH SYSTEM SCHEMATIC DIAGRAM								
2000-F22-SCM-EL-10203	F22-SW-030 415V MCC 24VDC DISTRIBUTION SCHEMATIC DIAGRAM								
2000-F22-SCM-EL-10201	F22-SW-030 415V MCC INCOMER SCHEMATIC DIAGRAM								
2000-F22-DRG-EL-10101	F22-SR-001 415V SWITCHROOM ELECTRICAL EQUIPMENT LAYOUT								
2000-F22-BLK-IC-10001	F22-SR-001 415V SWITCHROOM AND REMOTE I/O COMMUNICATIONS BLOCK DIAGRAM								
2000-F22-SLD-EL-10201	F22-SW-030 415V MCC SINGLE LINE DIAGRAM SHEET 1								
2000-F00-SLD-EL-10002	F00-SW-010 33kV SWITCHBOARD SINGLE LINE DIAGRAM SHEET 1 OF 5	1	24NOV25	FAT REDLINES INCORPORATED					
2000-F00-STD-EL-10001	GENERAL NOTES AND STANDARD DRAWINGS INDEX	0	05NOV24	APPROVED FOR CONSTRUCTION					

NORTHERN STAR RESOURCES LIMITED

INFORMATION AND REPRESENTATIONS ON THIS DRAWING ARE THE INTELLECTUAL PROPERTY OF PRIMERO UNLESS SPECIFICALLY IDENTIFIED OTHERWISE. ALL RIGHTS INCLUDING USE RESERVED

PRIMERO
primero.com.au | DESIGN | CONSTRUCT | OPERATE

PRIMERO PROJECT NUMBER: 23517

PROJECT: NORTHERN STAR RESOURCES LTD
KCGM GROWTH PROJECT

TITLE: CIL4 CARBON TREATMENT & ELUTION
F22-SW-030 415V MCC
SINGLE LINE DIAGRAM SHEET 2

SHEET	SCALE	DRG No.	REVISION
A1	NONE	2000-F22-SLD-EL-10202	1

O:\CAD PROJECTS\235 NORTHERN STAR RESOURCES LTD\23517 KCGM GROWTH PROJECT\03 DELIVERABLES\ELV\F22 - CIL4 CARBON TREAMENT & ELUTION\2000-F22-SLD-EL-10202.DWG 18DEC25 12:14PM HOTSEAT04