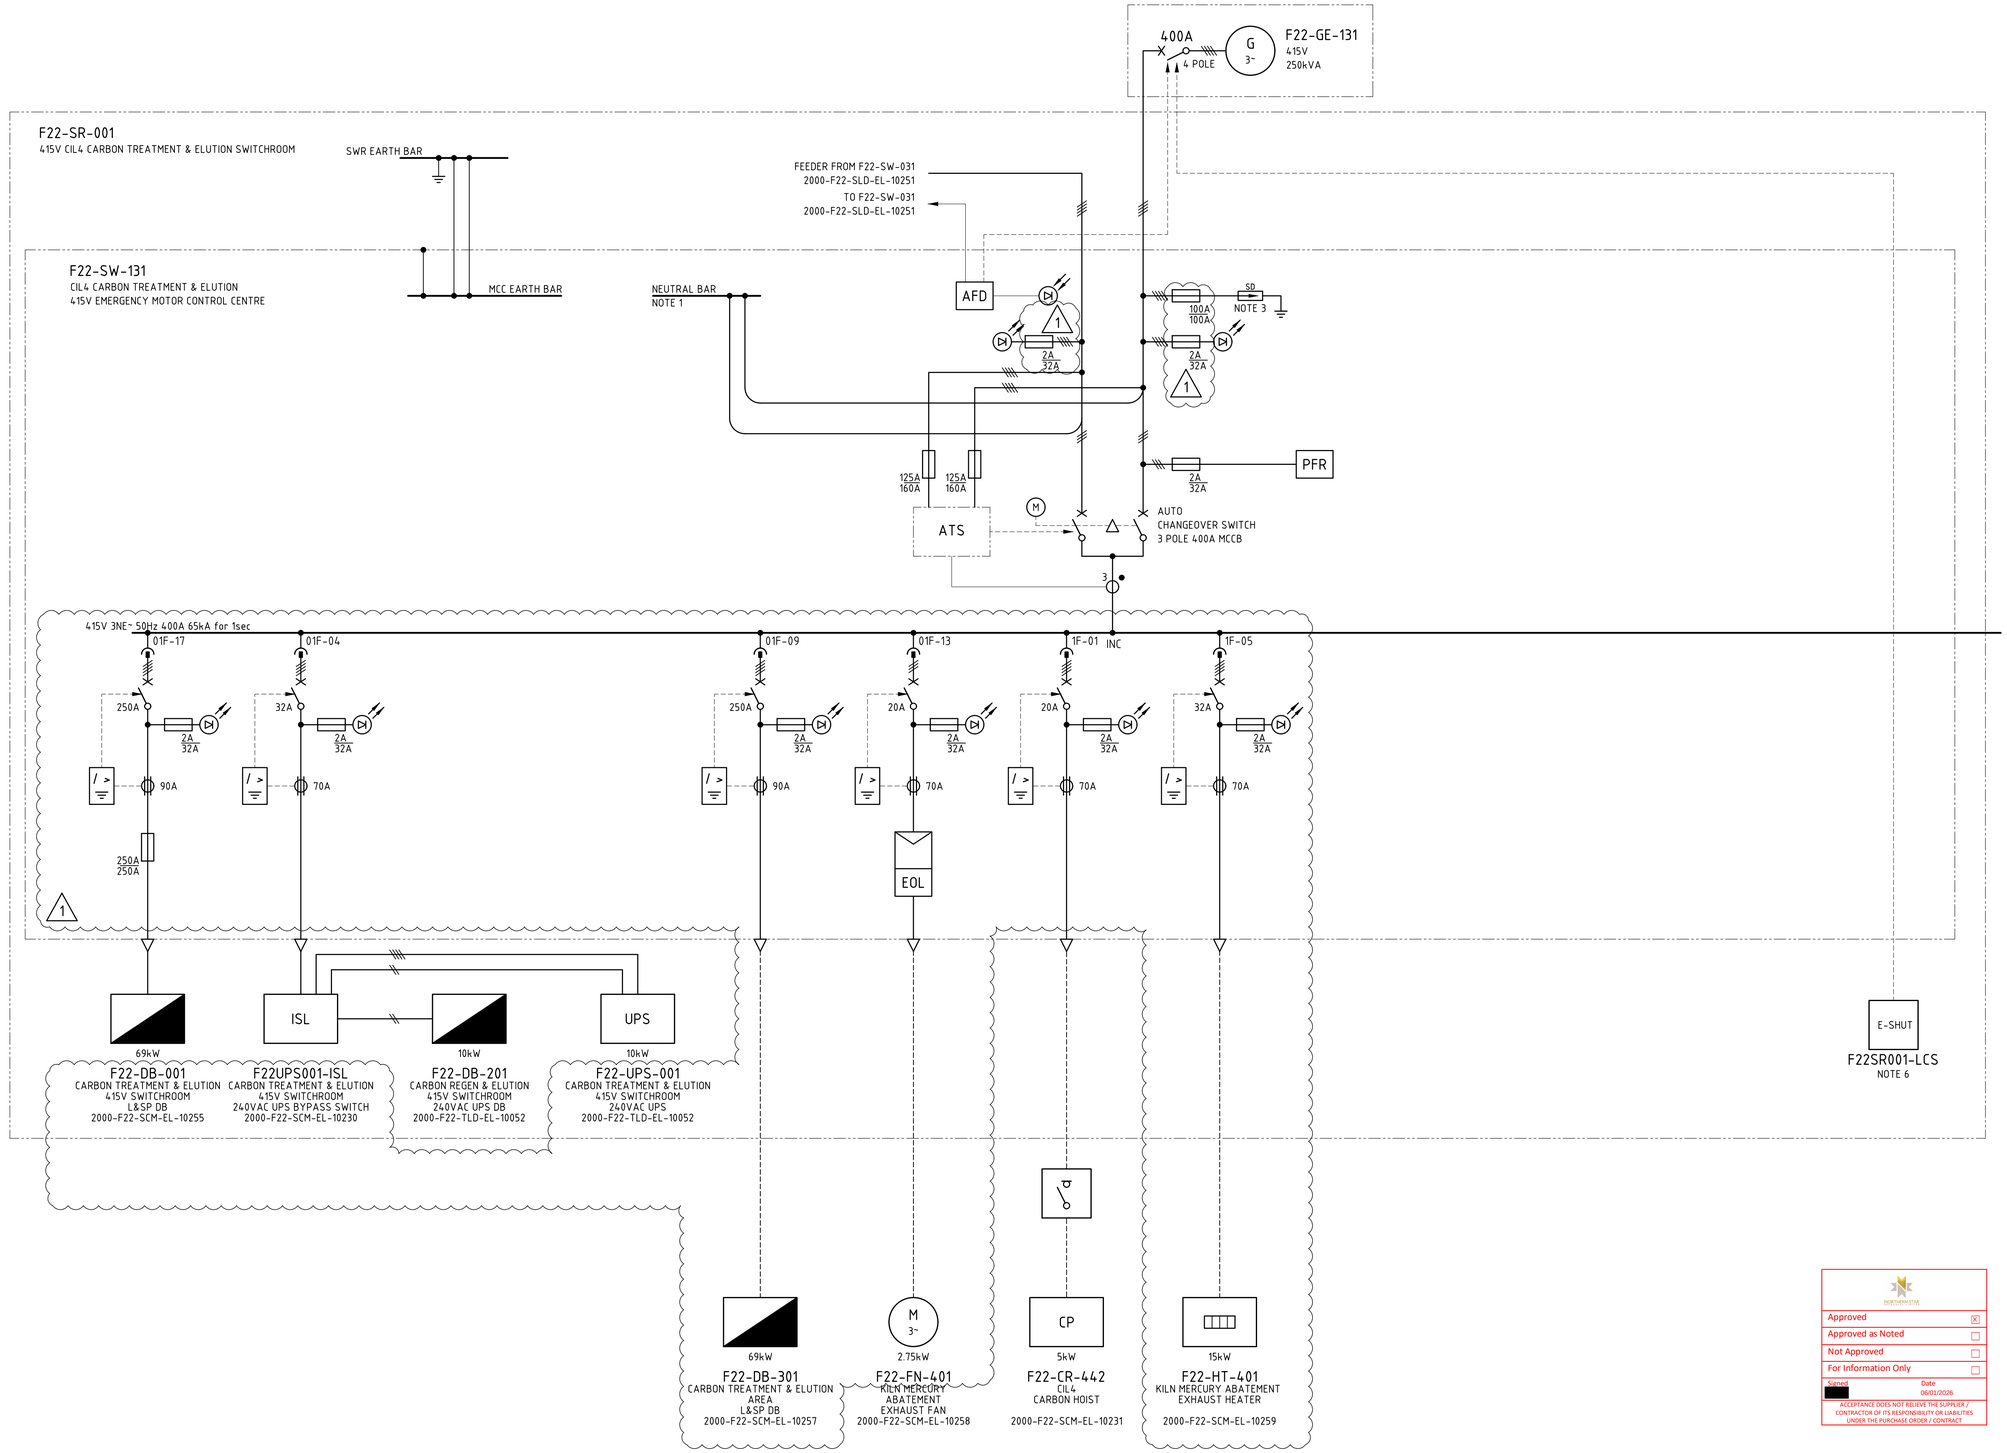


NOTES

1. EARTH-NEUTRAL LINK INSTALLED IN UPSTREAM F22-SW-030 INCOMER TIER. SIGNAGE SHALL BE PLACED ON F22-SW-131 SWITCHBOARD AND ON GENERATOR READING "M.E.N. LINK LOCATED IN F22-SW-030 INCOMER TIER"
2. SWITCHBOARD SHALL BE EXTENSIBLE AND BE PROVIDED WITH THE FACILITY TO EXTEND THE MAIN BUSBAR AND APPEND ADDITIONAL TIERS AT ONE END WITHOUT MAJOR STRUCTURAL DISASSEMBLY.
3. SURGE DIVERTERS SHALL PROVIDE FEEDBACK TO DCS VIA VOLT-FREE CONTACTS. SURGE DIVERTER FUSES SHALL BE SIZED BY VENDOR TO SUIT DUTY.
4. MINIATURE CIRCUIT BREAKERS SHALL BE SIZED AND RATED TO SUIT ACB AND INCOMER REQUIREMENTS.
5. CIRCUIT BREAKER TO BE SUBSTITUTED FOR FUSED-SWITCH WHERE REQUIRED BY EQUIPMENT MANUFACTURERS GUIDELINES.
6. EMERGENCY SHUTDOWN (E-SHUT) PUSH BUTTON WIRED TO SHUNT TRIP NOMINATED CIRCUIT BREAKERS.
7. SWITCHBOARD VENDOR SHALL SELECT SWITCHGEAR TO PROVIDE TYPE-2 CO-ORDINATION SUITABLE FOR HIGH EFFICIENCY MOTORS.
8. ALL DRIVE I/O VIA COMMS NETWORK TO DCS. FOR COMMUNICATIONS BLOCK DIAGRAM REFER 2000-F22-BLK-IC-10001.

LEGEND

PFR	PHASE FAILURE RELAY
/ >	EARTH LEAKAGE RELAY
xxxA / xxxA	ST TRIP SET POINT / CB SIZE
AFD	ARC FLASH DETECTION
ECR	EARTH CONTINUITY RELAY
E-SHUT	SWITCHROOM EMERGENCY SHUTDOWN
	DIRECT ON-LINE MOTOR STARTER GENERIC - NOTE 7,8
EOL	ELECTRONIC OVERLOAD UNIT NOTE 7,8

Approved	☒
Approved as Noted	☐
Not Approved	☐
For Information Only	☐

Signed [redacted] Date 06/01/2026

ACCEPTANCE DOES NOT RELIEVE THE SUPPLIER / CONTRACTOR OF ITS RESPONSIBILITY OR LIABILITIES UNDER THE PURCHASE ORDER / CONTRACT

DRG No.	REFERENCES	REV	DATE	DESCRIPTION	DRAW	CHECK	DESIGN	TECH APP	PROJ APP
2000-F22-SCM-EL-10254	F22-SW-031 415V MCC ARC FLASH SYSTEM SCHEMATIC DIAGRAM								
2000-F22-SCM-EL-10253	F22-SW-031 415V MCC 24VDC DISTRIBUTION SCHEMATIC DIAGRAM								
2000-F22-SCM-EL-10272	F22-SW-131 415V EMERGENCY MCC INCOMER SCHEMATIC DIAGRAM								
2000-F22-DRG-EL-10101	F22-SR-001 415V SWITCHROOM ELECTRICAL EQUIPMENT LAYOUT								
2000-F22-BLK-IC-10001	F22-SR-001 415V SWITCHROOM AND REMOTE I/O COMMUNICATIONS BLOCK DIAGRAM								
2000-F22-SLD-EL-10251	F22-SW-031 415V MCC SINGLE LINE DIAGRAM SHEET 1	1	24NOV25	FAT REDLINES INCORPORATED					
2000-F00-STD-EL-10001	GENERAL NOTES AND STANDARD DRAWINGS INDEX	0	05NOV24	APPROVED FOR CONSTRUCTION					

NORTHERN STAR RESOURCES LIMITED

PRIMERO
primero.com.au | DESIGN | CONSTRUCT | OPERATE

PRIMERO PROJECT NUMBER: 23517

INFORMATION AND REPRESENTATIONS ON THIS DRAWING ARE THE INTELLECTUAL PROPERTY OF PRIMERO UNLESS SPECIFICALLY IDENTIFIED OTHERWISE. ALL RIGHTS INCLUDING USE RESERVED

PROJECT: NORTHERN STAR RESOURCES LTD
KCGM GROWTH PROJECT

TITLE: CIL4 CARBON TREATMENT & ELUTION
F22-SW-131 415V EMERGENCY MCC
SINGLE LINE DIAGRAM

SHEET	SCALE	DRG No.	REVISION
A1	NONE	2000-F22-SLD-EL-10261	1

O:\CAD PROJECTS\235 NORTHERN STAR RESOURCES LTD\23517 KCGM GROWTH PROJECT\03 DELIVERABLES\ELE\F22 - CIL4 CARBON TREAMENT & ELUTION\2000-F22-SLD-EL-10261.DWG 18DEC25 12:14PM HOTSEAT04