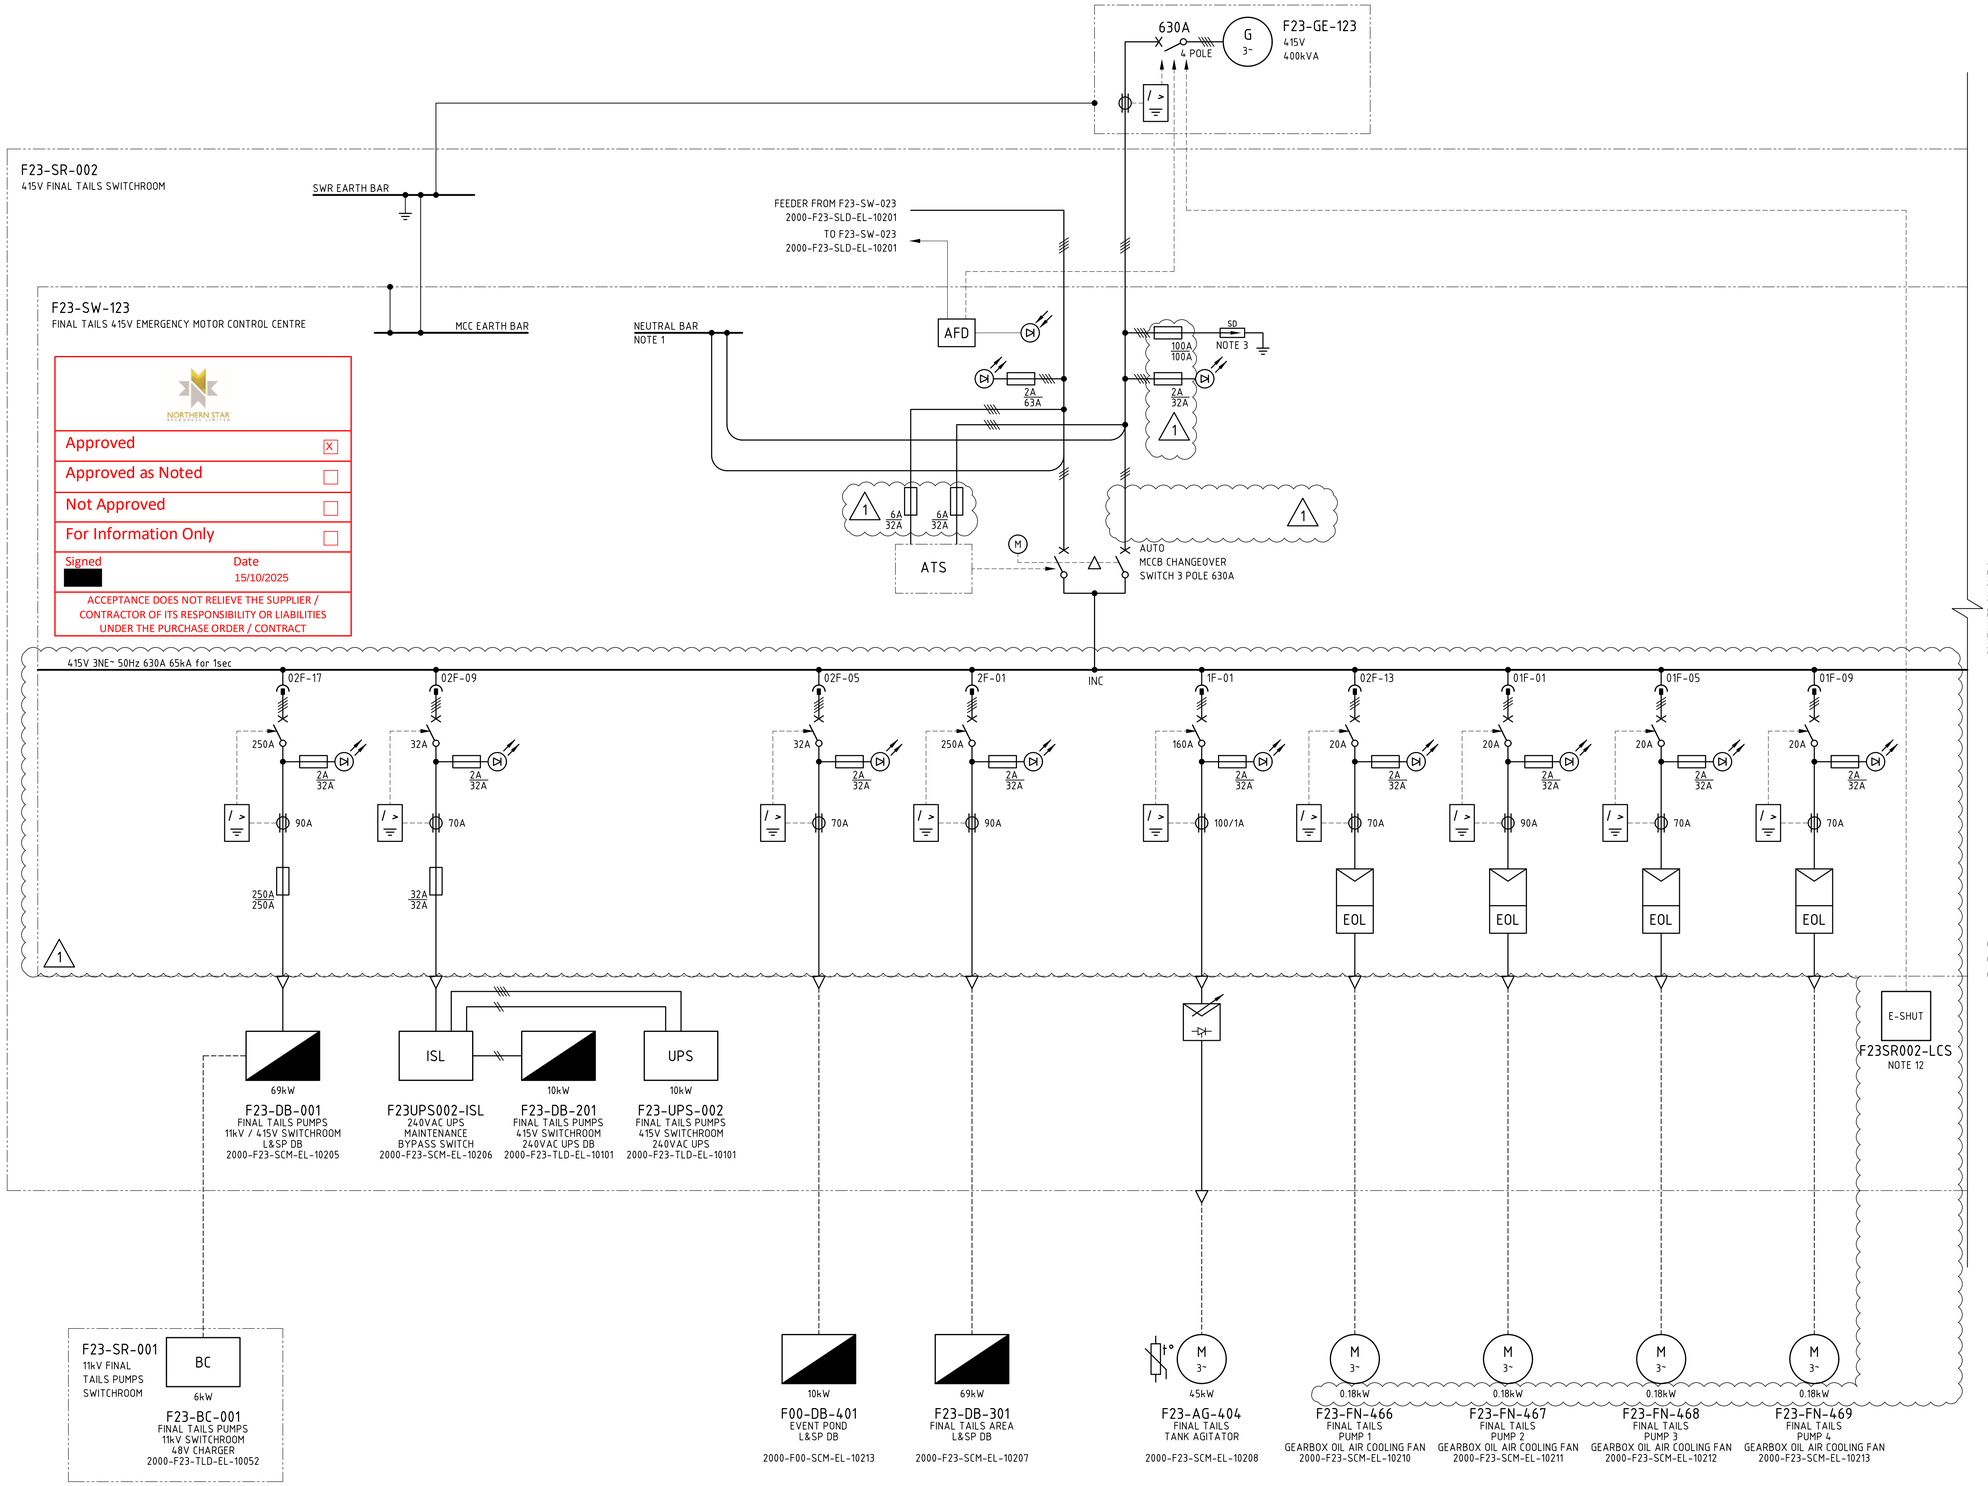


Approved	X
Approved as Noted	
Not Approved	
For Information Only	
Signed	Date 15/10/2025

ACCEPTANCE DOES NOT RELIEVE THE SUPPLIER / CONTRACTOR OF ITS RESPONSIBILITY OR LIABILITIES UNDER THE PURCHASE ORDER / CONTRACT

NOTES

1. EARTH-NEUTRAL LINK INSTALLED IN UPSTREAM F23-SW-023 INCOMER TIER. SIGNAGE SHALL BE PLACED ON F23-SW-123 SWITCHBOARD AND ON GENERATOR READING "M.E.N. LINK LOCATED IN F23-SW-023 INCOMER TIER"
2. SWITCHBOARD SHALL BE EXTENSIBLE AND BE PROVIDED WITH THE FACILITY TO EXTEND THE MAIN BUSBAR AND APPEND ADDITIONAL TIERS AT ONE END WITHOUT MAJOR STRUCTURAL DISASSEMBLY.
3. SURGE DIVERTERS SHALL PROVIDE FEEDBACK TO DCS VIA VOLT-FREE CONTACTS. SURGE DIVERTER FUSES SHALL BE SIZED BY VENDOR TO SUIT DUTY.
4. MINIATURE CIRCUIT BREAKERS SHALL BE SIZED AND RATED TO SUIT ACB AND INCOMER REQUIREMENTS.
5. CIRCUIT BREAKER TO BE SUBSTITUTED FOR FUSED-SWITCH WHERE REQUIRED BY EQUIPMENT MANUFACTURERS GUIDELINES.
6. EMERGENCY SHUTDOWN (E-SHUT) PUSH BUTTON N/O WIRED TO SHUNT TRIP NOMINATED CIRCUIT BREAKERS.

LEGEND

- PFR — PHASE FAILURE RELAY
- / > — EARTH LEAKAGE RELAY
- xxxA / xxxA — ST TRIP SET POINT / CB SIZE
- AFD — ARC FLASH DETECTION
- ECR — EARTH CONTINUITY RELAY
- 1 / E-SHUT — SWITCHROOM EMERGENCY SHUTDOWN

DRG No.	REFERENCES
2000-F23-SCM-EL-10204	F23-SW-023 415V MCC ARC FLASH SYSTEM SCHEMATIC DIAGRAM
2000-F23-SCM-EL-10203	F23-SW-023 415V MCC 24VDC DISTRIBUTION SCHEMATIC DIAGRAM
2000-F23-SCM-EL-10222	F23-SW-123 415V EMERGENCY MCC INCOMER SCHEMATIC DIAGRAM
2000-F23-DRG-EL-10001	F23-SR-002 415V SWITCHROOM ELECTRICAL EQUIPMENT LAYOUT
2000-F23-BLK-IC-10001	F23-SR-001 415V SWITCHROOM AND REMOTE I/O COMMUNICATIONS BLOCK DIAGRAM
2000-F23-SLD-EL-10201	F23-SW-023 415V MCC SINGLE LINE DIAGRAM SHEET 1
2000-F00-SLD-EL-10002	F00-SW-010 33kV SWITCHBOARD SINGLE LINE DIAGRAM SHEET 1 OF 5
2000-F00-STD-EL-10001	GENERAL NOTES AND STANDARD DRAWINGS INDEX

REV	DATE	DESCRIPTION	DRAW	CHECK	DESIGN	TECH APP	PROJ APP
1	19SEP25	FAT REDLINES INCORPORATED	[redacted]				
0	29AUG24	APPROVED FOR CONSTRUCTION					

NORTHERN STAR RESOURCES LIMITED

INFORMATION AND REPRESENTATIONS ON THIS DRAWING ARE THE INTELLECTUAL PROPERTY OF PRIMERO UNLESS SPECIFICALLY IDENTIFIED OTHERWISE. ALL RIGHTS INCLUDING USE RESERVED

PRIMERO
primero.com.au | DESIGN | CONSTRUCT | OPERATE

PRIMERO PROJECT NUMBER: 23517

PROJECT: NORTHERN STAR RESOURCES LTD
KCGM GROWTH PROJECT

TITLE: FINAL TAILS HANDLING AND STORAGE
F23-SW-123 415V EMERGENCY MCC
SINGLE LINE DIAGRAM SHEET 1

SHEET	SCALE	DRG No.	REVISION
A1	NONE	2000-F23-SLD-EL-10211	1

O:\CAD PROJECTS\23S NORTHERN STAR RESOURCES LTD\23517 KCGM GROWTH PROJECT\03 DELIVERABLES\ELV\F23 - FINAL TAILINGS HANDLING & STORAGE\2000-F23-SLD-EL-10211.DWG 020CT25 9:04AM HOTSEAT04