
F23-SR-001
415V FINAL TAILS SWITCHROOM

F23-SW-123
FINAL TAILS 415V EMERGENCY MOTOR CONTROL CENTRE

CONTINUED ON SHT 1
2000-F23-SLD-EL-10211

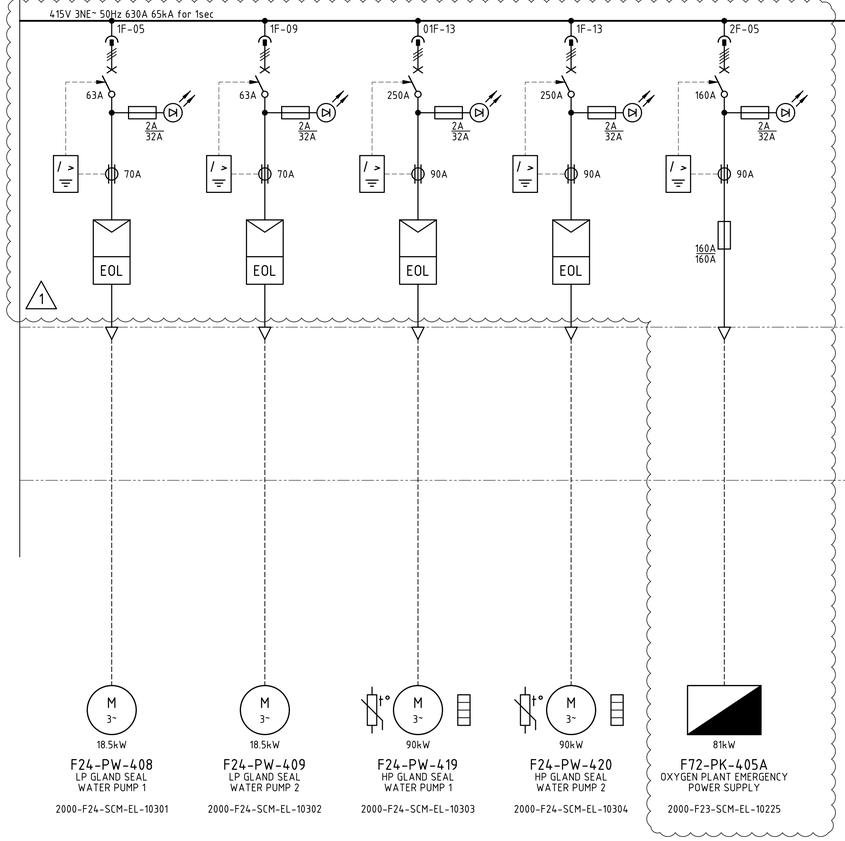

NOTES

1. REFER TO SHEET 1.

LEGEND

1. REFER TO SHEET 1.

NORTHERN STAR RESOURCES LIMITED

Approved	X
Approved as Noted	
Not Approved	
For Information Only	

Signed [redacted] Date 15/10/2025

ACCEPTANCE DOES NOT RELIEVE THE SUPPLIER / CONTRACTOR OF ITS RESPONSIBILITY OR LIABILITIES UNDER THE PURCHASE ORDER / CONTRACT

DRG No.	REFERENCES
2000-F23-SCM-EL-10204	F23-SW-023 415V MCC ARC FLASH SYSTEM SCHEMATIC DIAGRAM
2000-F23-SCM-EL-10203	F23-SW-023 415V MCC 24VDC DISTRIBUTION SCHEMATIC DIAGRAM
2000-F23-SCM-EL-10222	F23-SW-123 EMERGENCY MCC INCOMER SCHEMATIC DIAGRAM
2000-F23-DRG-EL-10001	F23-SR-002 415V SWITCHROOM ELECTRICAL EQUIPMENT LAYOUT
2000-F23-BLK-IC-10001	F23-SR-001 415V SWITCHROOM AND REMOTE I/O COMMUNICATIONS BLOCK DIAGRAM
2000-F23-SLD-EL-10201	F23-SW-023 415V MCC SINGLE LINE DIAGRAM SHEET 1
2000-F00-SLD-EL-10002	F00-SW-010 33kV SWITCHBOARD SINGLE LINE DIAGRAM SHEET 1 OF 5
2000-F00-STD-EL-10001	GENERAL NOTES AND STANDARD DRAWINGS INDEX

REV	DATE	DESCRIPTION	DRAW	CHECK	DESIGN	TECH APP	PROJ APP
1	19SEP25	FAT REDLINES INCORPORATED					
0	29AUG24	APPROVED FOR CONSTRUCTION					

NORTHERN STAR RESOURCES LIMITED

PRIMERO
primero.com.au | DESIGN | CONSTRUCT | OPERATE

PRIMERO PROJECT NUMBER: 23517

INFORMATION AND REPRESENTATIONS ON THIS DRAWING ARE THE INTELLECTUAL PROPERTY OF PRIMERO UNLESS SPECIFICALLY IDENTIFIED OTHERWISE. ALL RIGHTS INCLUDING USE RESERVED

PROJECT: NORTHERN STAR RESOURCES LTD
KCGM GROWTH PROJECT

TITLE: FINAL TAILS HANDLING AND STORAGE
F23-SW-123 415V EMERGENCY MCC
SINGLE LINE DIAGRAM SHEET 2

SHEET	SCALE	DRG No.	REVISION
A1	NONE	2000-F23-SLD-EL-10212	1

O:\CAD PROJECTS\235 NORTHERN STAR RESOURCES LTD\235171 KCGM GROWTH PROJECT\03 DELIVERABLES\EL\F23 - FINAL TAILINGS HANDLING & STORAGE\2000-F23-SLD-EL-10212.DWG 02OCT25 9:04AM HOTSEAT04