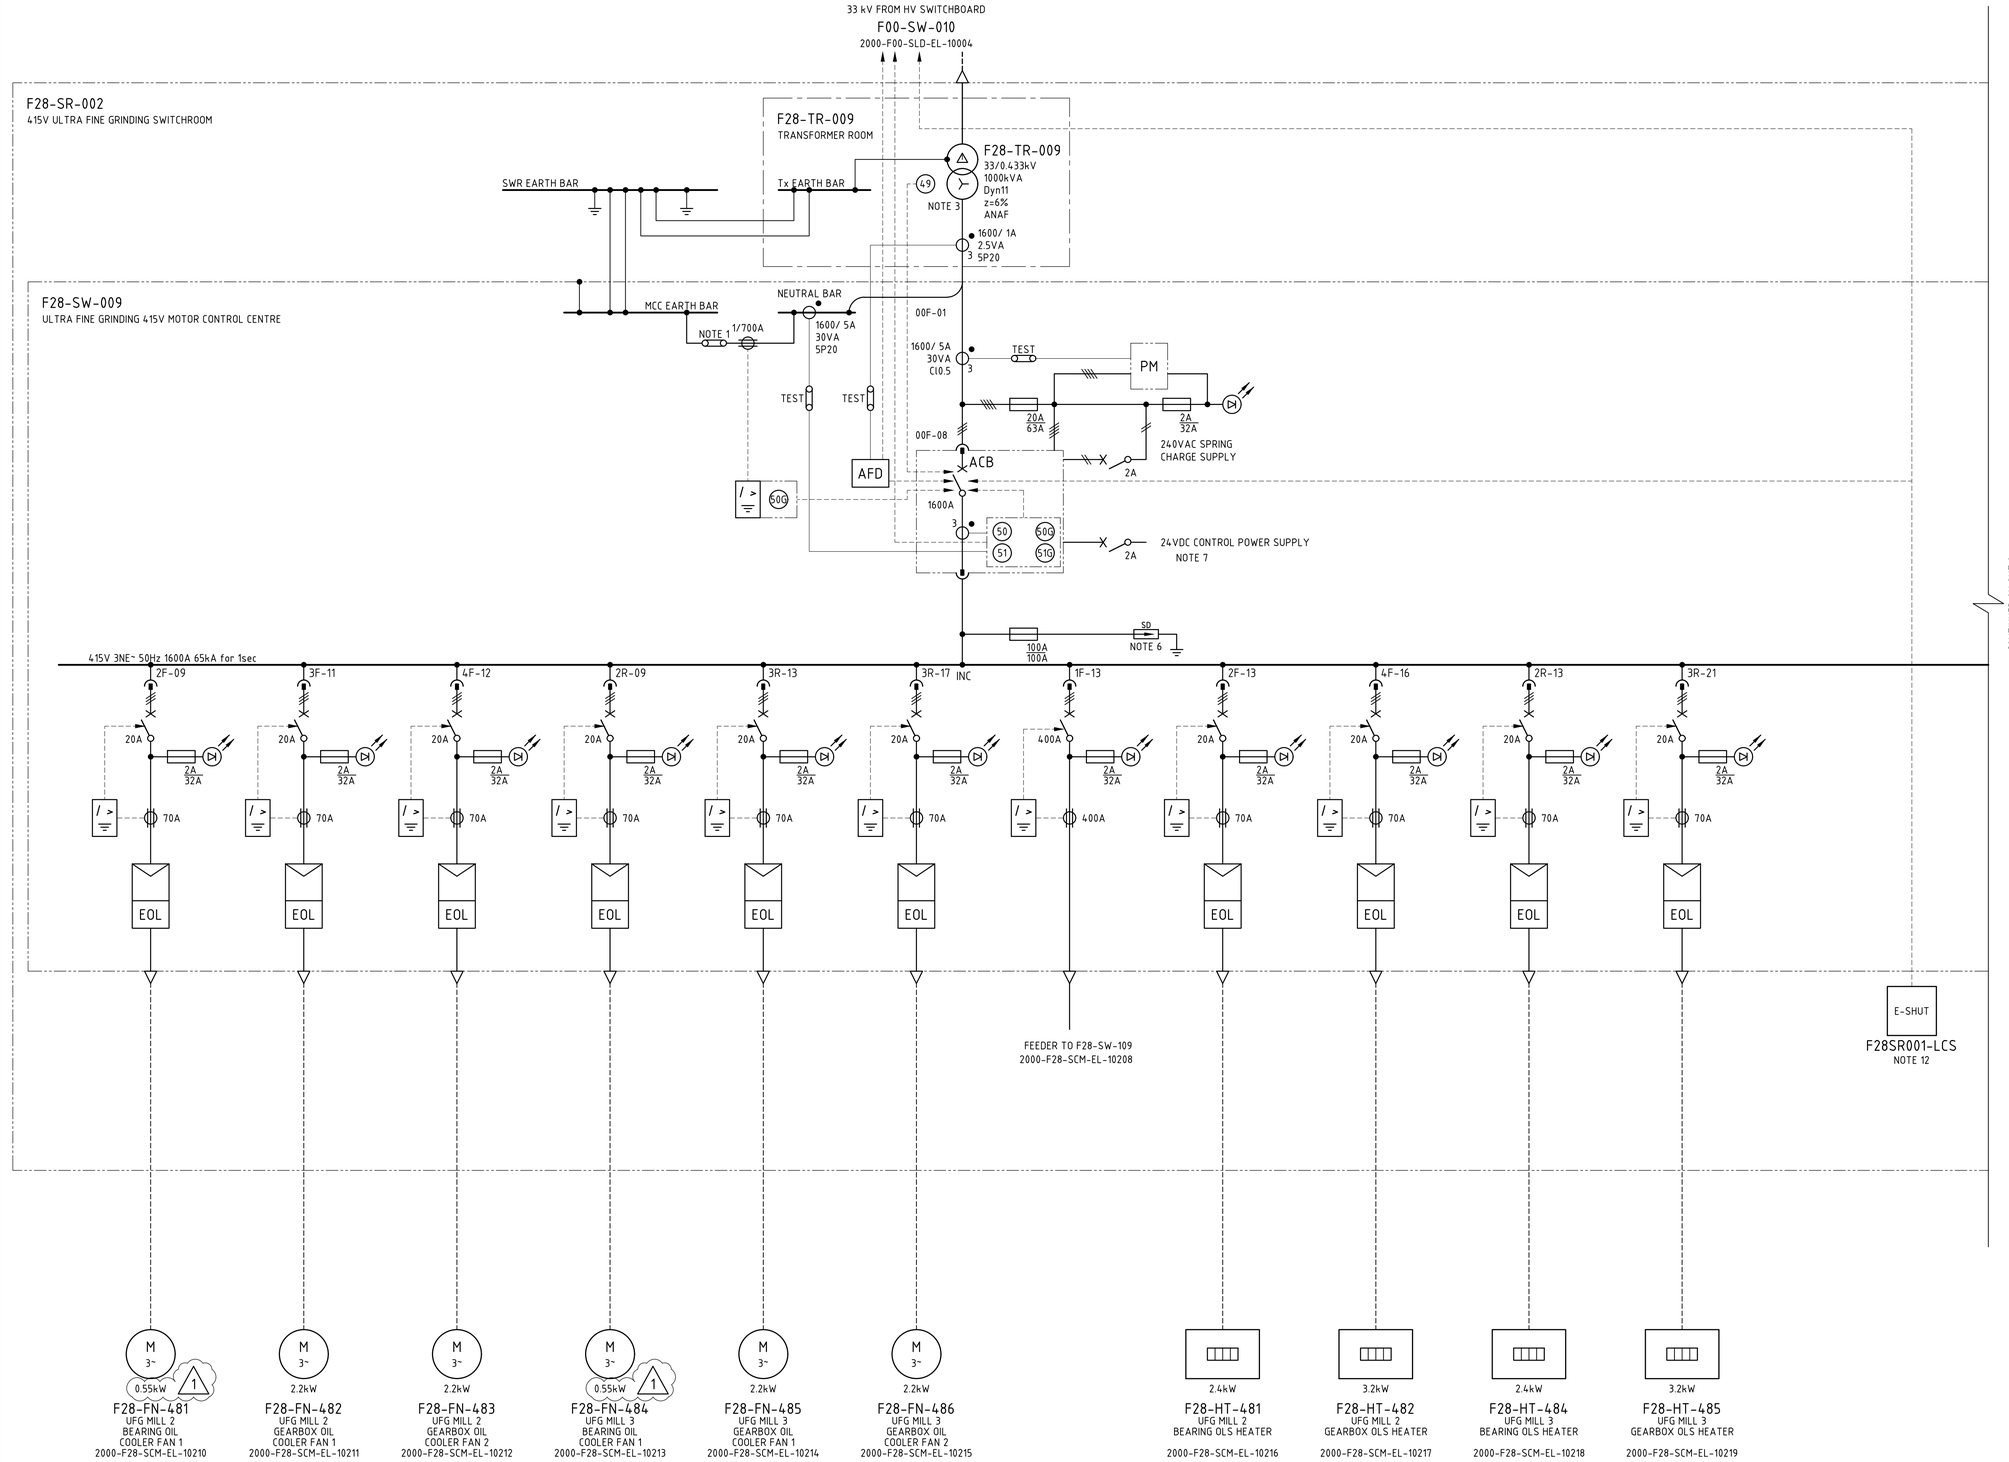


NOTES

1. EARTH-NEUTRAL LINK SHALL BE INSTALLED IN INCOMER TIER. SIGNAGE SHALL BE PLACED ON MCC AND ON TRANSFORMER READING "M.E.N. LINK LOCATED IN F28-SW-009 INCOMER TIER" CABLE SHALL BE IDENTIFIED C/W LABEL STATING "M.E.N. LINK - DO NOT REMOVE".
2. SWITCHBOARD SHALL BE EXTENSIBLE AND BE PROVIDED WITH THE FACILITY TO EXTEND THE MAIN BUSBAR AND APPEND ADDITIONAL TIERS AT ONE END WITHOUT MAJOR STRUCTURAL DISASSEMBLY.
3. UPSTREAM TRANSFORMER FEEDER SHALL BE TRIPPED ON ACTIVATION OF SWITCHROOM EMERGENCY PUSHBUTTON, DETECTION OF EARTH FAULT OR ARC FAULT DETECTION.
4. SWITCHBOARD VENDOR SHALL SELECT SWITCHGEAR TO PROVIDE TYPE-2 CO-ORDINATION SUITABLE FOR HIGH EFFICIENCY MOTORS.
5. ALL DRIVE I/O VIA COMMS NETWORK TO DCS. FOR COMMUNICATIONS BLOCK DIAGRAM REFER 2000-F28-BLK-IC-10001.
6. SURGE DIVERTERS SHALL PROVIDE FEEDBACK TO DCS VIA VOLT-FREE CONTACTS. SURGE DIVERTER FUSES SHALL BE SIZED BY VENDOR TO SUIT DUTY.
7. MINIATURE CIRCUIT BREAKERS SHALL BE SIZED AND RATED TO SUIT ACB AND INCOMER REQUIREMENTS.
8. THERMAL OVERLOAD UNITS MAY BE SUBSTITUTED WITH ELECTRONIC (MAGNETIC) OVERLOAD UNITS TO SUIT DUTY.
9. TOLs TO BE MOUNTED IN PURPOSE-BUILT ENCLOSURE BENEATH VSD. TOLs MAY BE INCLUDED IN MCC MODULE WITH ENGINEERING APPROVAL.
10. ANY DRIVE RTDs SHALL BE WIRED TO DEDICATED REMOTE I/O CARDS IN THE FIELD. RTD RELAYS MAY BE INCLUDED IN THE MCC MODULE WITH ENGINEERING APPROVAL.
11. CIRCUIT BREAKER TO BE SUBSTITUED FOR FUSED-SWITCH WHERE REQUIRED BY EQUIPMENT MANUFACTURERS GUIDELINES.
12. EMERGENCY SHUTDOWN (E-SHUT) PUSH BUTTON N/O WIRED TO SHUNT TRIP NOMINATED CIRCUIT BREAKERS.

LEGEND

- DIRECT ON-LINE MOTOR STARTER GENERIC - NOTE 4, 5
- DIRECT ON-LINE MOTOR STARTER REVERSING - NOTE 4, 5
- EOL — ELECTRONIC OVERLOAD UNIT NOTE 4, 5
- THERMAL OVERLOAD UNIT NOTE 8
- VARIABLE SPEED DRIVE NOTE 4, 5
- EARTH LEAKAGE RELAY NOTE 4, 5
- FIELD-MOUNTED DECONTACTOR
- MOTOR THERMISTOR (ONLY REQ. FOR MOTORS >37kW - 250kW)
- RTD — MOTOR RTD (ONLY REQ. FOR MOTORS >250kW)
- MOTOR HEATERS (ONLY REQ. FOR MOTORS >90kW)
- 49 63 71 — TRANSFORMER PROTECTIVE DEVICES (REFER ANSI STANDARDS FOR DESCRIPTIONS)
- CIRCUIT BREAKER (NOTE 11)
- xxxA — ST TRIP SET POINT
- xxxA — CB SIZE
- AFD — ARC FLASH DETECTION
- ECR — EARTH CONTINUITY RELAY
- E-SHUT — SWITCHROOM EMERGENCY SHUTDOWN
- 63A 3 PHASE SOCKET OUTLET

DRG No.	REFERENCES	REV	DATE	DESCRIPTION	DRAW	CHECK	DESIGN	TECH APP	PROJ APP
2000-F28-SCM-EL-10203	F28-SW-009 415V MCC ARC FLASH SYSTEM SCHEMATIC DIAGRAM								
2000-F28-SCM-EL-10202	F28-SW-009 415V MCC 24VDC DISTRIBUTION SCHEMATIC DIAGRAM								
2000-F28-SCM-EL-10201	F28-SW-009 415V MCC INCOMER SCHEMATIC DIAGRAM								
2000-F28-DRG-EL-10001	F28-SR-001 415V SWITCHROOM ELECTRICAL EQUIPMENT LAYOUT								
2000-F28-BLK-IC-10001	F28-SR-001 415V SWITCHROOM AND REMOTE I/O COMMUNICATIONS BLOCK DIAGRAM								
2000-F28-SLD-EL-10202	F28-SW-009 415V MCC SINGLE LINE DIAGRAM SHEET 2	2	02OCT26	KCGM GROWTH PROJECT - SP1 AS-BUILT					
2000-F00-SLD-EL-10002	F00-SW-010 33kV SWITCHBOARD SINGLE LINE DIAGRAM SHEET 1 OF 5	1	15SEP25	FAT REDLINES INCORPORATED					
2000-F00-STD-EL-10001	GENERAL NOTES AND STANDARD DRAWINGS INDEX	0	11JUN24	APPROVED FOR CONSTRUCTION					

NORTHERN STAR RESOURCES LIMITED

PRIMERO
primero.com.au | DESIGN | CONSTRUCT | OPERATE

PRIMERO PROJECT NUMBER: 23517

INFORMATION AND REPRESENTATIONS ON THIS DRAWING ARE THE INTELLECTUAL PROPERTY OF PRIMERO UNLESS SPECIFICALLY IDENTIFIED OTHERWISE. ALL RIGHTS INCLUDING USE RESERVED

PROJECT: NORTHERN STAR RESOURCES LTD
KCGM GROWTH PROJECT

TITLE: ULTRA FINE GRINDING 2/3
F28-SW-009 415V MCC
SINGLE LINE DIAGRAM SHEET 1

SHEET	SCALE	DRG No.	REVISION
A1	NONE	2000-F28-SLD-EL-10201	2

O:\CAD PROJECTS\235 NORTHERN STAR RESOURCES LTD\23517 KCGM GROWTH PROJECT\03 DELIVERABLES\ELI\F28 - ULTRAFINE GRINDING 2 & 3\2000-F28-SLD-EL-10201.DWG 29SEP26 7:30AM ROBIN.LAW