
F28-SR-002
415V ULTRA FINE GRINDING SWITCHROOM

F28-SW-009
ULTRA FINE GRINDING 415V MOTOR CONTROL CENTRE

CONTINUED ON SHT 1.
2000-F28-SLD-EL-10201

CONTINUED ON SHT 3
2000-F28-SLD-EL-10203

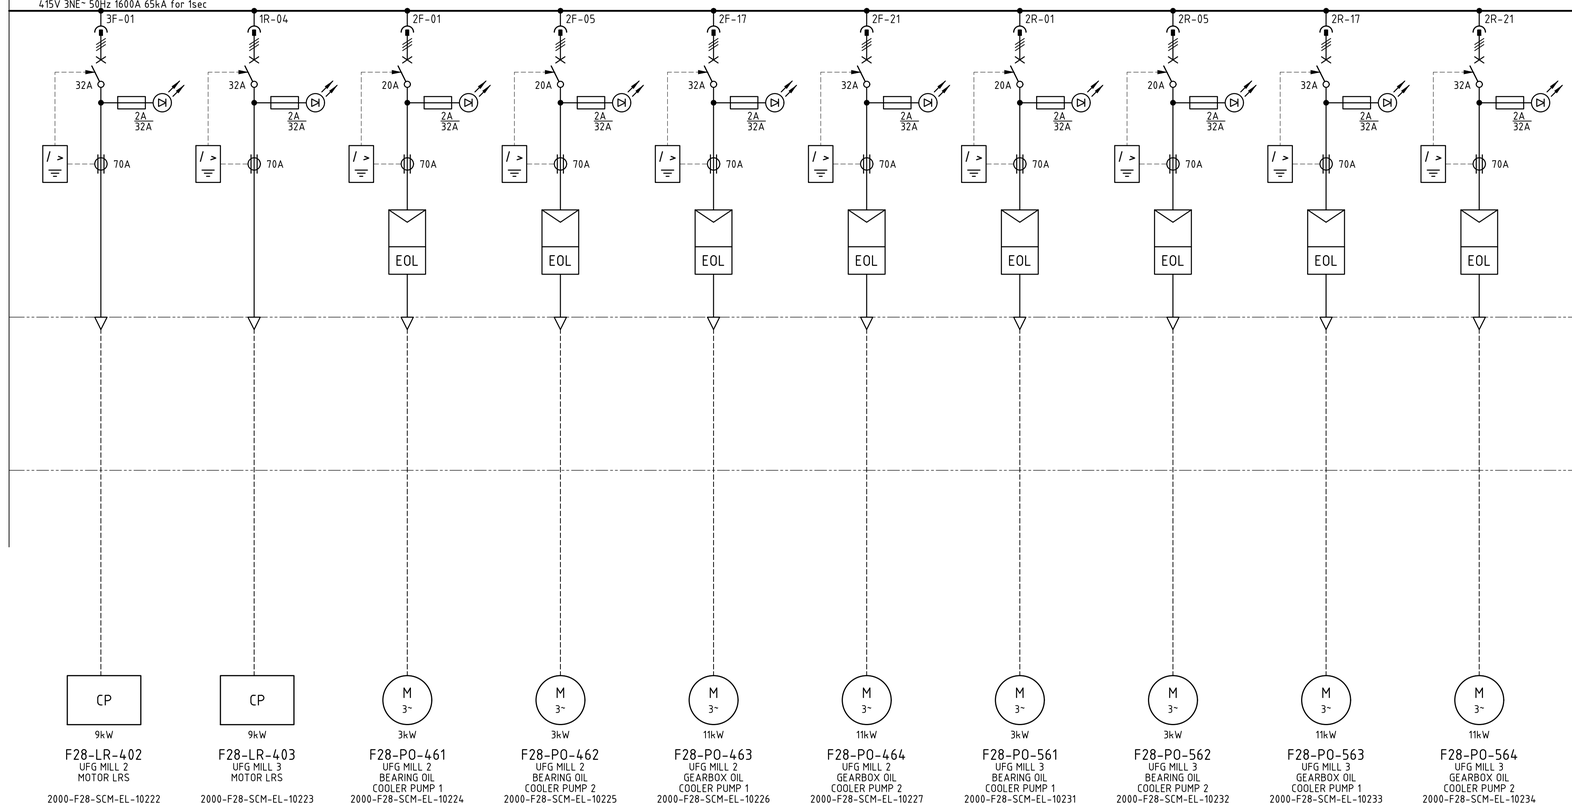

NOTES

1. REFER TO SHEET 1.

LEGEND

1. REFER TO SHEET 1.

DRG No.	REFERENCES
2000-F28-SCM-EL-10203	F28-SW-009 415V MCC ARC FLASH SYSTEM SCHEMATIC DIAGRAM
2000-F28-SCM-EL-10202	F28-SW-009 415V MCC 24VDC DISTRIBUTION SCHEMATIC DIAGRAM
2000-F28-SCM-EL-10201	F28-SW-009 415V MCC INCOMER SCHEMATIC DIAGRAM
2000-F28-DRG-EL-10001	F28-SR-001 415V SWITCHROOM ELECTRICAL EQUIPMENT LAYOUT
2000-F28-BLK-IC-10001	F28-SR-001 415V SWITCHROOM AND REMOTE I/O COMMUNICATIONS BLOCK DIAGRAM
2000-F28-SLD-EL-10201	F28-SW-009 415V MCC SINGLE LINE DIAGRAM SHEET 1
2000-F00-SLD-EL-10002	F00-SW-010 33kV SWITCHBOARD SINGLE LINE DIAGRAM SHEET 1 OF 5
2000-F00-STD-EL-10001	GENERAL NOTES AND STANDARD DRAWINGS INDEX

REV	DATE	DESCRIPTION	DRAW	CHECK	DESIGN	TECH APP	PROJ APP
2	02OCT26	KCGM GROWTH PROJECT - SP1 AS-BUILT					
1	15SEP25	FAT REDLINES INCORPORATED					
0	11JUN24	APPROVED FOR CONSTRUCTION					

NORTHERN STAR RESOURCES LIMITED

PRIMERO
primero.com.au | DESIGN | CONSTRUCT | OPERATE

PRIMERO PROJECT NUMBER: 23517

INFORMATION AND REPRESENTATIONS ON THIS DRAWING ARE THE INTELLECTUAL PROPERTY OF PRIMERO UNLESS SPECIFICALLY IDENTIFIED OTHERWISE. ALL RIGHTS INCLUDING USE RESERVED

PROJECT: NORTHERN STAR RESOURCES LTD
KCGM GROWTH PROJECT

TITLE: ULTRA FINE GRINDING 2/3
F28-SW-009 415V MCC
SINGLE LINE DIAGRAM SHEET 2

SHEET	SCALE	DRG No.	REVISION
A1	NONE	2000-F28-SLD-EL-10202	2

29SEP26 7:32AM ROBIN.LAW
O:\CAD PROJECTS\235 NORTHERN STAR RESOURCES LTD\23517 KCGM GROWTH PROJECT\03 DELIVERABLES\ELF28 - ULTRAFINE GRINDING 2 & 3\2000-F28-SLD-EL-10202.DWG