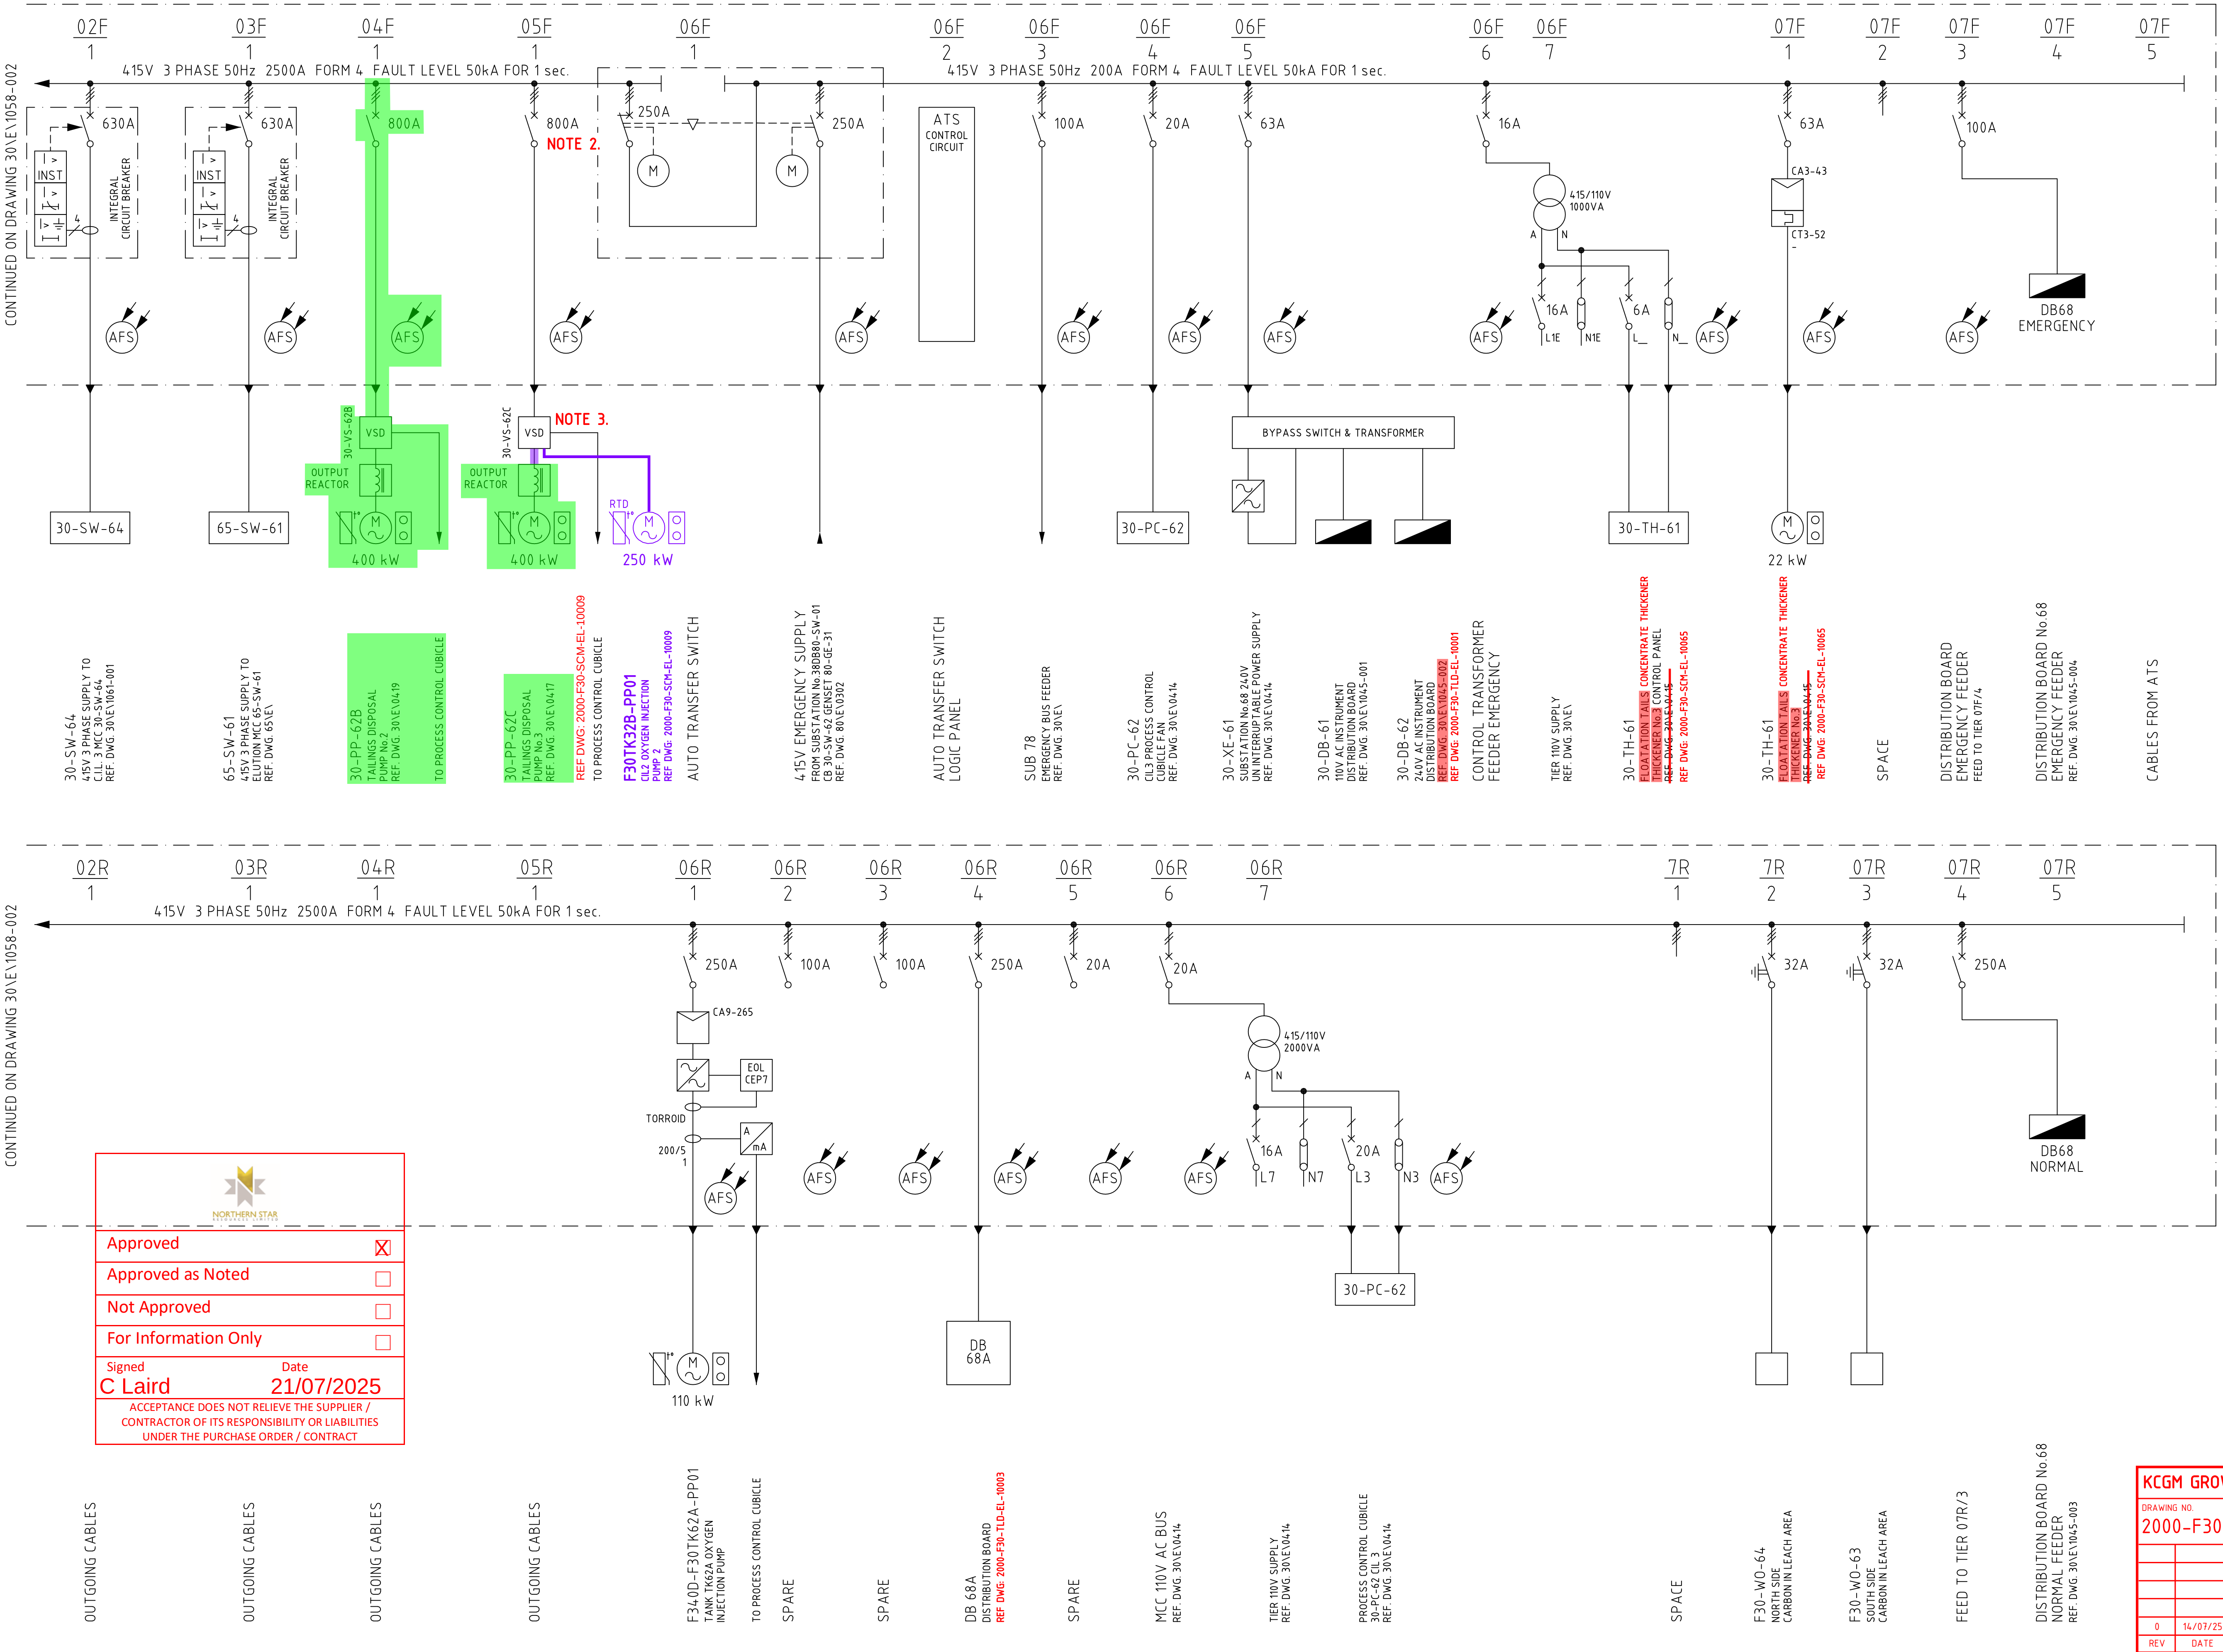
CONTINUED ON DRAWING 30\E\1058-002
02F 1
03F 1
04F 1
05F 1
06F 1
06F 2
06F 3
06F 4
06F 5
06F 6
06F 7
07F 1
07F 2
07F 3
07F 4
07F 5
415V 3 PHASE 50Hz 2500A FORM 4 FAULT LEVEL 50kA FOR 1 sec.
415V 3 PHASE 50Hz 200A FORM 4 FAULT LEVEL 50kA FOR 1 sec.
630A
INST
INTEGRAL CIRCUIT BREAKER
630A
INST
INTEGRAL CIRCUIT BREAKER
800A
800A
NOTE 2.
250A
250A
M
M
ATS CONTROL CIRCUIT
100A
20A
63A
16A
415/110V 1000VA
A
N
16A
L1E
N1E
6A
L
N
63A
CA3-43
CT3-52
100A
DB68 EMERGENCY
AFS
30-VS-62B
VSD
OUTPUT REACTOR
30-VS-62C
VSD
NOTE 3.
OUTPUT REACTOR
RTD
BYPASS SWITCH & TRANSFORMER
30-SW-64
65-SW-61
400 kW
400 kW
250 kW
30-PC-62
30-TH-61
22 kW
30-SW-64 415V 3 PHASE SUPPLY TO C.I.L. 3 MCC 30-SW-64 REF. DWG. 30\E\1061-001
65-SW-61 415V 3 PHASE SUPPLY TO ELUTION MCC 65-SW-61 REF. DWG. 65\E\
30-PP-62B TAILINGS DISPOSAL PUMP No.2 REF. DWG. 30\E\0419
TO PROCESS CONTROL CUBICLE
30-PP-62C TAILINGS DISPOSAL PUMP No.3 REF. DWG. 30\E\0417
REF DWG: 2000-F30-SCM-EL-10009
TO PROCESS CONTROL CUBICLE
F30TK32B-PP01 CIL2 OXYGEN INJECTION PUMP 2 REF DWG: 2000-F30-SCM-EL-10009
AUTO TRANSFER SWITCH
415V EMERGENCY SUPPLY FROM SUBSTATION No.38DB80-SW-01 CB 30-SW-62 GENSET 80-GE-31 REF. DWG. 80\E\0302
AUTO TRANSFER SWITCH LOGIC PANEL
SUB 78 EMERGENCY BUS FEEDER REF. DWG. 30\E\
30-PC-62 CIL3 PROCESS CONTROL CUBICLE FAN REF. DWG. 30\E\0414
30-XE-61 SUBSTATION No.68 240V UN INTERRUPTABLE POWER SUPPLY REF. DWG. 30\E\0414
30-DB-61 110V AC INSTRUMENT DISTRIBUTION BOARD REF. DWG. 30\E\1045-001
30-DB-62 240V AC INSTRUMENT DISTRIBUTION BOARD REF. DWG. 30\E\1045-002 REF DWG: 2000-F30-TLD-EL-10001
CONTROL TRANSFORMER FEEDER EMERGENCY
TIER 110V SUPPLY REF. DWG. 30\E\
30-TH-61 FLOATATION TAILS CONCENTRATE THICKENER THICKENER No.3 CONTROL PANEL ~~REF. DWG. 30\E\0415~~ REF DWG: 2000-F30-SCM-EL-10065
30-TH-61 FLOATATION TAILS CONCENTRATE THICKENER THICKENER No.3 ~~REF. DWG. 30\E\0415~~ REF DWG: 2000-F30-SCM-EL-10065
SPACE
DISTRIBUTION BOARD EMERGENCY FEEDER FEED TO TIER 07F/4
DISTRIBUTION BOARD No.68 EMERGENCY FEEDER REF. DWG. 30\E\1045-004
CABLES FROM ATS
CONTINUED ON DRAWING 30\E\1058-002
02R 1
03R 1
04R 1
05R 1
06R 1
06R 2
06R 3
06R 4
06R 5
06R 6
06R 7
7R 1
7R 2
07R 3
07R 4
07R 5
415V 3 PHASE 50Hz 2500A FORM 4 FAULT LEVEL 50kA FOR 1 sec.
250A
100A
100A
250A
20A
20A
32A
32A
250A
CA9-265
EOL CEP7
TORROID
200/5 1
A mA
415/110V 2000VA
A
N
16A
L7
N7
20A
L3
N3
DB68 NORMAL
DB 68A
30-PC-62
110 kW
OUTGOING CABLES
OUTGOING CABLES
OUTGOING CABLES
OUTGOING CABLES
F340D-F30TK62A-PP01 TANK TK62A OXYGEN INJECTION PUMP
TO PROCESS CONTROL CUBICLE
SPARE
SPARE
DB 68A DISTRIBUTION BOARD REF DWG: 2000-F30-TLD-EL-10003
SPARE
MCC 110V AC BUS REF. DWG. 30\E\0414
TIER 110V SUPPLY REF. DWG. 30\E\0414
PROCESS CONTROL CUBICLE 30-PC-62 CIL 3 REF. DWG. 30\E\0414
SPACE
F30-WO-64 NORTH SIDE CARBON IN LEACH AREA
F30-WO-63 SOUTH SIDE CARBON IN LEACH AREA
FEED TO TIER 07R/3
DISTRIBUTION BOARD No.68 NORMAL FEEDER REF. DWG. 30\E\1045-003

NORTHERN STAR

Approved	☒
Approved as Noted	☐
Not Approved	☐
For Information Only	☐

Signed
C Laird

Date
21/07/2025

ACCEPTANCE DOES NOT RELIEVE THE SUPPLIER / CONTRACTOR OF ITS RESPONSIBILITY OR LIABILITIES UNDER THE PURCHASE ORDER / CONTRACT

LEGEND

LOCATION

SUB STATION 68

30-SW-62

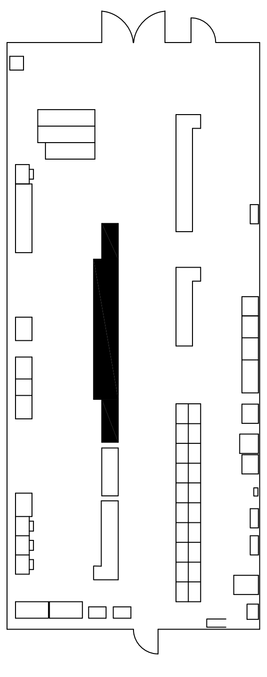

NOTES

1. ALL AFS (ARC FLASH SENSORS) ARE CONNECTED TO THE ARC FLASH RELAY VIA I/O UNITS
2. MCC FEEDER RE-PURPOSED AS PART OF THE KCGM GROWTH PROJECT.
3. VSD RE-PURPOSED AS PART OF THE KCGM GROWTH PROJECT.

LEGEND

- — STAGE 1 - NEW
- 🟥 STAGE 1 - REMOVE
- 🟨 STAGE 1 - DECOMMISSIONED (OTHERS)
- — STAGE 2 - NEW
- 🟪 STAGE 2 - REMOVE
- 🟩 STAGE 2 - DECOMMISSIONED (OTHERS)

KCGM GROWTH PROJECT

DRAWING NO.
2000-F30-SLD-EL-10102

REV	DATE	DESCRIPTION	CHECK	TECH APP
			RF	[redacted]
0	14/07/25	APPROVED FOR CONSTRUCTION	[redacted]	M

MK	DATE	REVISION	BY	CKD	APP	MK	DATE	REVISION	BY	CKD	APP
						5	11/03/22	AS BUILT	[redacted]	GB	[redacted]
						4	12/03/21	ISSUED FOR CONSTRUCTION - OXYGEN INJECTION PROJECT	[redacted]	CV	[redacted]
						3	16/09/20	2019 S.L.D. UPDATE PROJECT "AS BUILT"	[redacted]	RA	[redacted]
						2A	23/08/19	2019 S.L.D. UPDATE PROJECT "AS BUILT"- FIELD REVIEW	[redacted]	RH	[redacted]
						1	20/03/18	EQUIPMENT ON DRAWING REPOSITIONED & ARC FLASH PROTECTION INSTALLED	[redacted]	JMR	[redacted]

REFERENCE DRAWINGS	DWG NO.

SCALE	NTS	
DRAWN	[redacted]	20/03/18
DESIGNED		
CHECKED		
APPROVED		
PROJ.APP		
PROJ. FILE #.		

FIMISTON PLANT
CARBON IN LEACH (C.I.L. 3)
SUBSTATION No.68 MCC 30-SW-62
SINGLE LINE DIAGRAM

SIZE	DRAWING NUMBER	REV
A1	30\E\1058-003	5

KALGOORLIE CONSOLIDATED GOLD MINES PTY. LTD. ABN 009 377 619 003