
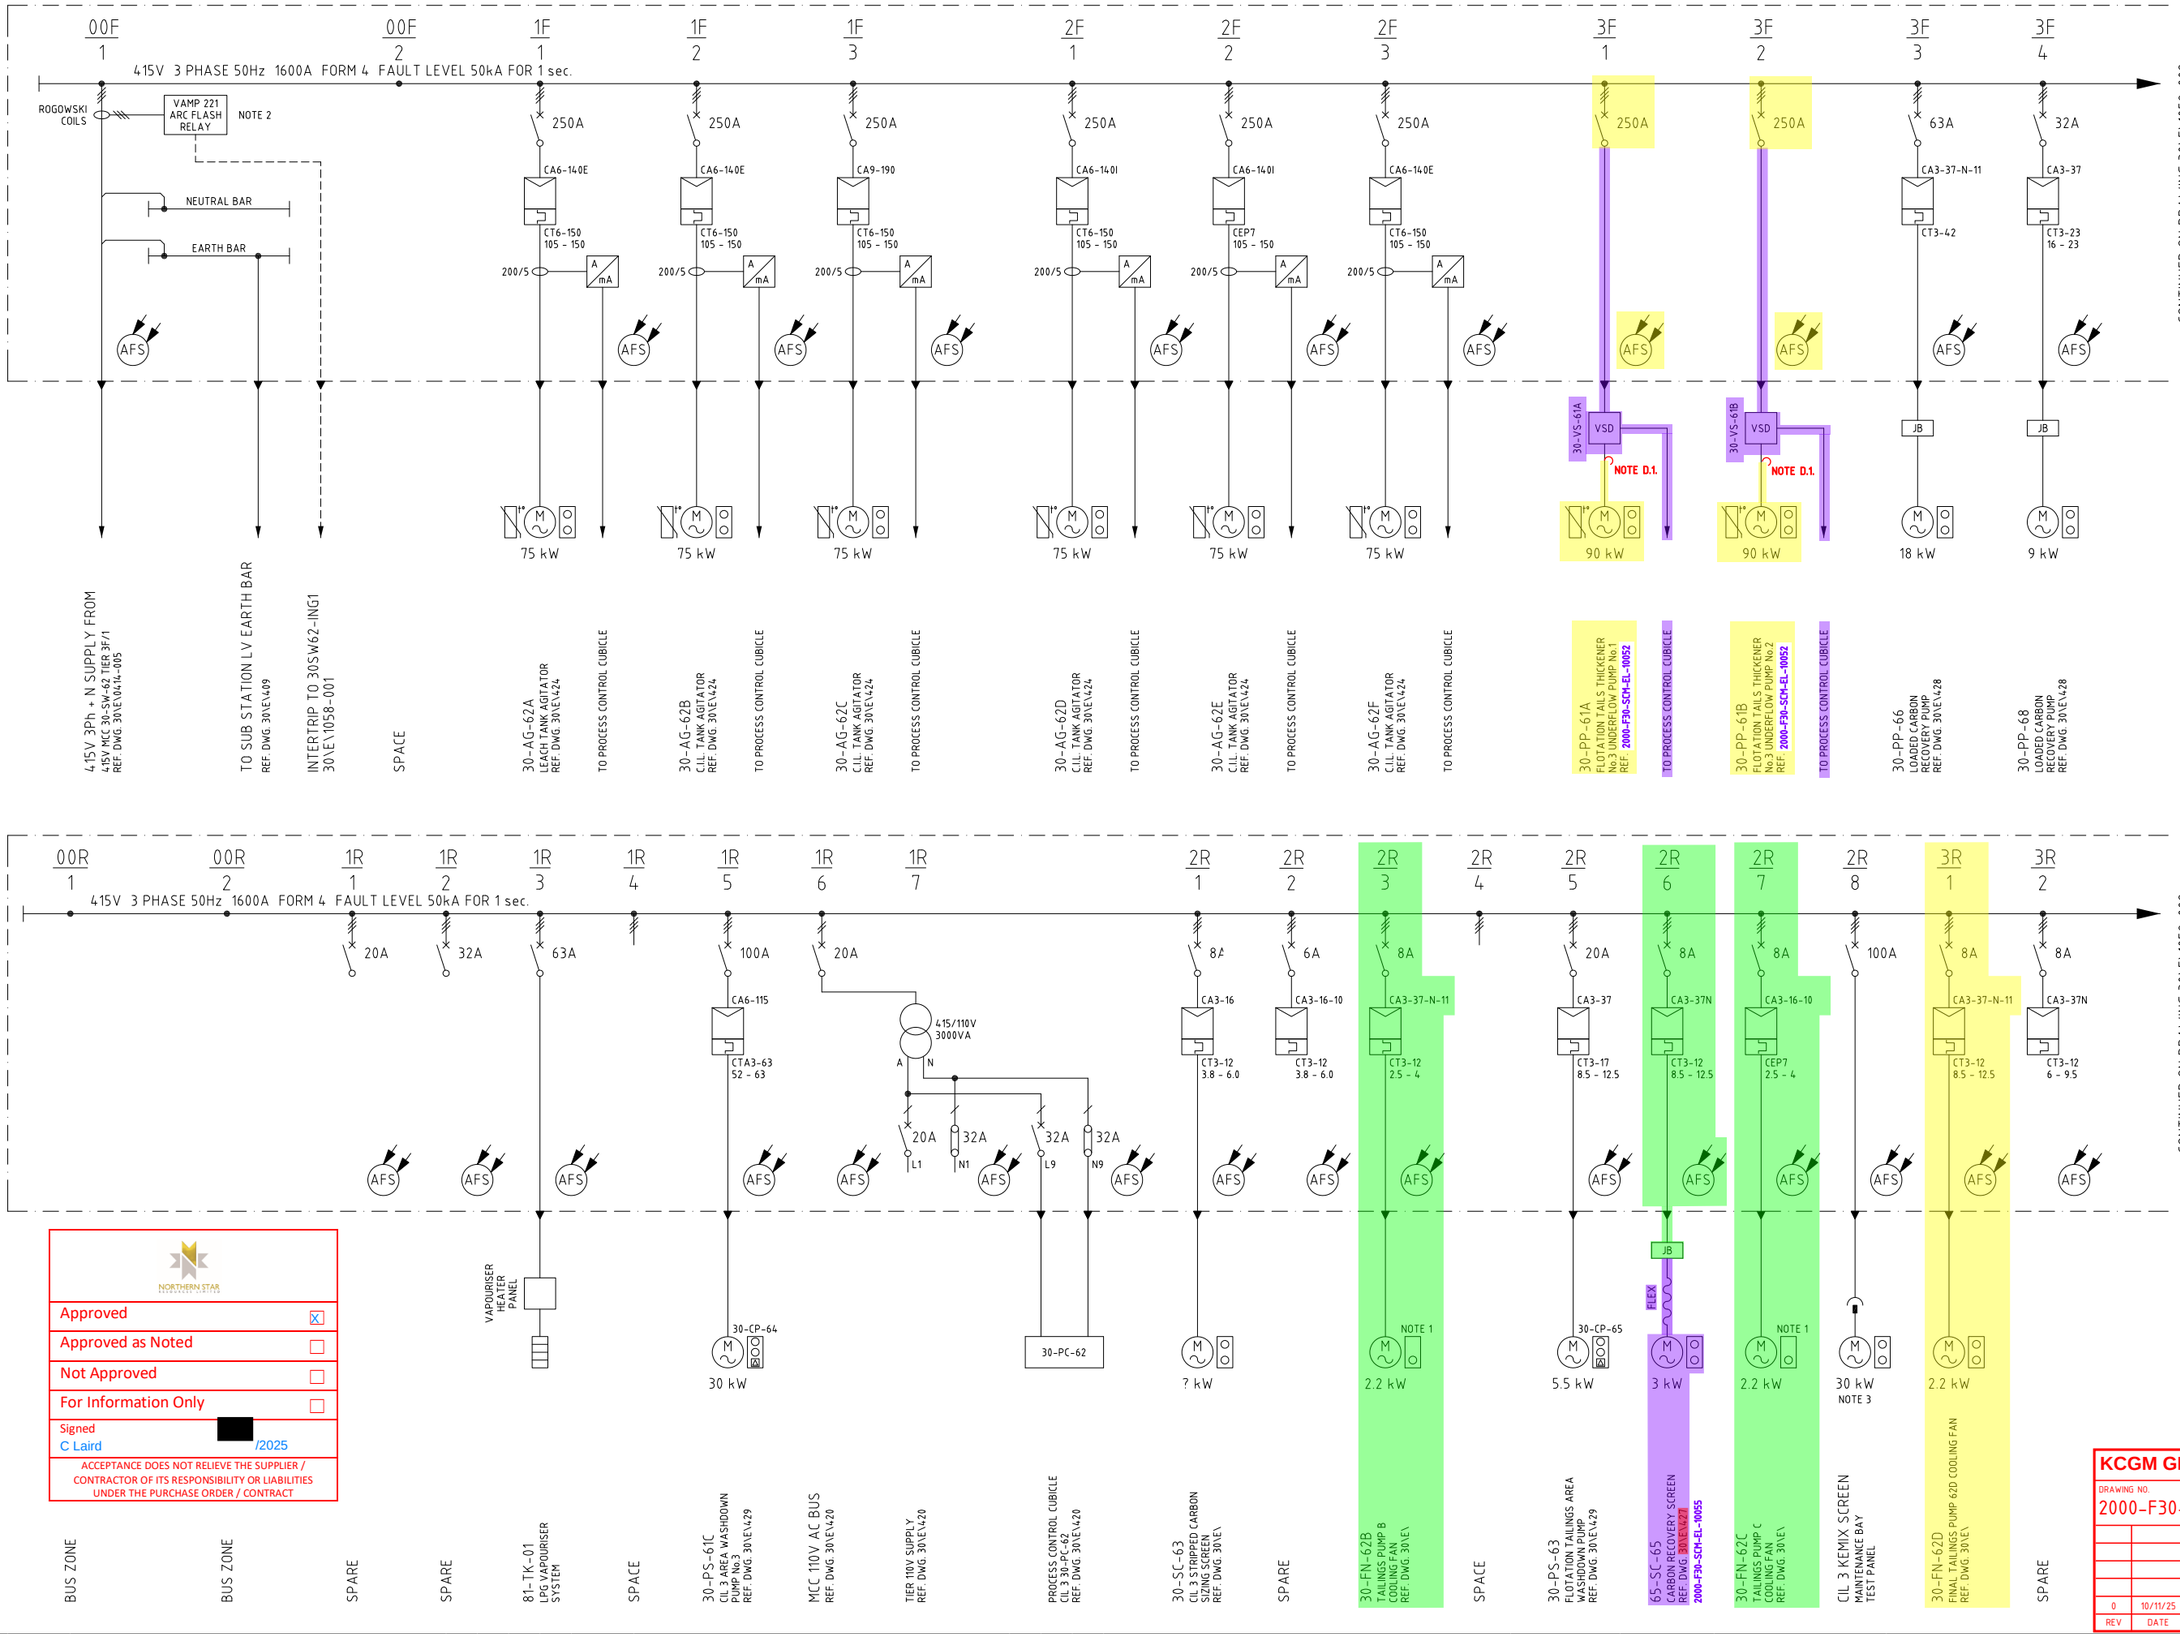


LEGEND

LEGEND
- EXISTING
- NON-EXISTENT
- STAGE 1 - NEW
- STAGE 1 - REMOVE
- STAGE 1 - DECOMMISSIONED (OTHERS)
- STAGE 2 - NEW
- STAGE 2 - REMOVE
- STAGE 2 - DECOMMISSIONED (OTHERS)

LOCATION

SUB STATION 68
30-SW-63

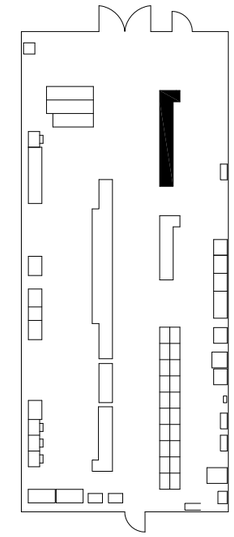

NOTES

1. 30-FN-62B & 62C START/STOP IS INTERLOCKED WITH TAILINGS PUMPS 30-PP-62B & C RESPECTIVELY
2. ALL AFS (ARC FLASH SENSORS) ARE CONNECTED TO THE ARC FLASH RELAY VIA I/O UNITS
3. 30-SC-62B,C,D,E,F ROTATE THROUGH WHEN MAINTENANCE REQUIRED

NORTHERN STAR RESOURCES LIMITED

Approved	X
Approved as Noted	
Not Approved	
For Information Only	

Signed [redacted]
C Laird /2025

ACCEPTANCE DOES NOT RELIEVE THE SUPPLIER / CONTRACTOR OF ITS RESPONSIBILITY OR LIABILITIES UNDER THE PURCHASE ORDER / CONTRACT

KCGM GROWTH PROJECT DEMOLITION NOTES

D.1. VSD OUTGOING FIELD CABLES CABLES TO BE DISCONNECTED AND MADE SAFE AT BOTH ENDS.

KCGM GROWTH PROJECT

DRAWING NO.
2000-F30-SLD-EL-10103

REV	DATE	DESCRIPTION	CHECK	TECH APP
0	10/11/25	APPROVED FOR CONSTRUCTION	[redacted]	DM

MK	DATE	REVISION	BY	CKD	APP
10	22/10/14	SCOPE REVISION. NO CHANGE FROM REV 7.	DR	PI	JM
9	03/04/14	ADDED CONSTRUCTION NOTES AND BATTERY LIMITS	[redacted]	BW	WJ/JM
8	14/02/14	APPROVED FOR CONSTRUCTION	[redacted]	PI/KE	WJ/TB
8B	26/11/13	APPROVED FOR TENDER PURPOSES ONLY	[redacted]		WJ/TB
8A	15/10/13	ADDED INCOMER	[redacted]		WJ/TB
7	01/12/06	GENERAL REVISION	[redacted]		
6	03/07/06	UPDATE JULY 2006	BJ		
5	16/08/04	LEACH, ADSORPTION & THICKENING TAILINGS SAMPLING PROJECT ADDED	[redacted]	SM	
4	11/06/99	30-FN-62B & 62C INTERLOCK TO 30-PP-62B & 62C	CV	RB	[redacted]
13	14/09/20	2019 S.L.D. UPDATE PROJECT "AS BUILT"	[redacted]	CS	
12A	23/08/19	2019 S.L.D. UPDATE PROJECT "AS BUILT"- FIELD REVIEW		RH	
11	21/03/18	ARC FLASH PROTECTION INSTALLED	[redacted]	JMR	

REFERENCE DRAWINGS

DWG NO.

SCALE	NTS	
DRAWN	[redacted]	09/07/97
DESIGNED		09/07/97
CHECKED		09/07/97
APPROVED		09/07/97
PROJ.APP	ABRADY	09/07/97
PROJ. FILE #.		

FIMISTON PLANT
CARBON IN LEACH (C.I.L. 3)
SUBSTATION No.68 MCC 30-SW-63
SINGLE LINE DIAGRAM

SIZE	DRAWING NUMBER	REV
A1	30\E\1059-001	13

KALGOORLIE CONSOLIDATED GOLD MINES PTY. LTD. ABN 009 377 619 003