
SUBSTATION No. 68
CARBON IN LEACH (C.I.L. 3)

F30-SW-401
CIL 3 415V MOTOR CONTROL CENTRE

CONTINUED ON SHT 1.
2000-F30-SLD-EL-10301

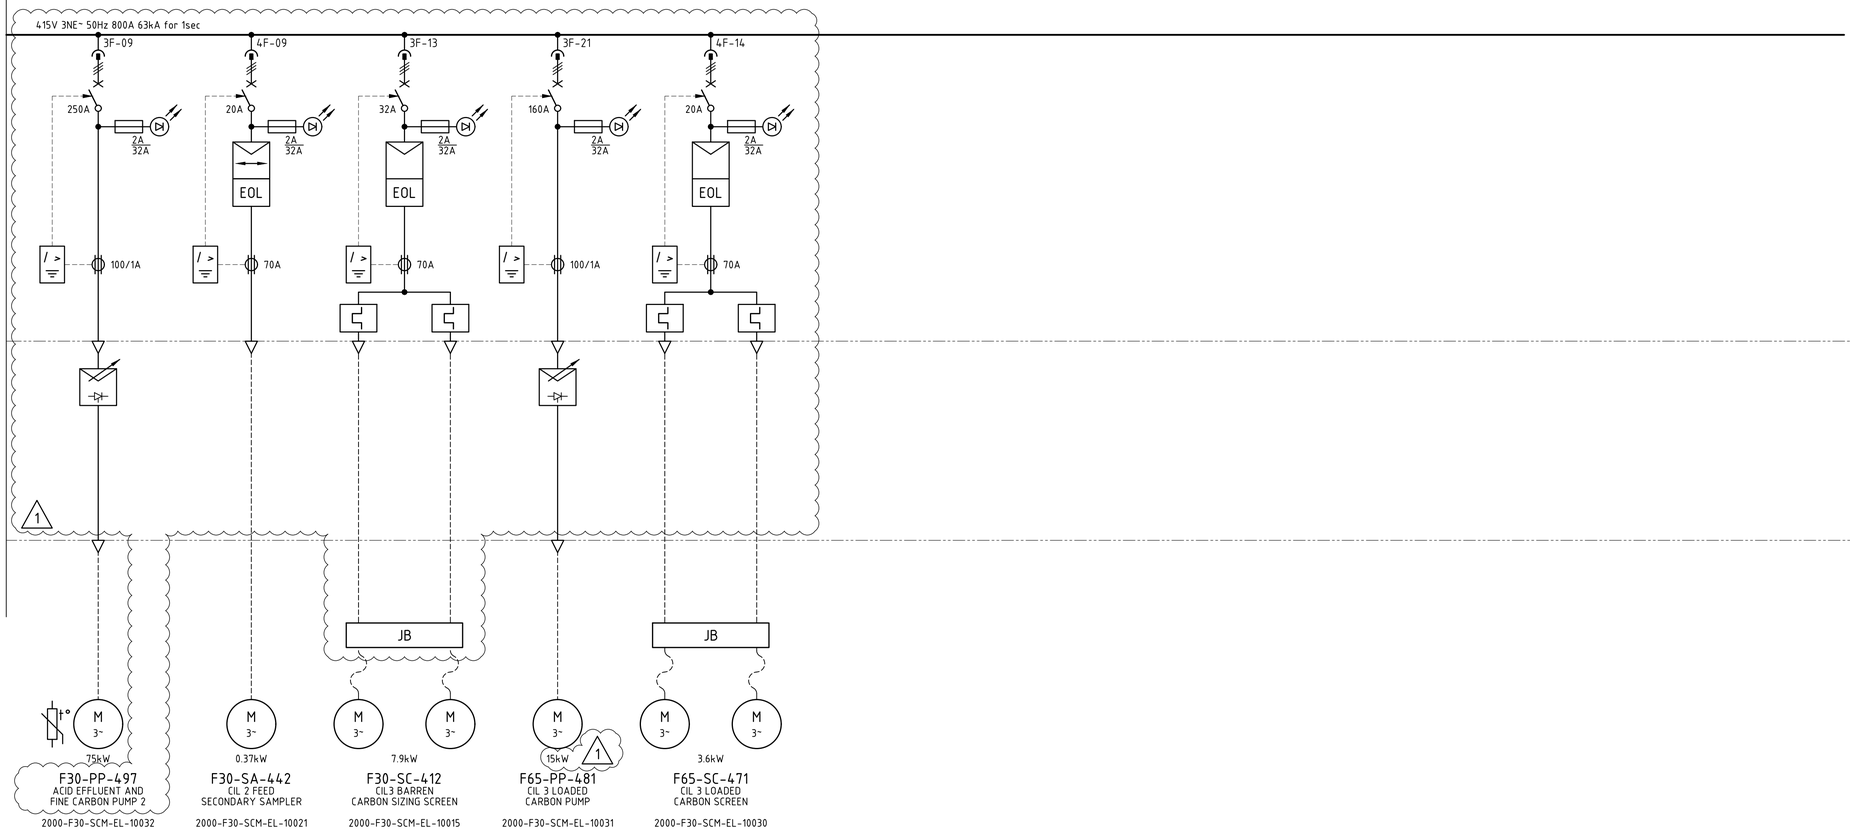

NOTES

1. REFER TO SHEET 1.

LEGEND

1. REFER TO SHEET 1.

Approved ☒
Approved as Noted ☐
Not Approved ☐
For Information Only ☐
Signed [redacted] Date 05/12/2025
ACCEPTANCE DOES NOT RELIEVE THE SUPPLIER / CONTRACTOR OF ITS RESPONSIBILITY OR LIABILITIES UNDER THE PURCHASE ORDER / CONTRACT

DRG No.	REFERENCES
2000-F30-SLD-EL-10301	SUBSTATION NO. 68 MCC F30-SW-401 SINGLE LINE DIAGRAM SHEET 1
2000-F30-DRG-EL-10001	SUBSTATION NO. 68 MCC AND GENERAL EQUIPMENT LAYOUT
2000-F00-STD-EL-10001	GENERAL NOTES AND STANDARD DRAWINGS INDEX

REV	DATE	DESCRIPTION	DRAW	CHECK	DESIGN	TECH APP	PROJ APP
1	28OCT25	FAT REDLINES INCORPORATED					
0	17MAR25	APPROVED FOR CONSTRUCTION					

NORTHERN STAR RESOURCES LIMITED

INFORMATION AND REPRESENTATIONS ON THIS DRAWING ARE THE INTELLECTUAL PROPERTY OF PRIMERO UNLESS SPECIFICALLY IDENTIFIED OTHERWISE. ALL RIGHTS INCLUDING USE RESERVED

PRIMERO
primero.com.au | DESIGN | CONSTRUCT | OPERATE

PRIMERO PROJECT NUMBER: 23517

PROJECT: NORTHERN STAR RESOURCES LTD
KCGM GROWTH PROJECT

TITLE: FIMISTON PLANT - CARBON IN LEACH (CIL 3)
SUBSTATION NO. 68 MCC F30-SW-401
SINGLE LINE DIAGRAM SHEET 2

SHEET	SCALE	DRG No.	REVISION
A1	NONE	2000-F30-SLD-EL-10302	1

O:\CAD PROJECTS\235 NORTHERN STAR RESOURCES LTD\23517 KCGM GROWTH PROJECT\03 DELIVERABLES\EL\F30 - CIL2_3 & CONCENTRATE THICKENING\2000-F30-SLD-EL-10302.DWG 19NOV25 11:45AM HOTSEAT04