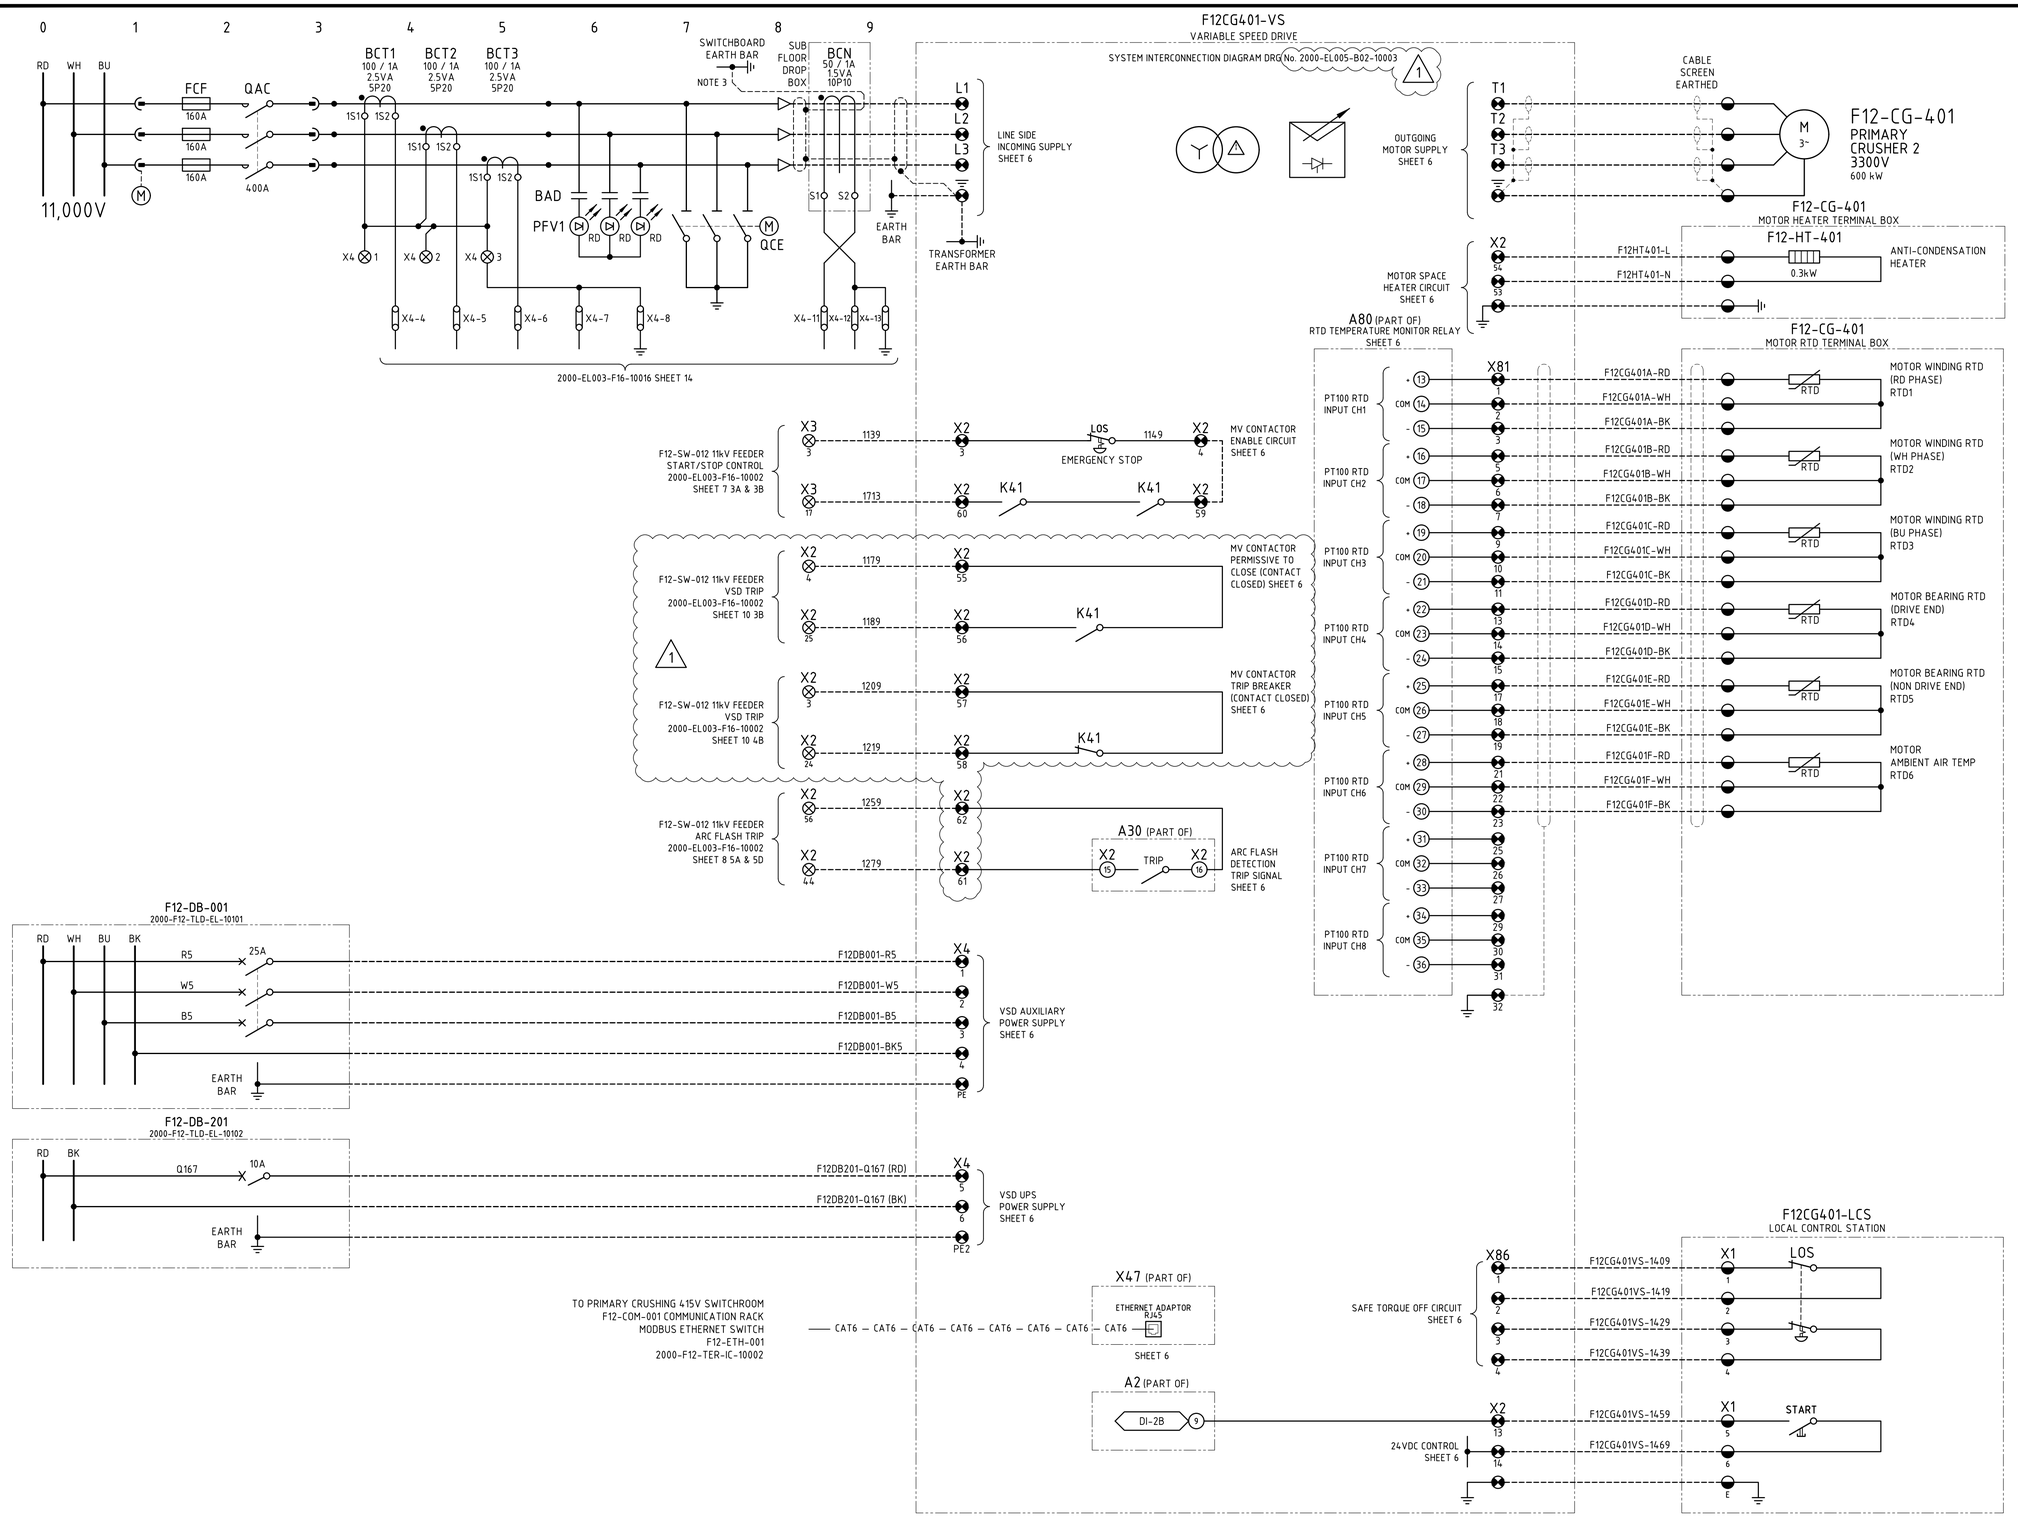


NOTES

1. WIRE NUMBER FERRULES ON TERMINAL STRIP SHALL BE PREFIXED WITH EQUIPMENT NUMBER e.g. F12CG401-1200, UNLESS OTHERWISE NOTED.
2. EACH WIRE SHALL BE IDENTIFIED AT BOTH ENDS WITH FERRULES.
3. IF THE CABLE SCREENS PASS THROUGH CORE BALANCE CT BEFORE BREAKING OUT THEN THE SCREEN EARTHS MUST BE BOUGHT BACK THROUGH THE CORE BALANCE CT AND TERMINATED TO EARTH.

LEGEND

- 11kV SWITCHBOARD TERMINAL
- VSD TERMINAL
- FIELD TERMINAL
- DCS OR I/O TERMINAL
- MARSHALLING TERMINAL
- DEVICE TERMINAL

PANEL A03

DRG No.	REFERENCES
2000-EL003-F16-10002	F12-SW-012 ABB SCHEMATIC DIAGRAM
2000-F12-TER-EL-10105	F12-SW-012 11kV SWITCHBOARD - PANEL A03 TERMINATION DIAGRAM SHEET 1
2000-F12-SLD-EL-10001	F12-SW-012 11kV SWITCHBOARD SINGLE LINE DIAGRAM
2000-F00-STD-EL-10001	GENERAL NOTES AND STANDARD DRAWINGS INDEX

REV	DATE	DESCRIPTION	DRAW	CHECK	DESIGN	TECH APP	PROJ APP
1	18JUL25	FAT REDLINES INCORPORATED				MB	
0	10MAR25	APPROVED FOR CONSTRUCTION					

NORTHERN STAR RESOURCES LIMITED

PRIMERO
primero.com.au | DESIGN | CONSTRUCT | OPERATE

PRIMERO PROJECT NUMBER: 23517

INFORMATION AND REPRESENTATIONS ON THIS DRAWING ARE THE INTELLECTUAL PROPERTY OF PRIMERO UNLESS SPECIFICALLY IDENTIFIED OTHERWISE. ALL RIGHTS INCLUDING USE RESERVED

PROJECT: NORTHERN STAR RESOURCES LTD
KCGM GROWTH PROJECT

TITLE: PRIMARY CRUSHING - F12-SW-012
F12-CG-401 PRIMARY CRUSHER 2 VSD FEEDER
SCHEMATIC DIAGRAM

SHEET	SCALE	DRG No.	REVISION
A1	NONE	2000-F12-SCM-EL-10105	1

O:\CAD PROJECTS\235 NORTHERN STAR RESOURCES LTD\23517 KCGM GROWTH PROJECT\03 DELIVERABLES\ELV\F12 - PRIMARY CRUSHING\2000-F12-SCM-EL-10105.DWG 13AUG25 11:13AM HOTSEAT04